4679398652

IREDELL COUNTY HEALTH DEPARTMENT

STATESVILLE 704-878-5305 MOORESVILLE 704-664-5281

IMPROVEMENT PERMIT / CERTIFICATE OF COMPLETION / OPERATION PERMIT / EXISTING SYSTEM INSPECTION

PROPERTY DESCRIPTION NO. 19499 DATE 10/18/94 TAX MAP NO. 4H-2A-10 Watershed: ☐ Yes ☒ No

OWNER OR CONTRACTOR Rodney L. Tavernier PHONE: Business _____ Home None

ADDRESS Confederate Rd Mooresville

LOCATION Confederate Rd. - Triplett Rd TR Confederate Rd. ± .7 mile on (R)

SUBDIVISION Twin Oaks BLOCK / SECTION _____ LOT 10. LOT AREA ± 3.92 SITE CLASS. P DESIGN FLOW 360 L.T.A.R. .3

Septic Tank: 1000 Gallons; STB ~~10/12/94~~ 994 Date 10/11/94

Pump Tank: _____ Gallons; PT _____ Date _____

Pump Make: _____ Model _____ Serial No. _____

Nitrification Field: No Fields 1 Square Feet 1200 Linear Feet 400

No Lines 3 Trench Width 36" Max Trench Bottom Depth 32" Gravel Depth _____

☒ New System ☐ Repair System Type: I (II) III, IV, V, VI

System Description: Conv. - Dist. Box

Repair System Description: _____

Maintenance Agreement Required: ☐ Yes ☐ No

☒ House/Mod. Home No. Bedrooms 3

☐ Mobile Home No. Bathrooms 4

☐ Business No. Employees _____

☐ Other _____


☐ Slab ☐ Crawl Space ☒ Basement w/plumbing ☐ Basement wo/plumbing

Water Supply: ☒ Individual ☐ Community ☐ Public


Comments:

Comments:

INITIAL SITE SKETCH

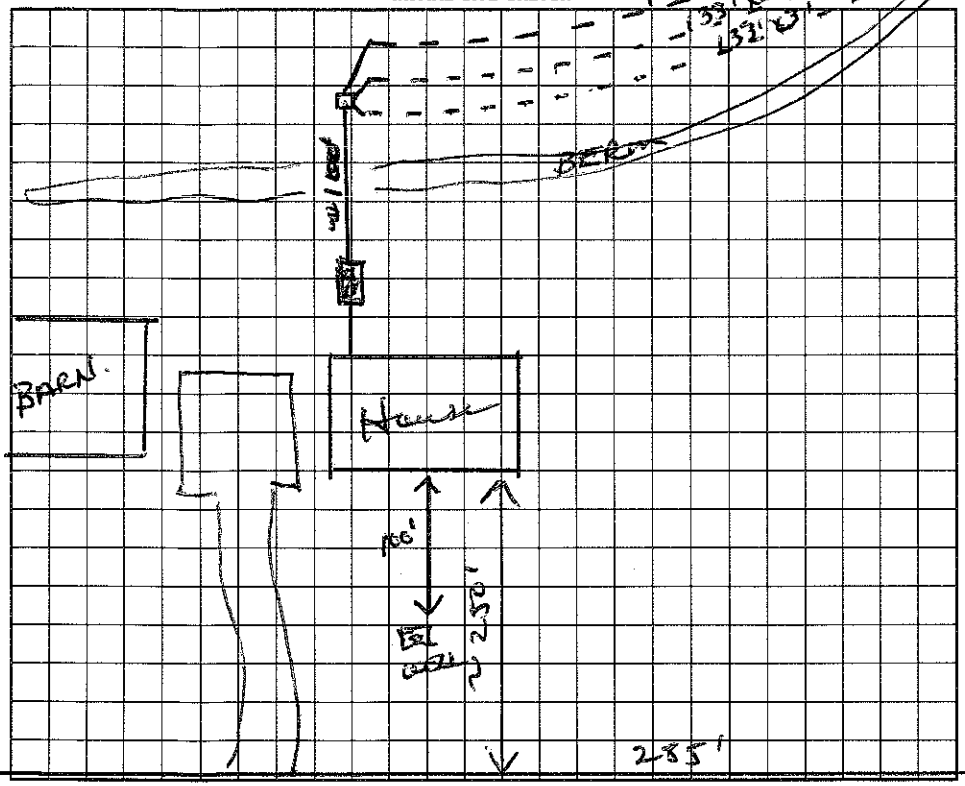

AS BUILT SKETCH

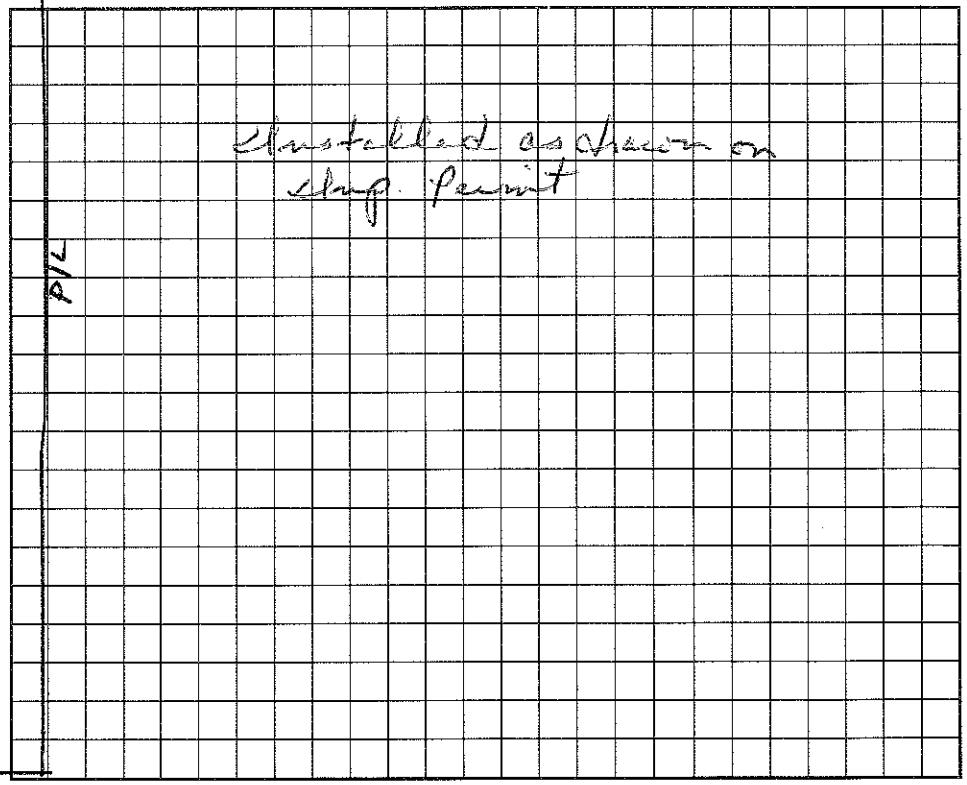

I understand that this permit can be suspended or revoked if any false information is supplied toward securing the permit/any unauthorized changes are made to the site/any unauthorized changes are made in the installation of the system. Improvement Permit is valid for 60 months from date of issuance. CONFEDERATE RD.

Signed: x Rodney L. Tavernier

Improvement Permit by: Wesley Sparks R.S. date 10/18/94

Existing System Inspection by: _____ date _____

Installed by: Larry Beam

Certificate of Completion by: Wesley Sparks R.S. date 12/7/94

Operation Permit by: _____ date _____

HEALTH DEPT. COPY: WHITE INSPECTION COPY (FINAL): GREEN OWNER COPY (FINAL): YELLOW INSPECTION COPY (INITIAL): PINK OWNER COPY (INITIAL): GOLD