IREDELL COUNTY HEALTH DEPARTMENT - *ENVIRONMENTAL HEALTH* ☐ STATESVILLE OFFICE 704-878-5305 ☒ MOORESVILLE OFFICE 704-664-5281

IMPROVEMENT PERMIT / AUTHORIZATION TO CONSTRUCT / OPERATION PERMIT / EXISTING SYSTEM INSPECTION

PERMIT # 14094Z PIN # 4679-41-1443 DATE 1-25-12 #330.00 01-31-12 MS

OWNER MIKE & PAULA DIETRICH APPLICANT: L.E. BEAM CON. & GRADING PHONE: Home/Cell # 704-634-5248 Business #

SITE ADDRESS 161 SAVANNAH CROSSING DR. OWNER / APPLICANT ADDRESS 2740 SLOOP RD

SITE DIRECTIONS WIGGINS, SAVANNAH CROSSING, ON L

SUBDIVISION KERRI PLANTATION BLOCK / SECTION LOT # 5 LOT AREA 1.02AC DESIGN FLOW 480 GPD L.T.A.R. .3

Septic Tank 1000 Gallons: STB 794 Date 3-27-12

Pump Tank Gallons: P T Date

Pump Make Model Serial #

No. Nitrification Fields: 1 No. Lines 3 Linear Feet 400'

Trench Width 36" Max. Trench Bottom Depth 36" Gravel Depth

☒ New System ☐ Repair ☐ Expansion System Type I II (III) IV V VI

System Description: 25% REDUCTION

Repair System Description: PM - 25%

Maintenance Agreement Required ☐ YES ☒ NO

☒ GRAVITY ☐ PRESSURE

☒ Residence No. Bedrooms 4

☐ Business No. Persons

☐ Other No. Employees


☐ Slab ☒ Crawl Space

☐ Basement w/plumbing ☐ Basement w/o plumbing


Water Supply: ☒ Private ☐ Public ☐ Community

Comments / Conditions

INITIAL SITE SKETCH

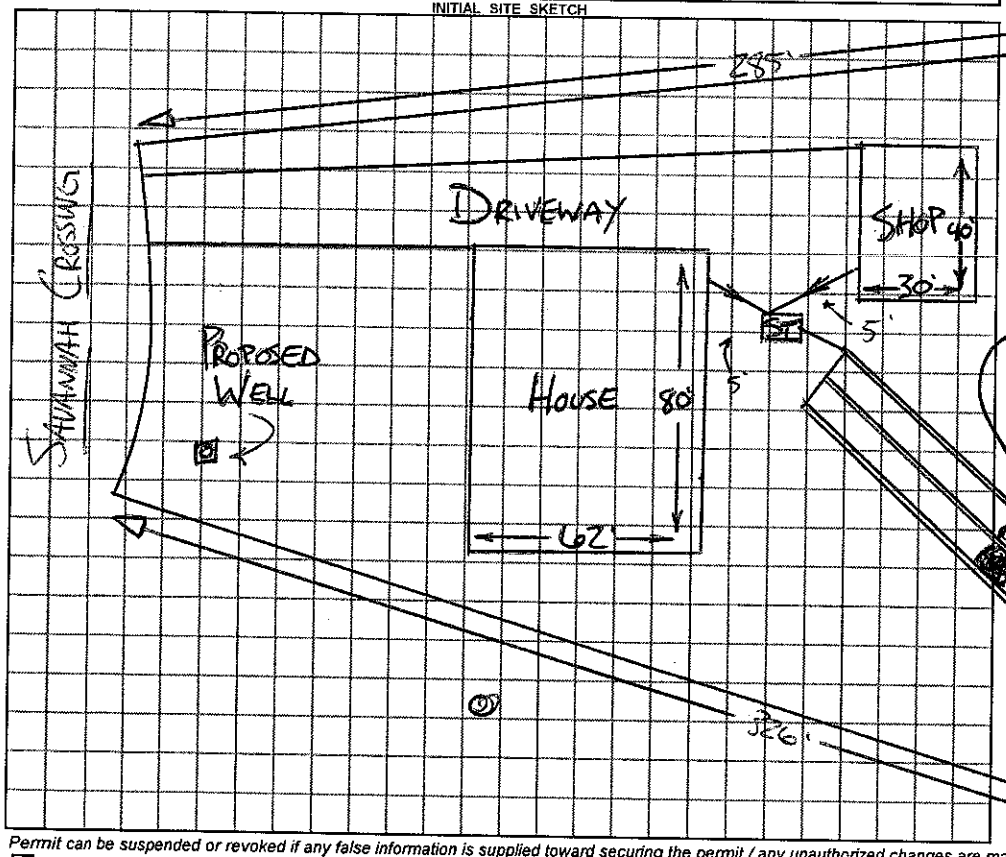

AS BUILT SKETCH

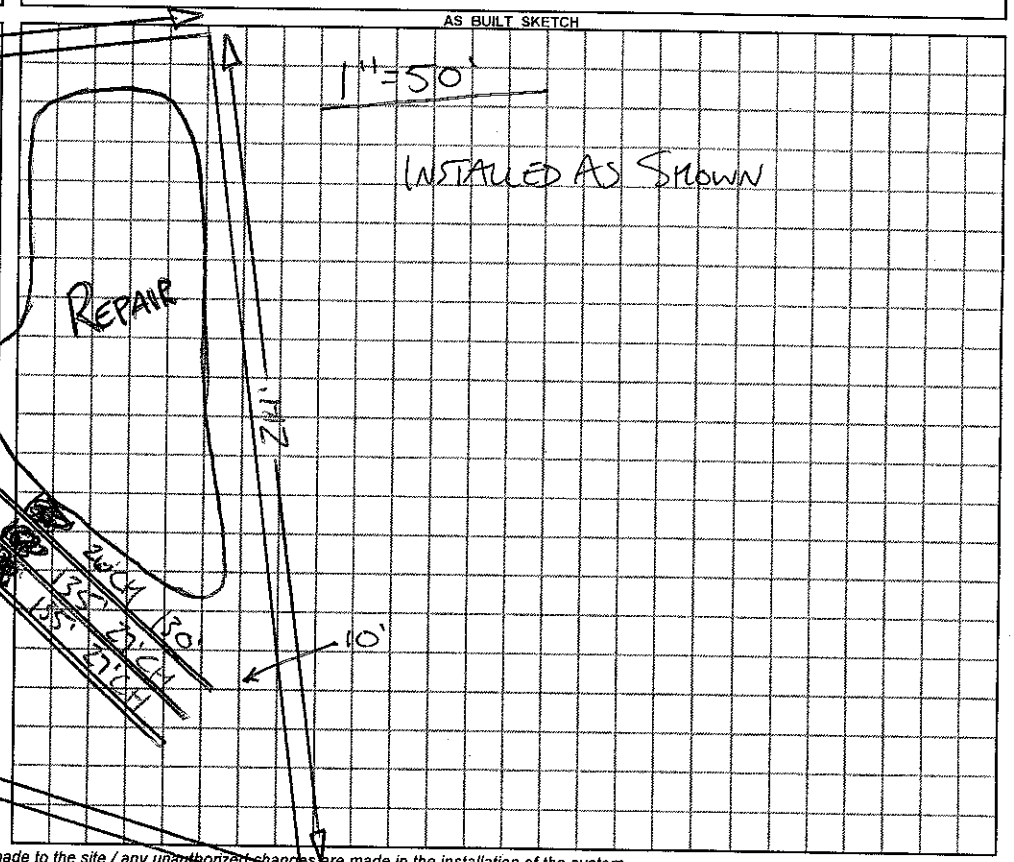

Permit can be suspended or revoked if any false information is supplied toward securing the permit / any unauthorized changes are made to the site / any unauthorized changes are made in the installation of the system.

☐ ***IMPROVEMENT PERMIT*** with plat valid without expiration. ☒ ***IMPROVEMENT PERMIT*** with plat valid without expiration. ***site plan valid 60 mo.*** ☒ ***AUTHORIZATION TO CONSTRUCT*** valid for period equal to IMPROVEMENT PERMIT—not to exceed 60 mo.

Owner / Applicant Signature: L Edward Beam Jr Date 1-31-12

IMPROVEMENT PERMIT by: REHS Date 1-25-12

AUTHORIZATION TO CONSTRUCT by: REHS Date 1-25-12

YOU SHOULD CONTACT A LOCATOR SERVICE PRIOR TO ANY EXCAVATION

Installed by: CALDWELL GRADING #1044

OPERATION PERMIT by: REHS Date 10-30-12

Existing System Inspected by: REHS Date

White Copy – Environmental Health YELLOW COPY (Final) Owner / Applicant PINK COPY (Initial) Owner / Applicant