David Martin Construction 375

10.00

IREDELL COUNTY HEALTH DEPARTMENT

STATESVILLE 704-878-5305 MOORESVILLE 704-664-5281

IMPROVEMENT PERMIT / AUTHORIZATION TO CONSTRUCT / OPERATION PERMIT / EXISTING SYSTEM INSPECTION

PERMIT# 140293 PIN# 4619318736.004 4679-41-1559 DATE 3-5-07

OWNER OR APPLICANT T & E Developers LLC PHONE: Business 202-9595 Home

ADDRESS 112 Vista Bluff Ln Mooresville NC 28117

LOCATION Hwy 801 North TR Wiggins Rd TR Kerri Ln on left Savannah Crossing

SUBDIVISION Kerri Plantation BLOCK / SECTION LOT 42 LOT AREA 1.01 Acre SITE CLASS. PS DESIGN FLOW 480 gpd L.T.A.R. .275

Septic Tank: 1000 Gallons: STB 794 Date 5-11-07

Pump Tank: 1000 Gallons: PT 283 Date 8-27-07

Pump Make: Crsuldo5 Model WE533 2M Serial No. F0789208

Nitrification Field: No Fields 1 Square Feet 1305 Linear Feet 435

No Lines 3@145' Trench Width 36" Max Trench Bottom Depth 36"

☒ New System ☐ Repair ☐ Expansion System Type: I II III IV V VI

System Description: Pump – PM – 25% Reduction

Repair System Description: LP – PPBPS

Maintenance Agreement Required: ☐ Yes ☐ No

☒ House/Mod. Home ☑ Mobile Home ☐ Business ☐ Other

No. Bedrooms 4 No. Persons No. Employees

Water Supply: ☒ Individual ☐ Public ☐ Community


Gravel Depth N/A ☐ Gravity ☐ Pressure ☐ Slab ☒ Crawl Space ☐ Basement w/plumbing ☐ Basement wo/plumbing

Comments/Conditions: Site evaluated & layout performed by Rollans Soil & Environmental Services.


Comments/Conditions: Filter in ST

11/14/07 Checked tanks, lines & pressure.

INITIAL SITE SKETCH

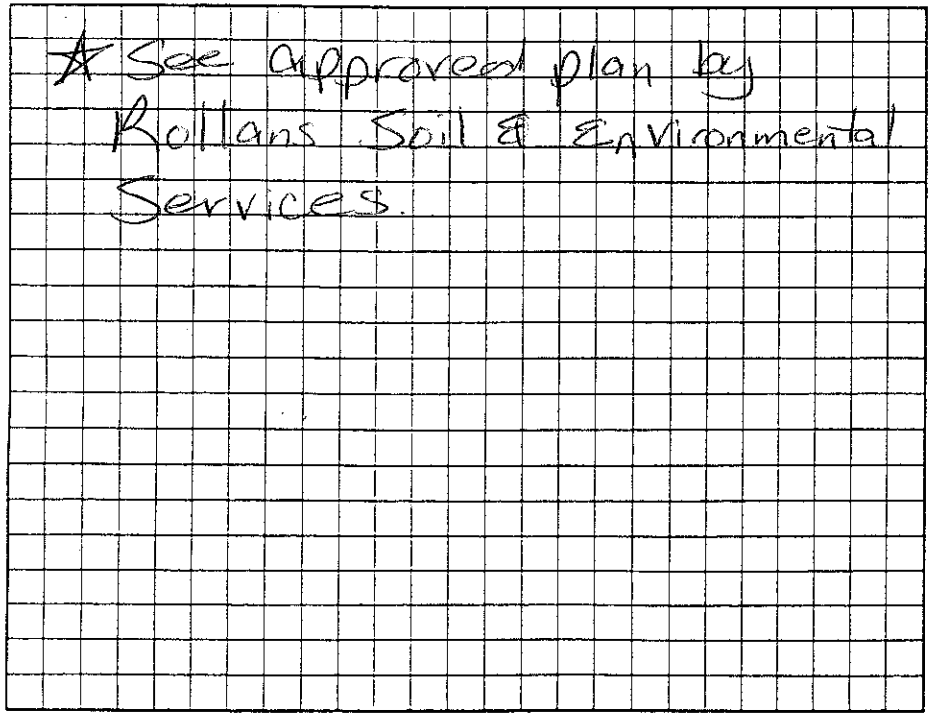

AS BUILT SKETCH

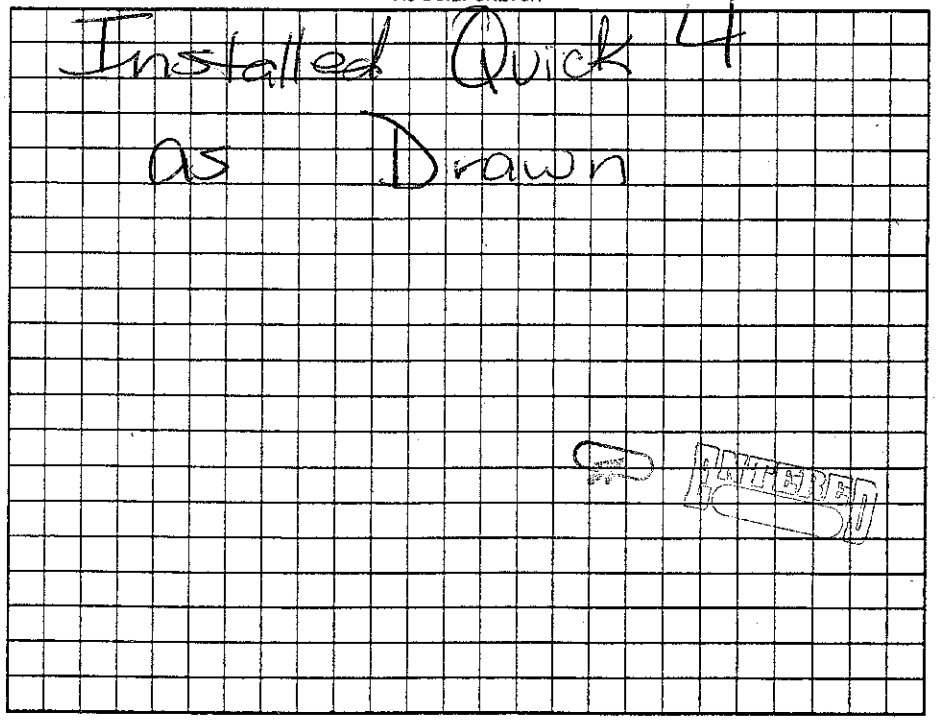

Permit can be suspended or revoked if any false information is supplied toward securing the permit/any unauthorized changes are made to the site/any unauthorized changes are made in the installation of the system. Improvement Permit with plat valid without expiration ☐ Improvement Permit with site plan valid for sixty months ☐ Authorization to Construct is valid for a period equal to that of Improvement Permit – not to exceed sixty months.

Signed: Julie M Smith date 4/10/07 Installed by: Larry Beam Grading

Improvement Permit by: Maria H Wilson RS date 3/5/07 Operation Permit by: Maria H Wilson RS date 9/17/08

Authorization to Construct by: Cindy Melville date 4-19-07 Existing System Inspection by: date

HEALTH DEPT. COPY: WHITE OWNER COPY (FINAL): YELLOW OWNER COPY (INITIAL): PINK