IREDELL COUNTY HEALTH DEPARTMENT

STATESVILLE 704-878-5305 MOORESVILLE 704-664-5281

First thing

IMPROVEMENT PERMIT / AUTHORIZATION TO CONSTRUCT / OPERATION PERMIT / EXISTING SYSTEM INSPECTION

PERMIT# 078661 PIN# 4679 41 4407 DATE 1/13/99

OWNER OR CONTRACTOR Wiggins Rd. Bapt. Church (TRUE GOSPEL) PHONE: Business 663-1825 Home

ADDRESS 3245 Jackson Rd. Mooresville, NC. 28115

LOCATION Wiggins Rd, 801 N JR Wiggins Rd. ~.4 mile on (R)

SUBDIVISION No BLOCK / SECTION No LOT No LOT AREA 5.0 Ac SITE CLASS. P5 DESIGN FLOW 500GPD L.T.A.R. .25

Septic Tank: 1000 Gallons; STB 794 Date 11-23-99

Pump Tank: Gallons; PT Date

Pump Make: Model Serial No.

Nitrification Field: No Fields 1 Square Feet 2000 Linear Feet 666

No Lines 6 Trench Width 36" Max Trench Bottom Depth 30" Gravel Depth 12"

[X] New System [ ] Repair System Type: I, (II), III, IV, V, VI

System Description: Drip Conventional

Repair System Description: Same

Maintenance Agreement Required: [ ] Yes [X] No

[ ] House/Mod. Home No. Bedrooms

[ ] Mobile Home No. Bathrooms

[ ] Business No. Employees

[X] Other .5GPM/MEMBER 100


[X] Slab [ ] Crawl Space [ ] Basement w/plumbing [X] Basement wo/plumbing

Water Supply: [X] Individual [ ] Public [ ] Community

Comments:/Conditions: V=20 P/L 578'

Comments:/Conditions: Riser & filter installed Everything looks good!

INITIAL SITE SKETCH

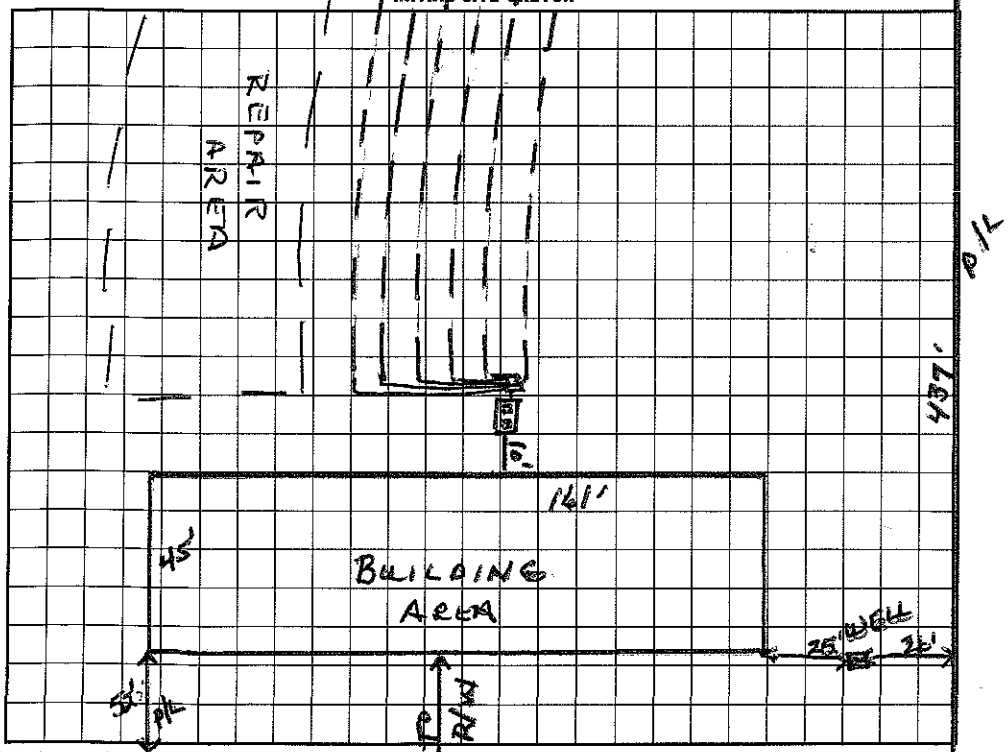

(1" = 50')

AS BUILT SKETCH

I understand that this permit can be suspended or revoked if any false information is supplied toward securing the permit/any unauthorized changes are made to the site/any unauthorized changes are made in the installation of the system. Improvement Permit with plan valid without expiration. Improvement Permit with site plan valid for sixty months. Authorization to Construct is valid for a period equal to that of Improvement Permit – not to exceed sixty months.

Signed: +D. E. Dellinger date

Improvement Permit by: date

Authorization to Construct by: Wesley Sparks RS. date 1/13/99

Installed by: Larry Beam

Operation Permit by: Mark H. Dotson RS date 2/23/2000

Existing System Inspection by: date

HEALTH DEPT. COPY: WHITE INSPECTION COPY (FINAL): GREEN OWNER COPY (FINAL): YELLOW INSPECTION COPY (INITIAL): PINK OWNER COPY (INITIAL): GOLD