IREDELL COUNTY HEALTH DEPARTMENT

STATESVILLE 704-878-5305 MOORESVILLE 704-664-5281

IMPROVEMENT PERMIT / AUTHORIZATION TO CONSTRUCT / OPERATION PERMIT / EXISTING SYSTEM INSPECTION

PERMIT# Repair PIN# 4679 41 7350 DATE 5/16/03

OWNER OR CONTRACTOR PHILLIP MCNEELY PHONE: Business Home

ADDRESS 202 WIGGINS RD. MOORESVILLE NC 28115

LOCATION 901 N - TR WIGGINS RD - ON RT # 1496 WIGGINS

SUBDIVISION N/A BLOCK / SECTION LOT N/A LOT AREA SITE CLASS. PS DESIGN FLOW 240GPD L.T.A.R. .36GPD/FT²

Septic Tank: EXISTING Gallons; STB Date

Pump Tank: Gallons; PT Date

Pump Make: Model Serial No.

Nitrification Field: No Fields 1 Square Feet 600 Linear Feet 200

No Lines 2 @ 100' Trench Width 36" Max Trench Bottom Depth AS NEEDED Gravel Depth N/A

☑ New System ☑ Repair System Type: I, II, (III), IV, V, VI

System Description: GRAVITY 25% REDUCTION

Repair System Description:

Maintenance Agreement Required: ☐ Yes ☑ No

☑ House/Mod. Home No. Bedrooms 2

☐ Mobile Home No. Bathrooms 2

☐ Business No. Employees

☐ Other


☐ Slab ☑ Crawl Space ☐ Basement w/plumbing ☐ Basement wo/plumbing

Water Supply: ☑ Individual ☐ Public ☐ Community

Comments:/Conditions:

Comments:/Conditions:

INITIAL SITE SKETCH (NO SCALE)

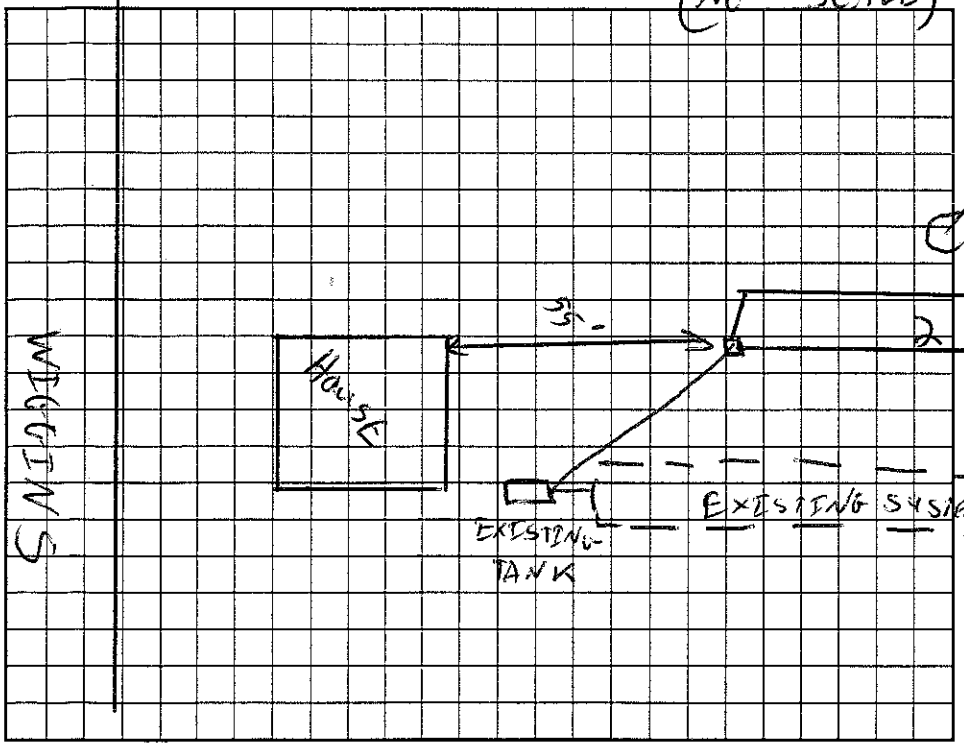

AS BUILT SKETCH

Permit can be suspended or revoked if any false information is supplied toward securing the permit/any unauthorized changes are made to the site/any unauthorized changes are made in the installation of the system. Improvement Permit with plat valid without expiration. Improvement Permit with site plan valid for sixty months. Authorization to Construct is valid for a period equal to that of Improvement Permit – not to exceed sixty months.

Signed: Phillip McNeely date 5/16/03 Installed by: LARRY BEAM

Improvement Permit by: C. Hyatt REHS date 5/16/03 Operation Permit by: C. Hyatt date 5/16/03

Authorization to Construct by: C. Hyatt REHS date 5/16/03 Existing System Inspection by: date

HEALTH DEPT. COPY: WHITE OWNER COPY (FINAL): YELLOW OWNER COPY (INITIAL): PINK