IREDELL COUNTY HEALTH DEPARTMENT

STATESVILLE 704-878-5305 — MOORESVILLE 704-664-5281

IMPROVEMENT PERMIT / AUTHORIZATION TO CONSTRUCT / OPERATION PERMIT / EXISTING SYSTEM INSPECTION

PERMIT # 153080 PIN # 4679-45-8592.000 DATE 11-4-08

OWNER or APPLICANT Dan Edwards 4679-44-8321 PHONE: Business 704-451-1721 Home:

OWNER or APPLICANT ADDRESS 3606 Amity Hill Rd Statesville NC 28677

LOCATION / DIRECTIONS Mazeppa, corner of Edwards Farm Ln + Mazeppa

SUBDIVISION BLOCK / SECTION LOT # — LOT AREA 1.78 Ac DESIGN FLOW 360 L.T.A.R. .35

Septic Tank 1000 Gallons: STB 1012 Date 4-9-08
Pump Tank Gallons: P T Date
Pump Make Model Serial #
Nitrification Field No Fields 1 No Lines 4 Linear Feet 340'
Trench Width 36" Max. Trench Bottom Depth 36" Gravel Depth 12"


☒ New System ☐ Repair ☐ Expansion System Type I (II) III IV V VI
System Description: Gravity, Gravel
Repair System Description: Same
Maintenance Agreement Required ☐ YES ☒ NO
☐ GRAVITY ☐ PRESSURE

☒ Residence No. Bedrooms 3
☐ Business No. Persons
☐ Other No. Employees
☐ Slab ☒ Crawl Space
☐ Basement w/plumbing ☐ Basement w/o plumbing

Water Supply: ☒ Private ☐ Public ☐ Community


Comments / Conditions 1) Install on contour 2) Tanks + lines must be 5' off foundation
-Installed 256ft of Drainfield

INITIAL SITE SKETCH

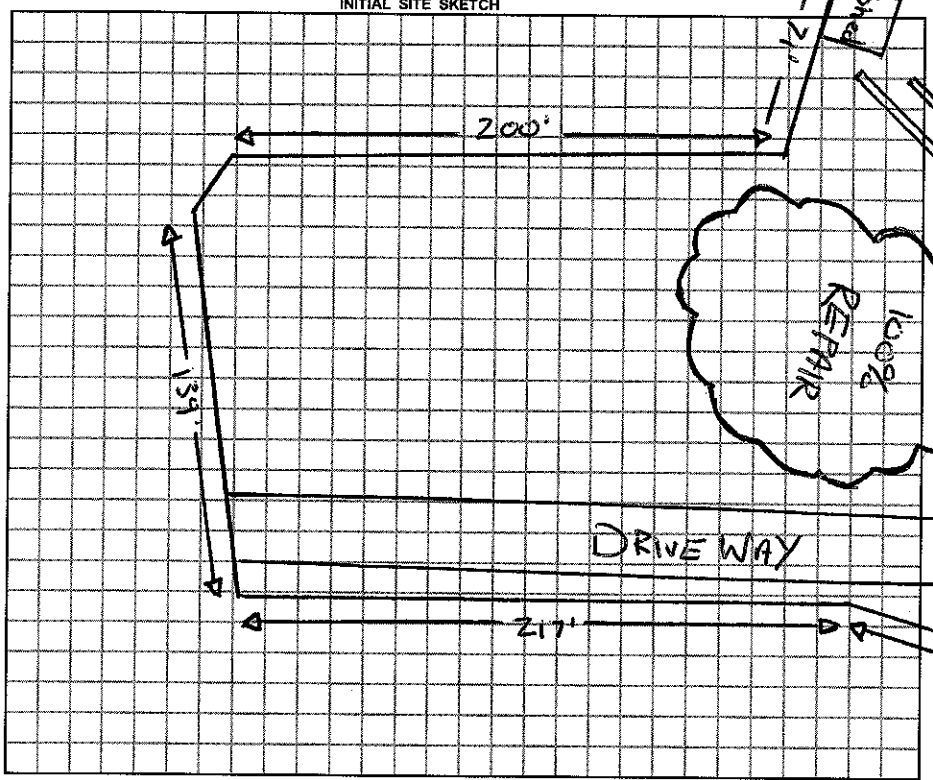

Comments / Conditions 4 lines @ 60' - 25% Reduction
16 Chambers per ditch, end feed
Used Quick 4 for Drainfield

AS BUILT SKETCH

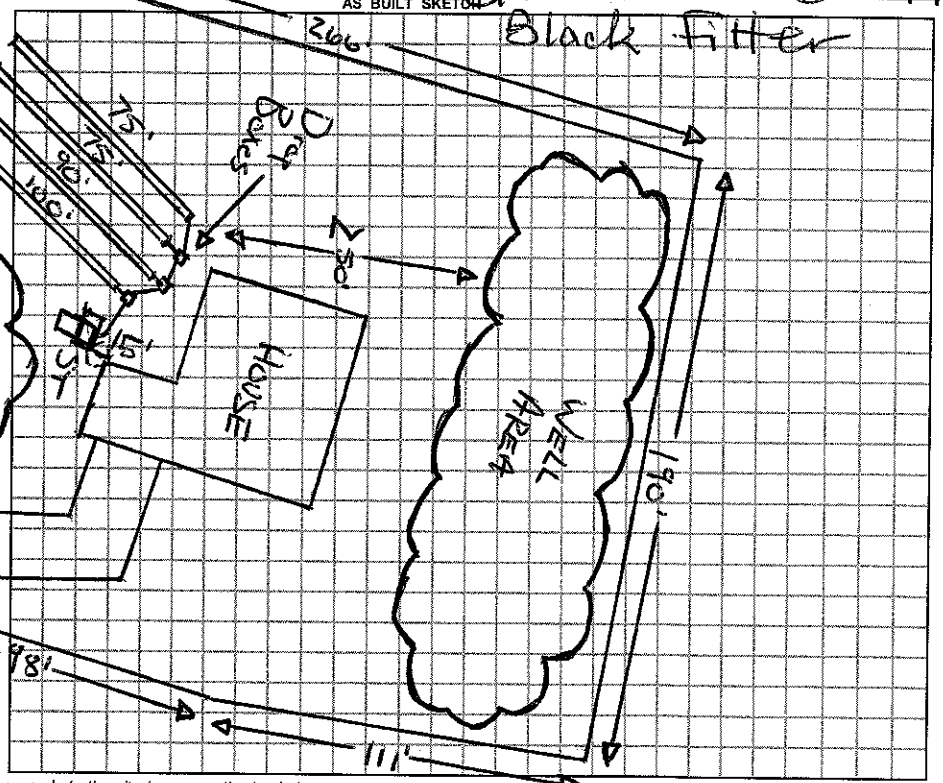

Permit can be suspended or revoked if any false information is supplied toward securing the permit / any unauthorized changes are made to the site / any unauthorized changes are made in the installation of the system.

☐ *IMPROVEMENT PERMIT w / plat valid without expiration.* ☒ *IMPROVEMENT PERMIT w / site plan valid for 60 mos.* ☐ *AUTHORIZATION TO CONSTRUCT valid for period equal to IMPROVEMENT PERMIT-not to exceed 60 mo.*

Owner / Applicant Signature: Dan Edwards Date 11-4-08

Improvement Permit by: Date 11-4-08

Authorzation to Construct by: Date 11-4-08

Installed by: Steve Jordan

Operation Permit by: Date: 7/8/09

Existing System Inspected by: Date:

YOU SHOULD CONTACT A LOCATOR SERVICE PRIOR TO ANY EXCAVATION.

WHITE COPY Environmental Health YELLOW COPY (Final) Owner / Applicant PINK COPY (Initial) Owner / Applicant