IREDELL COUNTY HEALTH DEPARTMENT

4679449373

STATESVILLE 704-878-5305 MOORESVILLE 704-664-5281

IMPROVEMENT PERMIT / CERTIFICATE OF COMPLETION / OPERATION PERMIT / EXISTING SYSTEM INSPECTION

PROPERTY DESCRIPTION NO. Repair DATE 6/20/96 TAX MAP NO. Repair

OWNER OR CONTRACTOR Grover Sloop PHONE: Business Watershed: ☐ Yes ☑ No

ADDRESS 1077 Mazeppa Rd Home 663-4862

LOCATION 21 N - TR Mazeppa - Go Straight cross Triplett Rd - # 1077 Mazeppa Rd

SUBDIVISION BLOCK / SECTION LOT LOT AREA ≈ .75ac SITE CLASS PS DESIGN FLOW 240 L.T.A.R. .4 gpd/ft

Septic Tank: existing Gallons; STB Date

Pump Tank: Gallons; PT Date

Pump Make: Model Serial No.

Nitrification Field: No Fields 1 Square Feet 600 Linear Feet 200

No Lines 4 Trench Width 36" Max Trench Bottom Depth 36" Gravel Depth 12"

☑ New System ☑ Repair System Type: I, II, III, IV, V, VI

System Description: Gravity Conventional

Repair System Description:

Maintenance Agreement Required: ☐ Yes ☑ No

☐ House/Mod. Home No. Bedrooms 2

☑ Mobile Home No. Bathrooms 2

☐ Business No. Employees

☐ Other


☐ Slab ☑ Crawl Space ☐ Basement w/plumbing ☐ Basement wo/plumbing

Water Supply: ☑ Individual ☐ Community ☐ Public

Comments:

Comments:

INITIAL SITE SKETCH

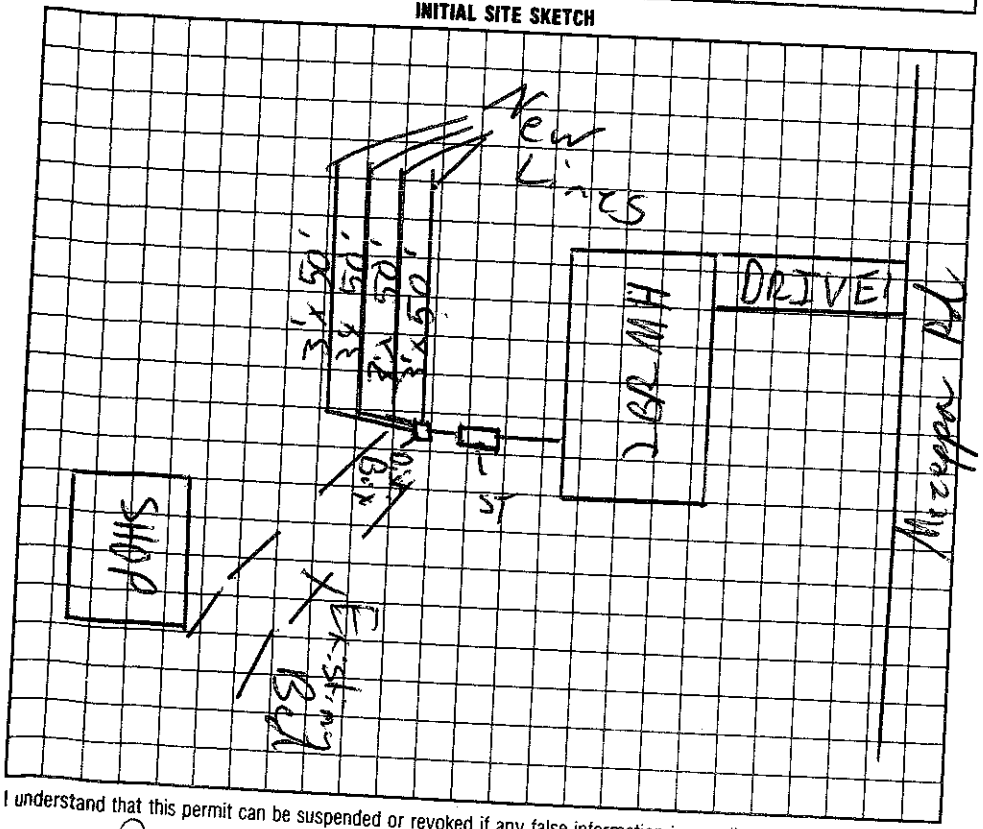

AS BUILT SKETCH

I understand that this permit can be suspended or revoked if any false information is supplied toward securing the permit/any unauthorized changes are made to the site/any unauthorized changes are made in the installation of the system.

Signed: Pauline Sloop

Improvement Permit by: [signature] Exist date 6/20/96

Existing System Inspection by: [signature] Final date 6/20/96

Installed by: LARRY BEAM

Certificate of Completion by: date

Operation Permit by: [signature] date 5/8/97

HEALTH DEPT. COPY: WHITE INSPECTION COPY (FINAL): GREEN OWNER COPY (FINAL): YELLOW INSPECTION COPY (INITIAL): PINK OWNER COPY (INITIAL): GOLD