IREDELL COUNTY HEALTH DEPARTMENT

STATESVILLE 704-878-5305 MOORESVILLE 704-664-5281

IMPROVEMENT PERMIT / AUTHORIZATION TO CONSTRUCT / OPERATION PERMIT / EXISTING SYSTEM INSPECTION

PERMIT # 156157 PIN # 4679-45-8668 DATE 4-22-09

OWNER or APPLICANT LARRY EDWARDS PHONE: Business 704-663-4649 Home:

OWNER or APPLICANT ADDRESS 1095 MAZEPPA RD MTULLA NC 28125

LOCATION / DIRECTIONS 115 N, TR MAZEPPA, C END

SUBDIVISION — BLOCK / SECTION — LOT # — LOT AREA 91.07AC DESIGN FLOW 360 L.T.A.R.

Septic Tank Gallons: STB Date

Pump Tank Gallons: PT Date

Pump Make EXISTING Model Serial #

Nitrification Field No Fields No Lines Linear Feet

Trench Width Max. Trench Bottom Depth Gravel Depth

☐ New System ☐ Repair ☐ Expansion System Type I II III IV V VI

System Description:

Repair System Description:

Maintenance Agreement Required ☐ YES ☐ NO

☒ GRAVITY ☐ PRESSURE

☒ Residence No. Bedrooms 3

☐ Business No. Persons

☐ Other No. Employees

☐ Slab ☐ Crawl Space


☒ Basement w/plumbing ☐ Basement w/o plumbing

Water Supply: ☒ Private ☐ Public ☐ Community

Comments / Conditions

Comments / Conditions * SYSTEM LOOKS GOOD

INITIAL SITE SKETCH

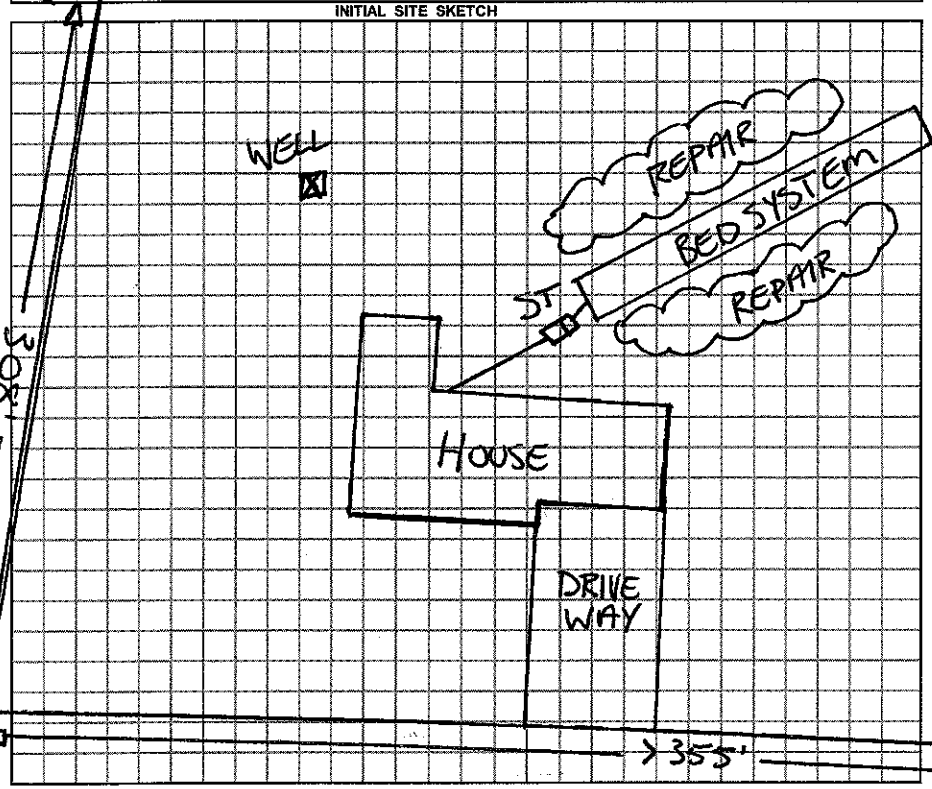

AS BUILT SKETCH

Permit can be suspended or revoked if any false information is supplied toward securing the permit / any unauthorized changes are made to the site / any unauthorized changes are made in the installation of the system.

☐ *IMPROVEMENT PERMIT w / plat valid without expiration.* ☐ *IMPROVEMENT PERMIT w / site plan valid for 60 mos.* ☐ *AUTHORIZATION TO CONSTRUCT valid for period equal to IMPROVEMENT PERMIT-not to exceed 60 mo.*

Owner / Applicant Signature: Larry W Edwards Date 4.23.09

Improvement Permit by: Date

Authorzation to Construct by: Date

Installed by:

Operation Permit by: Date:

Existing System Inspected by: Date: 4-22-09

YOU SHOULD CONTACT A LOCATOR SERVICE PRIOR TO ANY EXCAVATION.

WHITE COPY Environmental Health YELLOW COPY (Final) Owner / Applicant PINK COPY (Initial) Owner / Applicant