IREDELL COUNTY HEALTH DEPARTMENT

STATESVILLE 704-878-5305 MOORESVILLE 704-664-5281

IMPROVEMENT PERMIT / CERTIFICATE OF COMPLETION / OPERATION PERMIT / EXISTING SYSTEM INSPECTION

PROPERTY DESCRIPTION NO. D69503 DATE 10/30/97 TAX MAP NO. 4679480138 Watershed: ☐ Yes ☐ No

OWNER OR CONTRACTOR Donald & Ann Scott PHONE: Business 663-3655 Home (704) 664-3199

ADDRESS 230 Timberland Loop Mooresville NC 28115

LOCATION Triplett Rd. TL Confederate on right before Willow Creek

SUBDIVISION Twin Brooks BLOCK / SECTION ____ LOT 7 LOT AREA 13.71 Acres SITE CLASS. PS DESIGN FLOW 480 gpd L.T.A.R. .3

Septic Tank: 1000 Gallons; STB 794 Date 12/2/98

Pump Tank: ____ Gallons; PT ____ Date ____

Pump Make: ____ Model ____ Serial No. ____

Nitrification Field: No Fields ____ Square Feet 1605' Linear Feet 535

No Lines 5 at 107' Trench Width 36" Max Trench Bottom Depth 24"

☒ New System ☐ Repair System Type: I, (II), III, IV, V, VI

System Description: Grav. - Conventional

Repair System Description: Grav. - Conventional

Maintenance Agreement Required: ☐ Yes ☒ No

Gravel Depth 12"

☒ House/Mod. Home No. Bedrooms 4

☐ Mobile Home No. Bathrooms 2.5

☐ Business No. Employees ____

☐ Other ____


☐ Slab ☐ Crawl Space ☐ Basement w/plumbing ☒ Basement wo/plumbing

Water Supply: ☒ Individual ☐ Community ☐ Public


Comments: Well must be 100' from Septic System
* Feather off old Farm Berm

Comments:

INITIAL SITE SKETCH Scale 1:100'

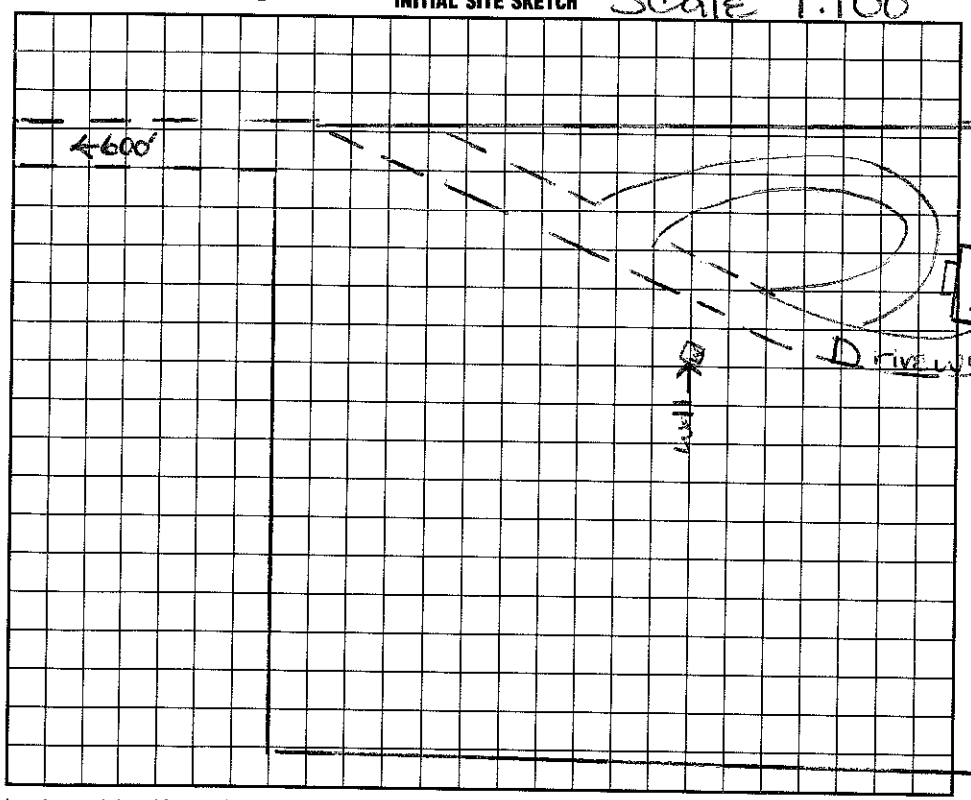

AS BUILT SKETCH

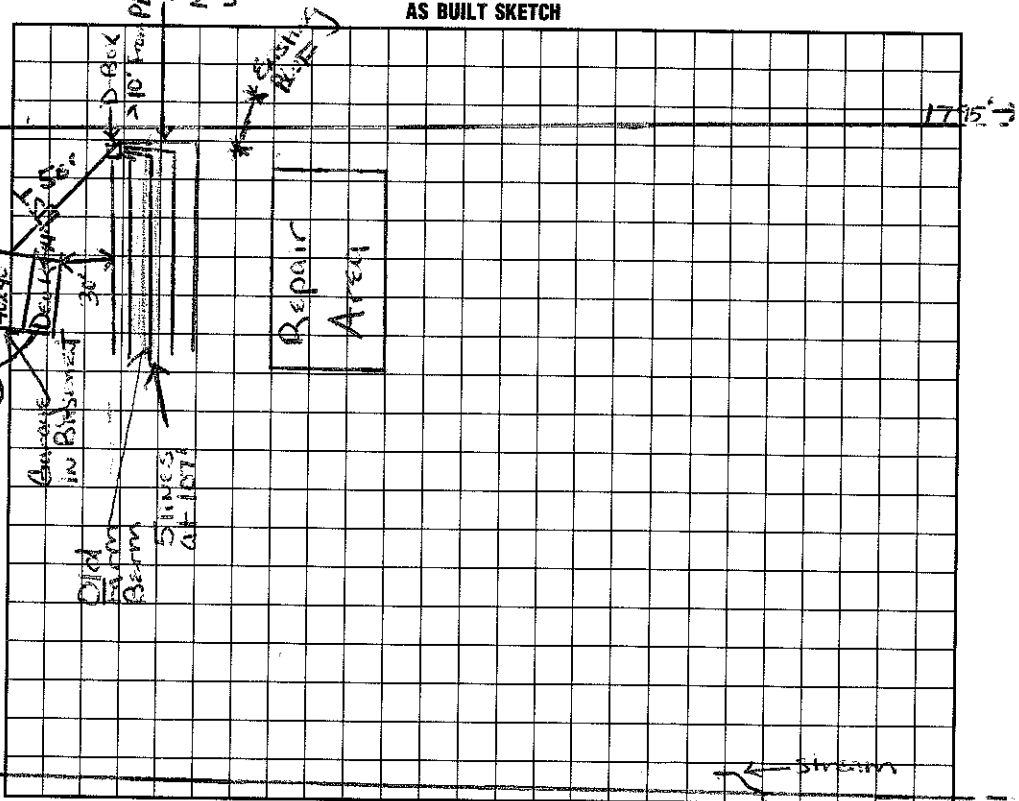

I understand that this permit can be suspended or revoked if any false information is supplied toward securing the permit/any unauthorized changes are made to the site/any unauthorized changes are made in the installation of the system. Improvement Permit is valid for 60 months from date of issuance.

Signed: Ann M. Scott

Improvement Permit by: Maria H. Watson date 10/30/97

Existing System Inspection by: Maria H. Watson date 10/30/97

Installed by: Curt Dunning

Certificate of Completion by: Wesley Speaks RS date 2/26/98

Operation Permit by: Wesley Speaks RS. date 2/26/98

HEALTH DEPT. COPY: WHITE INSPECTION COPY (FINAL): GREEN OWNER COPY (FINAL): YELLOW INSPECTION COPY (INITIAL): PINK OWNER COPY (INITIAL): GOLD

Construct. Auth.