IREDELL COUNTY HEALTH DEPARTMENT

Authorization to Construct 4679487960

STATESVILLE 704-878-5305 MOORESVILLE 704-664-5281

IMPROVEMENT PERMIT / ~~CERTIFICATE OF COMPLETION~~ / OPERATION PERMIT / EXISTING SYSTEM INSPECTION

PROPERTY DESCRIPTION NO. 23318 DATE 3/20/96 TAX MAP NO. 4E-2-A-13 Watershed: ☐ Yes ☑ No

OWNER OR CONTRACTOR Keith Carroll PHONE: Business Home 664-1155

ADDRESS 795 French Bell Rd Mt. Ulla NC 28125

LOCATION SR - TL Triplett Rd TR Confederate Rd TR Cool Creek Ln at end of Cul-de-sac

SUBDIVISION Twin Brooks BLOCK / SECTION LOT 8 LOT AREA 272x225x174 SITE CLASS PS DESIGN FLOW 360gpd L.T.A.R. .13gpd/ft²

Septic Tank: 1000 Gallons; STB 825 Date 9/6/96
Pump Tank: Gallons; PT Date
Pump Make: Model Serial No.
Nitrification Field: No Fields 1 Square Feet 1200 Linear Feet 400
No Lines 3 Trench Width 36" Max Trench Bottom Depth 24" Gravel Depth 12"

☑ New System ☐ Repair System Type: I II III IV V VI
System Description: Gravity Conventional Septic
Repair System Description:
Maintenance Agreement Required: ☐ Yes ☑ No

☐ Slab ☑ Crawl Space ☐ Basement w/plumbing ☐ Basement wo/plumbing


☑ House/Mod. Home No. Bedrooms 3
☐ Mobile Home No. Bathrooms 2
☐ Business No. Employees
☐ Other

Water Supply:
☑ Individual
☐ Community
☐ Public

Comments:

Comments:

INITIAL SITE SKETCH Set Back

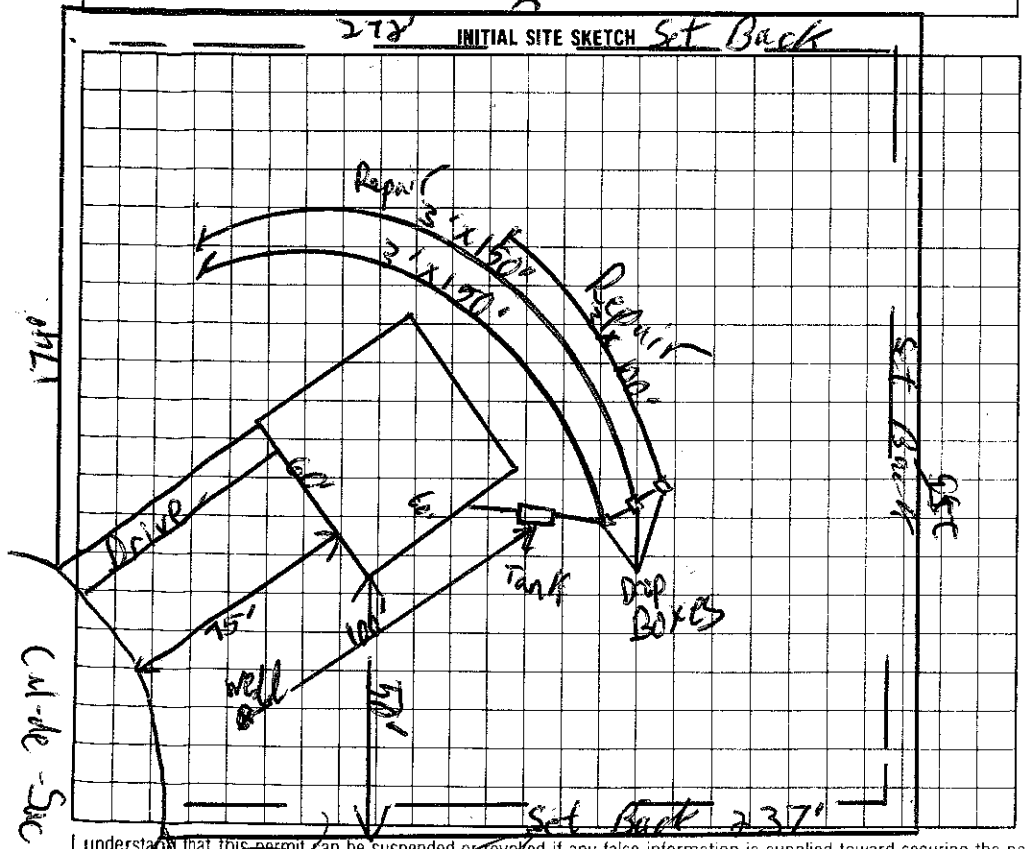

AS BUILT SKETCH

SAME AS SITE SKETCH

I understand that this permit can be suspended or revoked if any false information is supplied toward securing the permit/any unauthorized changes are made to the site/any unauthorized changes are made in the installation of the system.

Signed:

Improvement Permit by: C. Rudy Freeman EHSI date 3/20/96

Authorization to Construct / ~~Existing System Inspection~~ by: C. Rudy Freeman EHSI date 3/20/96

Installed by: MYERS SEPTIC

Certificate of Completion by: date

Operation Permit by: C. Rudy Freeman EHSI date 11/12/96

HEALTH DEPT. COPY: WHITE INSPECTION COPY (FINAL): GREEN OWNER COPY (FINAL): YELLOW INSPECTION COPY (INITIAL): PINK OWNER COPY (INITIAL): GOLD

As Verified 50% reduction for 6" stone