4679 49 0943

IREDELL COUNTY HEALTH DEPARTMENT

STATESVILLE 704-878-5305 MOORESVILLE 704-664-5281

IMPROVEMENT PERMIT / CERTIFICATE OF COMPLETION / OPERATION PERMIT / EXISTING SYSTEM INSPECTION

PROPERTY DESCRIPTION NO. 20947 DATE July 31, '95 TAX MAP NO. part of 4412A11 Watershed: ☑ Yes ☐ No

OWNER OR CONTRACTOR Keith Carroll PHONE: Business 664-1155 Home

ADDRESS 195 French Belk Rd Mt Ulla NC 28125

LOCATION 801 N. TR Triplett Rd TR Confederate Rd TR, just before Co. line 1st lot on Right

SUBDIVISION Twin Brooks BLOCK / SECTION I LOT 1 LOT AREA 150x292 SITE CLASS. PS DESIGN FLOW 360gpd L.T.A.R. .3

Septic Tank: 1000 Gallons; STB Date

Pump Tank: Gallons; PT Date

Pump Make: Model Serial No.

Nitrification Field: No Fields 1 Square Feet 900 Linear Feet 300

No Lines 3@100' Trench Width 36" Max Trench Bottom Depth 36" Gravel Depth NA

☑ New System ☐ Repair System Type: I, II, III, IV, V, VI

System Description: gravity, Infiltrator

Repair System Description: gravity, pumped, Infiltrator

Maintenance Agreement Required: ☐ Yes ☑ No

☑ House/Mod. Home No. Bedrooms 3

☐ Mobile Home No. Bathrooms 2

☐ Business No. Employees

☐ Other


☐ Slab ☑ Crawl Space ☐ Basement w/plumbing ☐ Basement wo/plumbing

Water Supply: ☑ Individual ☐ Community ☐ Public


Comments:

Comments:

INITIAL SITE SKETCH

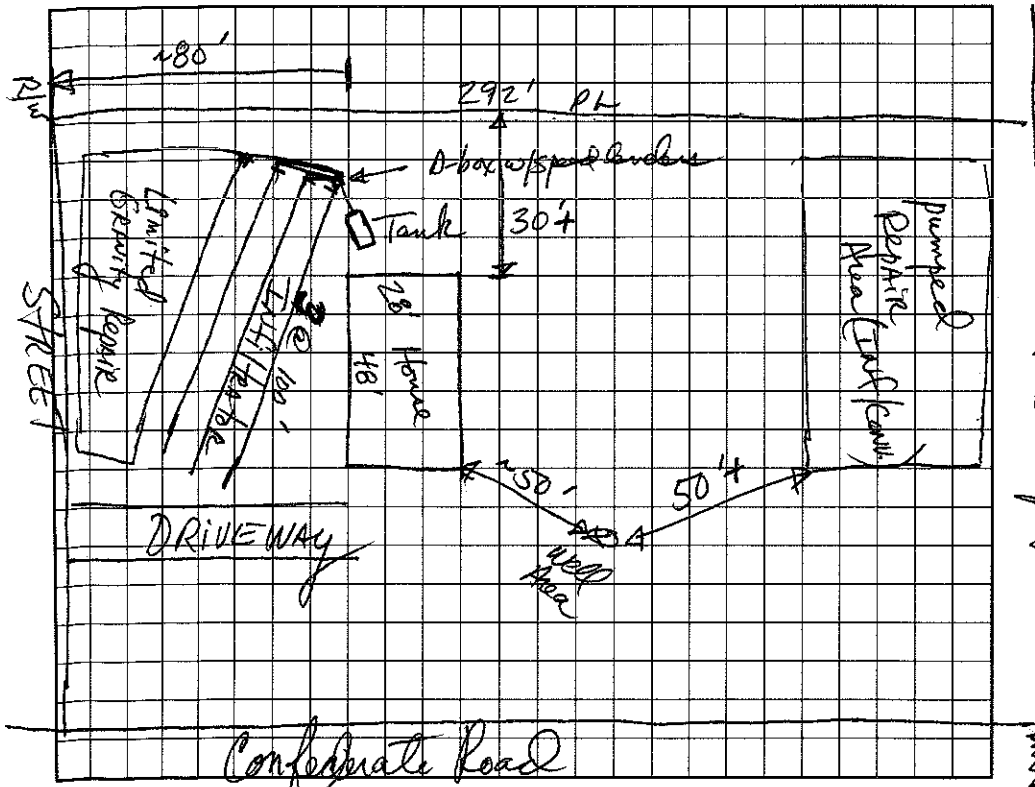

AS BUILT SKETCH

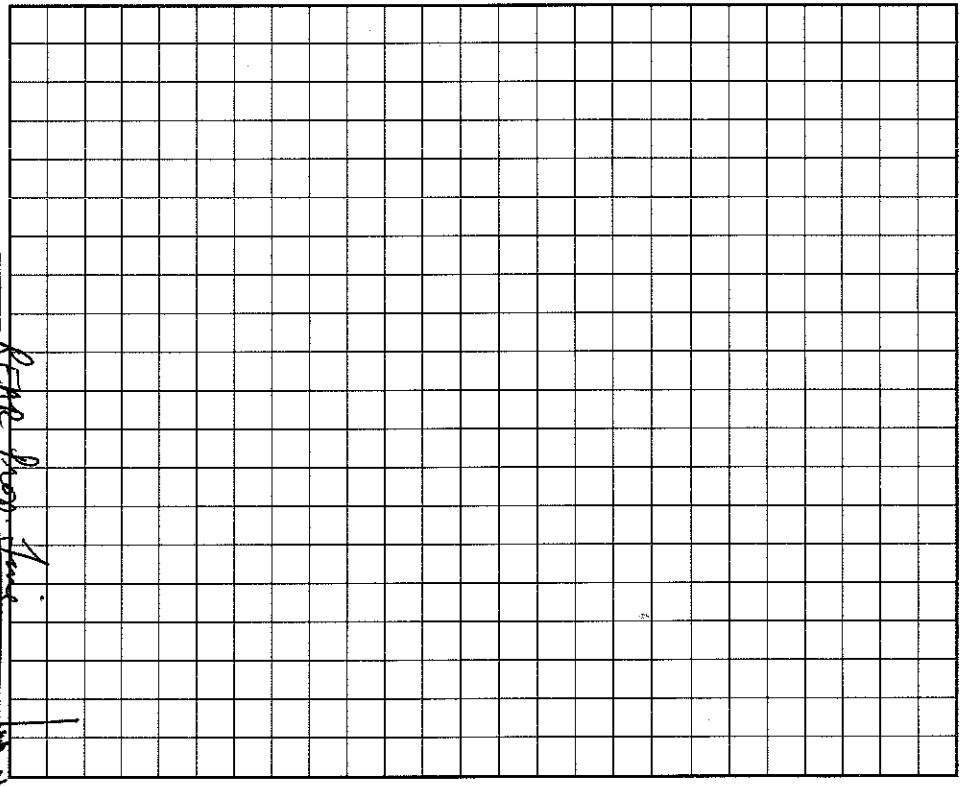

I understand that this permit can be suspended or revoked if any false information is supplied toward securing the permit/any unauthorized changes are made to the site/any unauthorized changes are made in the installation of the system. Improvement Permit is valid for 60 months from date of issuance.

Signed:

Improvement Permit by: Jamie R. Hinson, RS date 7/31/95

Existing System Inspection by: date

Installed by: F J E Inc

Certificate of Completion by: Wesley Sparks RS date 2/13/96

Operation Permit by: Wesley Sparks RS. date 2/13/96

HEALTH DEPT. COPY: WHITE INSPECTION COPY (FINAL): GREEN OWNER COPY (FINAL): YELLOW INSPECTION COPY (INITIAL): PINK OWNER COPY (INITIAL): GOLD