4679491840

# IREDELL COUNTY HEALTH DEPARTMENT

STATESVILLE 704-878-5305 MOORESVILLE 704-664-5281

## IMPROVEMENT PERMIT / CERTIFICATE OF COMPLETION / OPERATION PERMIT / EXISTING SYSTEM INSPECTIO

PROPERTY DESCRIPTION NO. 21793 DATE July 31, '95 TAX MAP NO. part of 4442A11 Watershed: ☑ Yes ☐ No

OWNER OR CONTRACTOR Keith Carroll PHONE: Business 664-1153 Home

ADDRESS 795 Trench Belk Rd. Mt Ulla 28125

LOCATION 801 N TL Triplett Rd. TR Confederate Rd. TR just before C. Line 2nd lot on Right

SUBDIVISION Twin Brooks BLOCK / SECTION II LOT 2 LOT AREA 150 X 292' SITE CLASS. Bpm195 DESIGN FLOW 360gpd L.T.A.R. .3

Septic Tank: 1000 Gallons; STB 794 Date 8/7/95

Pump Tank: ____ Gallons; PT ____ Date ____

Pump Make: ____ Model ____ Serial No. ____

Nitrification Field: No Fields 1 Square Feet 900 Linear Feet 300

No Lines 3@100' Trench Width 36" Max Trench Bottom Depth 36" Gravel Depth NA

☑ New System ☐ Repair System Type: I, II, III, IV, V, VI

System Description: gravity INF/Trench

Repair System Description: pumped conv. INF.

Maintenance Agreement Required: ☐ Yes ☑ No

☑ House/Mod. Home No. Bedrooms 3

☐ Mobile Home No. Bathrooms 2

☐ Business No. Employees ____

☐ Other ____


☐ Slab ☑ Crawl Space ☐ Basement w/plumbing ☐ Basement wo/plumbing

Water Supply: ☑ Individual ☐ Community ☐ Public


Comments: Exit plumbing where shown at or above existing grade and backfill against foundation pr order to avoid a sewage pump to follow contour w/ laterals

Comments:

**INITIAL SITE SKETCH**

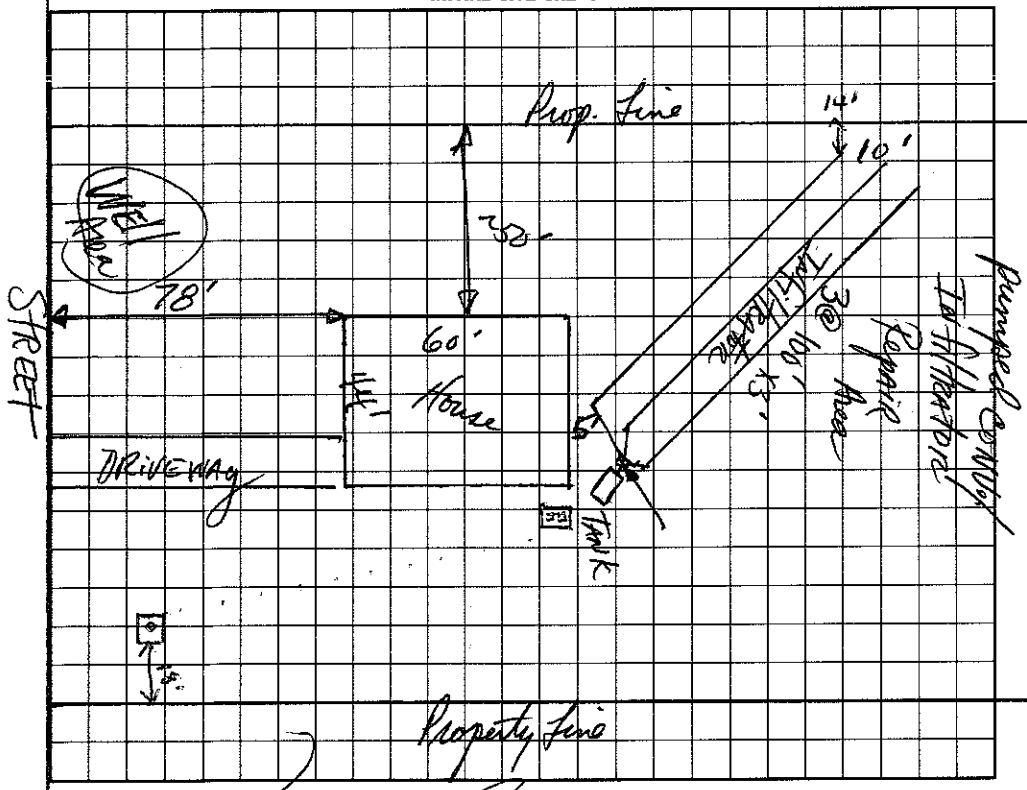


**AS BUILT SKETCH**

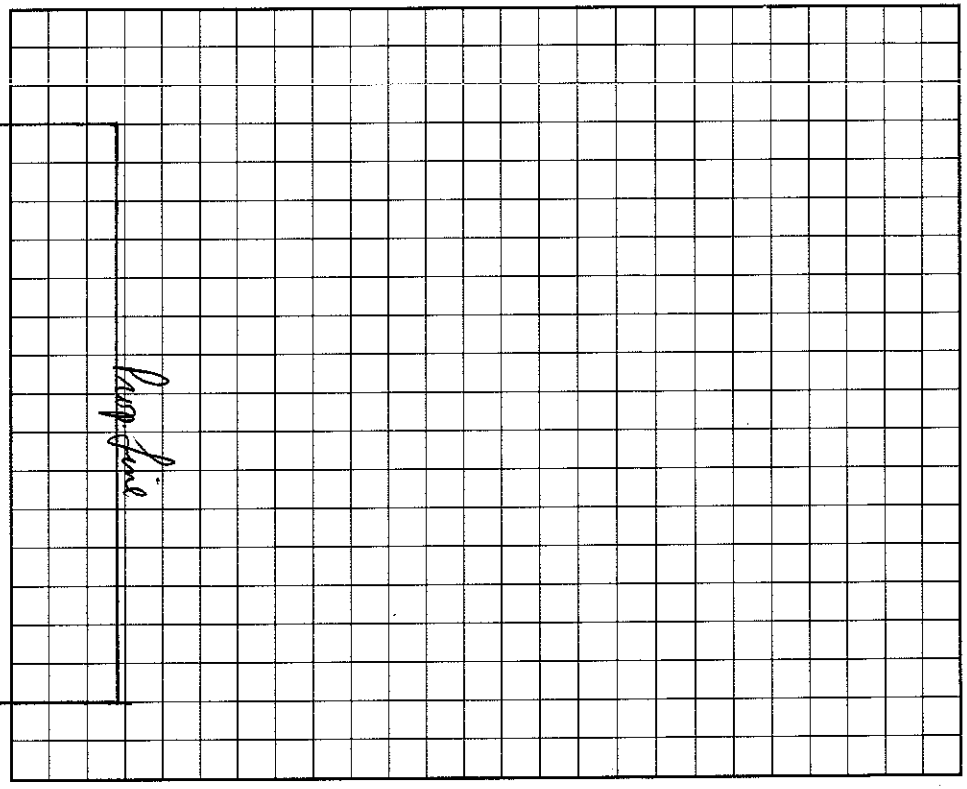


I understand that this permit can be suspended or revoked if any false information is supplied toward securing the permit/any unauthorized changes are made to the site/any unauthorized changes are made in the installation of the system.

Signed: [signature]

Improvement Permit by: Frank Johnson, RS date 7-31-95

Existing System Inspection by: ____ date ____

Installed by: Larry Beam

Certificate of Completion by: Wesley Sparks R.S. date 11/16/95

Operation Permit by: Wesley Sparks RS date 11/16/95

HEALTH DEPT. COPY: WHITE INSPECTION COPY (FINAL): GREEN OWNER COPY (FINAL): YELLOW INSPECTION COPY (INITIAL): PINK OWNER COPY (INITIAL): GOLD