4679492638

IREDELL COUNTY HEALTH DEPARTMENT

STATESVILLE 704-878-5305 MOORESVILLE 704-664-5281

IMPROVEMENT PERMIT / CERTIFICATE OF COMPLETION / OPERATION PERMIT / EXISTING SYSTEM INSPECTION

PROPERTY DESCRIPTION NO. Lot 2 1784 DATE July 31, '95 TAX MAP NO. part of 4H2A11 Watershed: ☐ Yes ☐ No

OWNER OR CONTRACTOR Keith Carroll PHONE: Business 664-1155 Home

ADDRESS 795 French Bell Rd, Mt Ulla, NC 28125

LOCATION 80 N. to Ty Triplett TR Confederate Rd TR just before Co. line 3rd lot on Right

SUBDIVISION Twin Brooks BLOCK / SECTION 1 LOT 3 LOT AREA SITE CLASS. Bpn 1956 DESIGN FLOW 360 gpd. L.T.A.R. .3

Septic Tank: 1000 Gallons; STB 794 Date 2/21/96

Pump Tank: Gallons; PT Date

Pump Make: Model Serial No.

Nitrification Field: No Fields 1 Square Feet 900 Linear Feet 300

No Lines 3@100 Trench Width 36" Max Trench Bottom Depth 36"

☑ New System ☐ Repair System Type: I, II, III, IV, V, VI

System Description: gravity INFiltrator

Repair System Description: pumped conv. Inf.

Maintenance Agreement Required: ☐ Yes ☑ No

Gravel Depth N/A

☑ House/Mod. Home No. Bedrooms 3

☐ Mobile Home No. Bathrooms 2

☐ Business No. Employees

☐ Other


☐ Slab ☑ Crawl Space ☐ Basement w/plumbing ☐ Basement wo/plumbing

Water Supply: ☑ Individual ☐ Community ☐ Public


Comments:

Comments: Tank and two lines checked on 3/25/96.

INITIAL SITE SKETCH

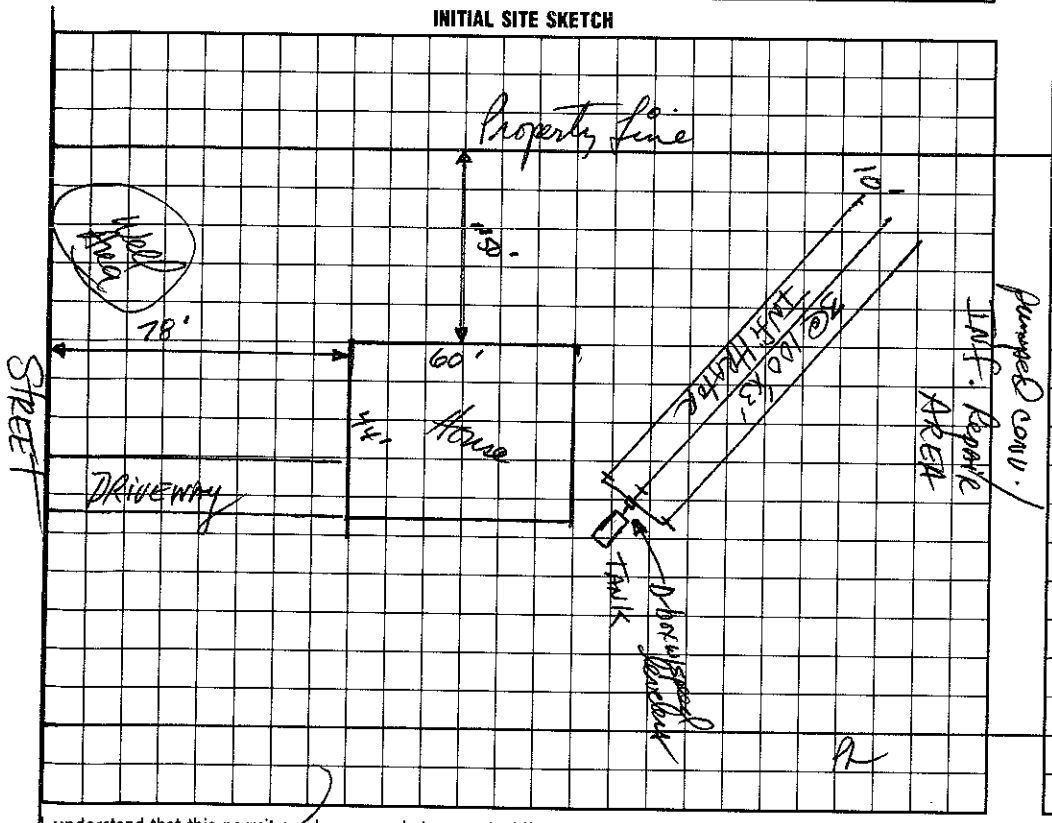

AS BUILT SKETCH

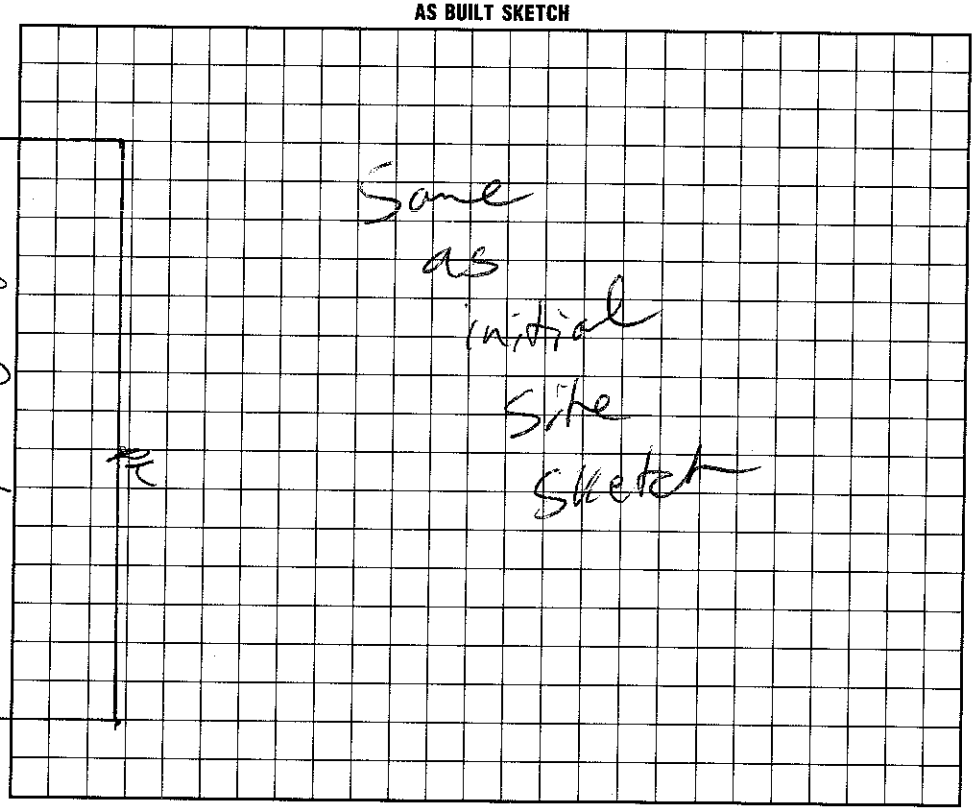

I understand that this permit can be suspended or revoked if any false information is supplied toward securing the permit/any unauthorized changes are made to the site/any unauthorized changes are made in the installation of the system.

Signed: Keith Carroll

Improvement Permit by: [signature] date 7-31-95

Existing System Inspection by: date

Installed by: FJ Ervin

Certificate of Completion by: date

Operation Permit by: C. Bailey Green HSE date 3/26/96

HEALTH DEPT. COPY: WHITE INSPECTION COPY (FINAL): GREEN OWNER COPY (FINAL): YELLOW INSPECTION COPY (INITIAL): PINK OWNER COPY (INITIAL): GOLD