4679493527

IREDELL COUNTY HEALTH DEPARTMENT

STATESVILLE 704-878-5305 MOORESVILLE 704-664-5281

IMPROVEMENT PERMIT / CERTIFICATE OF COMPLETION / OPERATION PERMIT / EXISTING SYSTEM INSPECTION

PROPERTY DESCRIPTION NO. 21785 DATE July 31, '95 TAX MAP NO. part of 4442A11 Watershed: ☐ Yes ☐ No

OWNER OR CONTRACTOR Keith Carroll PHONE: Business 664-0155 Home

ADDRESS 795 French Belk Rd Mt. Ulla, N.C. 28125

LOCATION 80 I-N, Tr Tuplett Rd. Tr Confederate Rd. Tr just before Co. line 4th lot on Right

SUBDIVISION Turn Brooks BLOCK / SECTION II LOT 4 LOT AREA SITE CLASS. V pre 1956 DESIGN FLOW 360 gpd L.T.A.R. .03

Septic Tank: 1000 Gallons; STB Date

Pump Tank: Gallons; PT Date

Pump Make: Model Serial No.

Nitrification Field: No Fields 1 Square Feet 900 Linear Feet 300

No Lines 3@100 Trench Width 36" Max Trench Bottom Depth 36" Gravel Depth N/A

☑ New System ☐ Repair System Type: I, II, III, IV, V, VI

System Description: gravity Infiltrator

Repair System Description: pumped Infiltrator Conv.

Maintenance Agreement Required: ☐ Yes ☐ No

☑ House/Mod. Home No. Bedrooms 3

☐ Mobile Home No. Bathrooms 2

☐ Business No. Employees

☐ Other


☐ Slab ☑ Crawl Space ☐ Basement w/plumbing ☐ Basement wo/plumbing

Water Supply: ☑ Individual ☐ Community ☐ Public

Comments: Exit plumbing above existing grade and backfill next to foundation in order to avoid use of a sewage pump.

Comments:

INITIAL SITE SKETCH

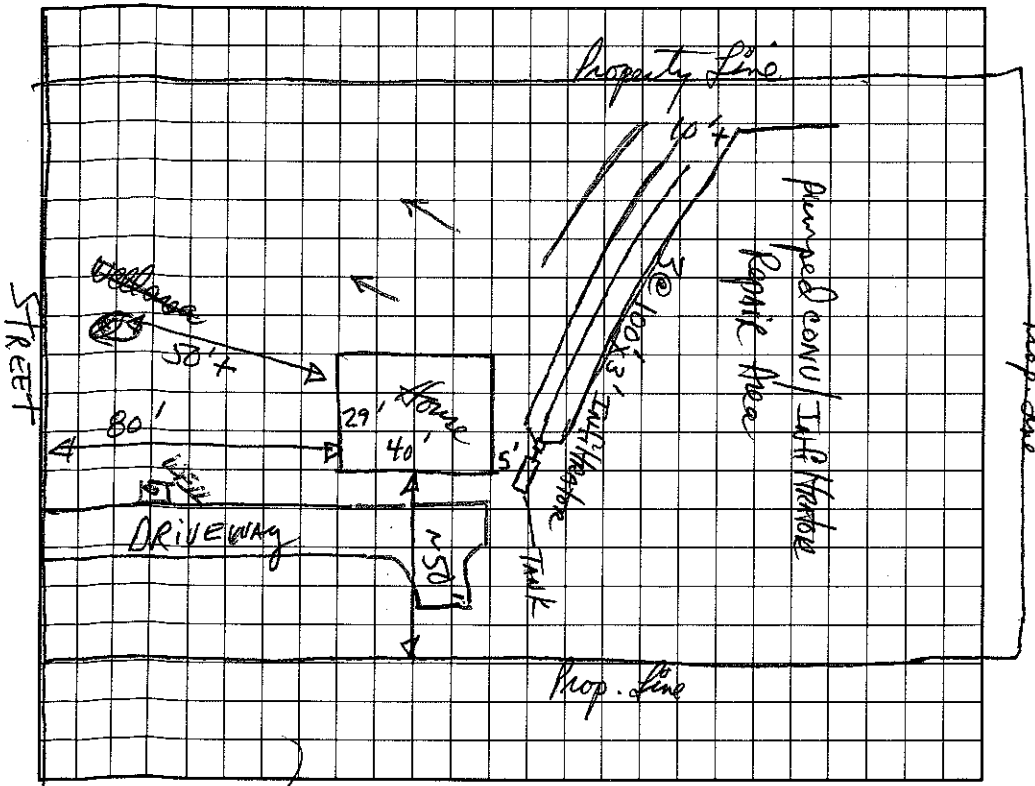

AS BUILT SKETCH

I understand that this permit can be suspended or revoked if any false information is supplied toward securing the permit/any unauthorized changes are made to the site/any unauthorized changes are made in the installation of the system.

Signed: Keith Carroll

Improvement Permit by: [illegible] date 7-31-95

Existing System Inspection by: date

Installed by: Larry Tucker Jr.

Certificate of Completion by: date

Operation Permit by: [illegible] date 8/16/96

HEALTH DEPT. COPY: WHITE INSPECTION COPY (FINAL): GREEN OWNER COPY (FINAL): YELLOW INSPECTION COPY (INITIAL): PINK OWNER COPY (INITIAL): GOLD