4679493975

IREDELL COUNTY HEALTH DEPARTMENT

STATESVILLE 704-878-5305 MOORESVILLE 704-664-5281

IMPROVEMENT PERMIT / ~~CERTIFICATE OF COMPLETION~~ / OPERATION PERMIT / EXISTING SYSTEM INSPECTIO

PROPERTY DESCRIPTION NO. 26076 DATE 2/5/99 TAX MAP NO. 4679 49 5927 Watershed: [X] Yes [ ] No

OWNER OR CONTRACTOR Carroll Custom Homes PHONE: Business 664-1155 Home

ADDRESS 795 French Bulk Rd. Mt Ulla NC 28125

LOCATION Mazeppa Rd. TR Confederate Rd TR Cool Creek Rd. to 2ND lot on (L)

SUBDIVISION Twin Brooks BLOCK / SECTION II LOT 15 LOT AREA .775 SITE CLASS. PS DESIGN FLOW 360 L.T.A.R. .25

Septic Tank: 1000 Gallons; STB 714 Date 9/17/98

Pump Tank: 1000 Gallons; PT 37 Date 11/5/98

Pump Make: Gould Model WE05118 Serial No. H98-12632

Nitrification Field: No. Fields 1 Square Feet 1080* Linear Feet 360*

No. Lines 5 Trench Width 36" Max Trench Bottom Depth 30" Gravel Depth SAND

[X] New System [ ] Repair System Type: I, II, (III) IV, V, VI

System Description: *PressMan. - CH PLASTIC

Repair System Description: SAME

Maintenance Agreement Required: [ ] Yes [X] No

[X] House/Mod. Home No. Bedrooms 3

[ ] Mobile Home No. Bathrooms 2

[ ] Business No. Employees

[ ] Other


[ ] Slab [X] Crawl Space [ ] Basement w/plumbing [ ] Basement wo/plumbing

Water Supply: [X] Individual [ ] Community [ ] Public


Comments: 70-80' lines

Comments: Tanks, lines & Pressure Checked 12/30/98 MJ
Electrical & Alarm Checked 1/6/99

INITIAL SITE SKETCH

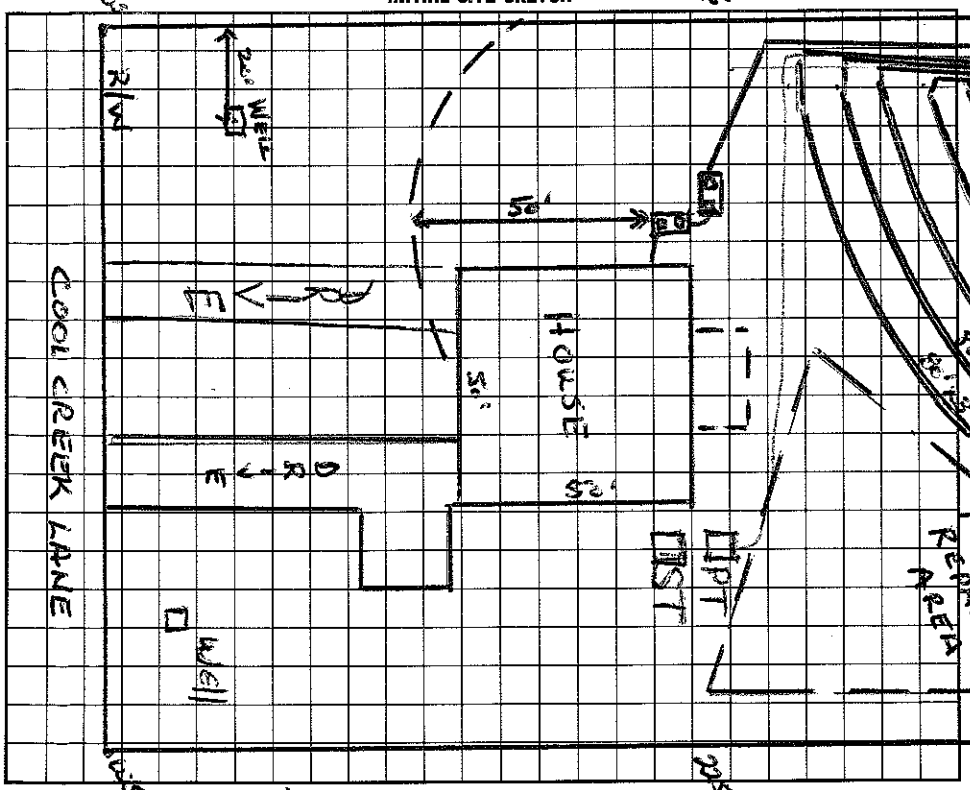

AS BUILT SKETCH

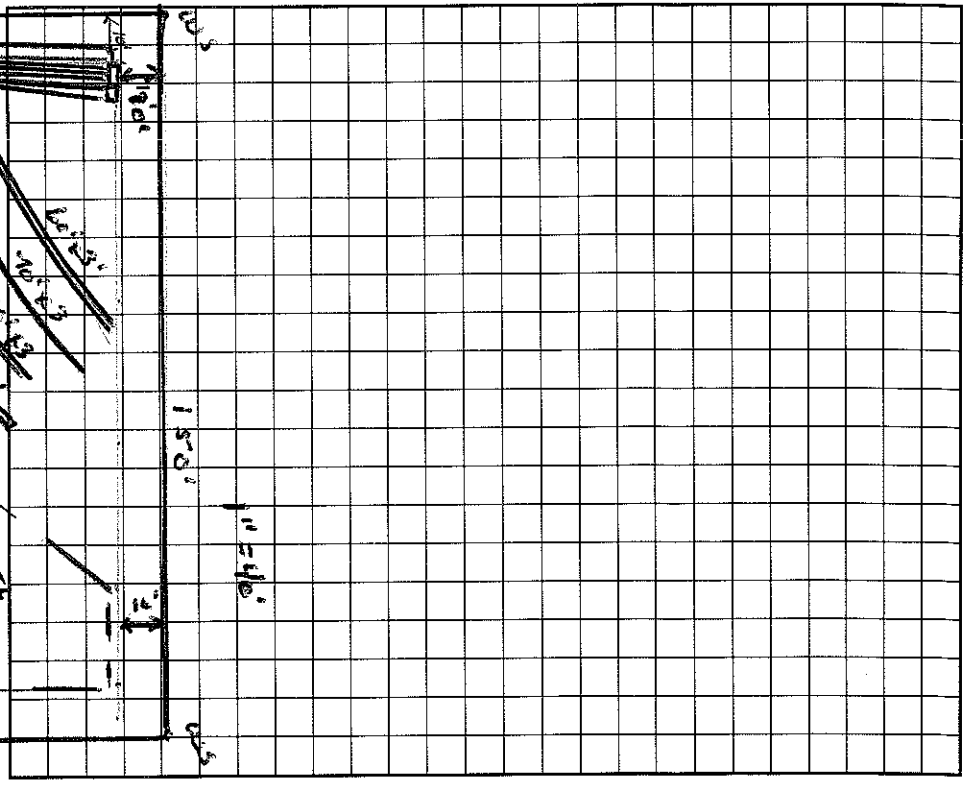

I understand that this permit can be suspended or revoked if any false information is supplied toward securing the permit/any unauthorized changes are made to the site/any unauthorized changes are made in the installation of the system. Improvement Permit is valid for 60 months from date of issuance.

Signed: [signature]

Improvement Permit by: Wesley Sparks R.S. date 2/5/99

Existing System Inspection by: Wesley Sparks R.S. date 2/5/99

Installed by: E J Ervin

Certificate of Completion by: Maria H. Dotson R.S. date 11/6/99

Operation Permit by: Maria H. Dotson date 11/6/99

HEALTH DEPT. COPY: WHITE INSPECTION COPY (FINAL): GREEN OWNER COPY (FINAL): YELLOW INSPECTION COPY (INITIAL): PINK OWNER COPY (INITIAL): GOLD