4679 49 4425

...OUNTY HEALTH DEPARTMENT

STATESVILLE 704-878-5305 MOORESVILLE 704-664-5281

...OVEMENT PERMIT / CERTIFICATE OF COMPLETION / OPERATION PERMIT / EXISTING SYSTEM INSPECTION

PROPERTY DESCRIPTION NO. 2125 DATE Nov. 29, '95 TAX MAP NO. part of 4H 2A11 Watershed: ☐ Yes ☐ No

OWNER OR CONTRACTOR Keith Carroll PHONE: Business Home

ADDRESS 195 Jones Belk Rd. Mt Ulla

LOCATION Triplett Road TR Confederate Rd. - TR Cool Creek LN. on Right near end 132 Cool Creek

SUBDIVISION Town Brooks BLOCK / SECTION 2 LOT 5 LOT AREA .856 Ac SITE CLASS. B per 1996 DESIGN FLOW 360 gpd L.T.A.R. .03

Septic Tank: 1000 Gallons; STB 194 Date 6/10/96
Pump Tank: 1000 Gallons; PT 12 Date
Pump Make: Model Serial No.
Nitrification Field: No Fields 1 Square Feet 900 Linear Feet 300
No Lines 3@100' Trench Width 36" Max Trench Bottom Depth 36" Gravel Depth NA

☑ New System ☐ Repair System Type: I, II, III, IV, V, VI
System Description: pumped/pm/FM/Heaton
Repair System Description: Same as LP Panel
Maintenance Agreement Required: ☐ Yes ☑ No

☑ House/Mod. Home No. Bedrooms 3
☐ Mobile Home No. Bathrooms 2
☐ Business No. Employees
☐ Other
☐ Slab ☐ Crawl Space ☑ Basement w/plumbing ☐ Basement wo/plumbing


Water Supply: ☑ Individual ☐ Community ☐ Public

Comments: House to be located in existing low area (natural drainageway). Grading of house area to divert stormwater towards midpoint between house and street.

Comments: Lines, Tanks Checked on 8/9/96

1"=50'

INITIAL SITE SKETCH

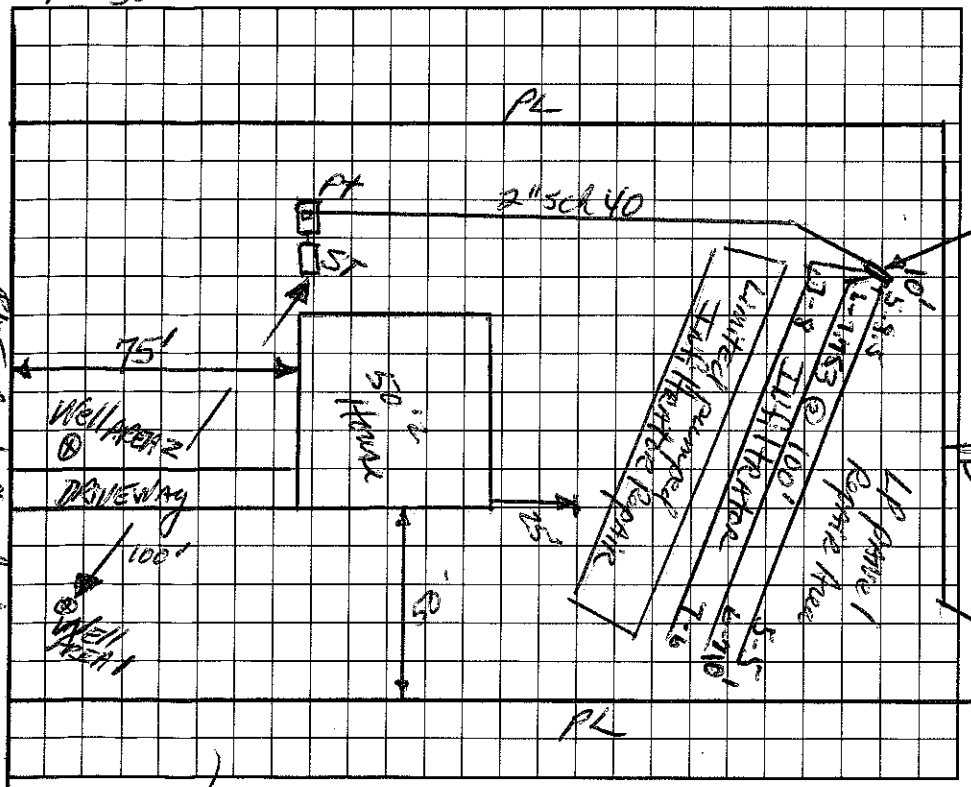

AS BUILT SKETCH

I understand that this permit can be suspended or revoked if any false information is supplied toward securing the permit/any unauthorized changes are made to the site/any unauthorized changes are made in the installation of the system.

Signed: Keith Carroll

Improvement Permit by: [signature], RS date 11-29-95

Authority to Construct / Existing System Inspection by: [signature], RS date 11-29-95

Installed by: Larry Tucker Jr.

Certificate of Completion by: date

Operation Permit by: [signature] date 8/29/96

HEALTH DEPT. COPY: WHITE INSPECTION COPY (FINAL): GREEN OWNER COPY (FINAL): YELLOW INSPECTION COPY (INITIAL): PINK OWNER COPY (INITIAL): GOLD