IREDELL COUNTY HEALTH DEPARTMENT

Authorization to Construct

STATESVILLE 704-878-5305 MOORESVILLE 704-664-5281

IMPROVEMENT PERMIT / ~~CERTIFICATE OF COMPLETION~~ / OPERATION PERMIT / EXISTING SYSTEM INSPECTION

PROPERTY DESCRIPTION NO. 26075 DATE 2/5/97 TAX MAP NO. 4679 49 5929 4863 Watershed: ☐ Yes ☒ No

OWNER OR CONTRACTOR Carroll Custom Homes PHONE: Business 664-1155 Home

ADDRESS 795 French Belk Rd. Mt Ulla, NC. 28125

LOCATION Mapp Rd. TR Confederate Rd. TR # 380 lot on (L)

SUBDIVISION Twin Brooks BLOCK / SECTION III LOT 14 LOT AREA .775 SITE CLASS. PS DESIGN FLOW 360 L.T.A.R. .30

Septic Tank: 1000 Gallons; STB 325 Date 4/16/97

Pump Tank: _____ Gallons; PT _____ Date _____

Pump Make: _____ Model _____ Serial No. _____

Nitrification Field: No Fields 1 Square Feet 1200 Linear Feet 400

No Lines 5 Trench Width 36" Max Trench Bottom Depth 36" Gravel Depth 12"

☒ New System ☐ Repair System Type: I, II, III, IV, V, VI

System Description: GRAV - CONVENTIONAL

Repair System Description: PRES - CONVENTIONAL

Maintenance Agreement Required: ☐ Yes ☐ No

☐ House/Mod. Home No. Bedrooms 3

☐ Mobile Home No. Bathrooms 2

☐ Business No. Employees ____

☐ Other _____


☐ Slab ☐ Crawl Space ☐ Basement w/plumbing ☐ Basement wo/plumbing

Water Supply:
☒ Individual
☐ Community
☐ Public


Comments:

Comments:

INITIAL SITE SKETCH

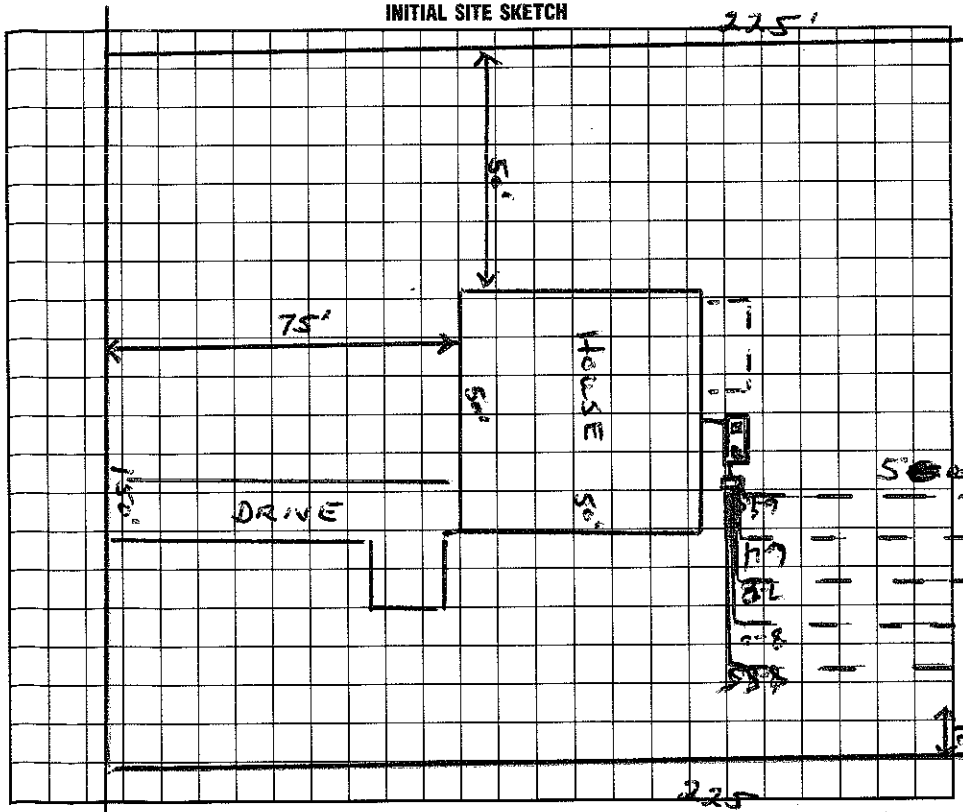

AS BUILT SKETCH

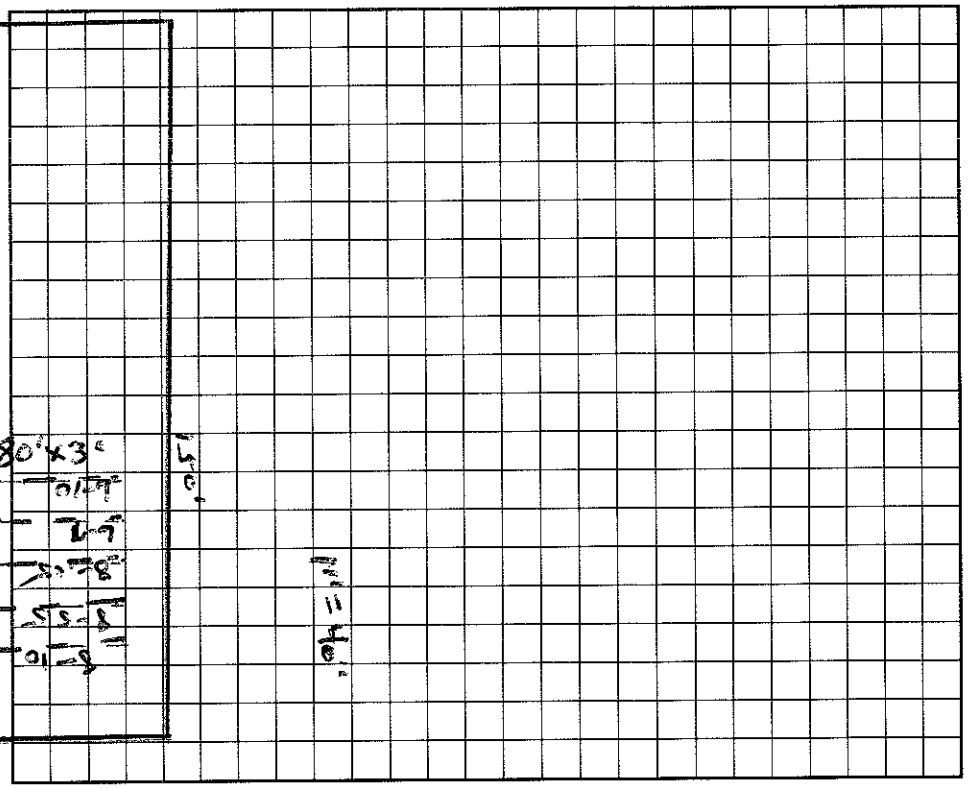

I understand that this permit can be suspended or revoked if any false information is supplied toward securing the permit/any unauthorized changes are made to the site/any unauthorized changes are made in the installation of the system. Improvement Permit is valid for 60 months from date of issuance.

Signed: _____

Improvement Permit by: Wesley Sparks RS. date 2/5/97

Existing System Inspection by: Wesley Sparks RS. date 2/5/97

Installed by: Ben Myers

Certificate of Completion by: Wesley Sparks RS. date 5/22/97

Operation Permit by: Wesley Sparks RS. date 5/22/97

HEALTH DEPT. COPY: WHITE INSPECTION COPY (FINAL): GREEN OWNER COPY (FINAL): YELLOW INSPECTION COPY (INITIAL): PINK OWNER COPY (INITIAL): GOLD