IREDELL COUNTY HEALTH DEPARTMENT

STATESVILLE 704-878-5305 MOORESVILLE 704-664-5281

IMPROVEMENT PERMIT / CERTIFICATE OF COMPLETION / OPERATION PERMIT / EXISTING SYSTEM INSPECTION

PROPERTY DESCRIPTION NO. 2926 DATE Nov. 29, '95 TAX MAP NO. part of 4442 A11 4679 49 5303 Watershed: ☐ Yes ☒ No

OWNER OR CONTRACTOR Keith Carroll PHONE: Business Home

ADDRESS 795 French Bell Rd, ~~Statesville~~ Mtville

LOCATION Turkey Rd. TR Confederate Rd. TR Coal Creek Ln. on Right at end

SUBDIVISION Twin Brooks BLOCK / SECTION 2 LOT 6 LOT AREA .842Ac SITE CLASS. B per 1957 DESIGN FLOW 360 gpd L.T.A.R. .3

Septic Tank: 1000 Gallons; STB 794 Date 6/7/96

Pump Tank: 1000 Gallons; PT 12 Date 6/24/96

Pump Make: Model Serial No.

Nitrification Field: No Fields 1 Square Feet 900 Linear Feet 300

No Lines 3@100' Trench Width 36" Max Trench Bottom Depth 24" Gravel Depth NA

☒ New System ☐ Repair System Type: I, II, III, IV, V, VI

System Description: pumped/gravity/Infiltrator

Repair System Description: LPP ABS

Maintenance Agreement Required: ☐ Yes ☒ No initially

☒ House/Mod. Home No. Bedrooms 3

☐ Mobile Home No. Bathrooms 2

☐ Business No. Employees

☐ Other

☐ Slab ☐ Crawl Space ☒ Basement w/plumbing ☐ Basement wo/plumbing


Water Supply: ☒ Individual ☐ Community ☐ Public

Comments: Keep nitrification trenches shallow. House located on natural drainageway. Stormwater to be diverted to midpoint between house and street

Comments: Lines, Tanks Presume Checked 8/9/96

1" = 50'

INITIAL SITE SKETCH

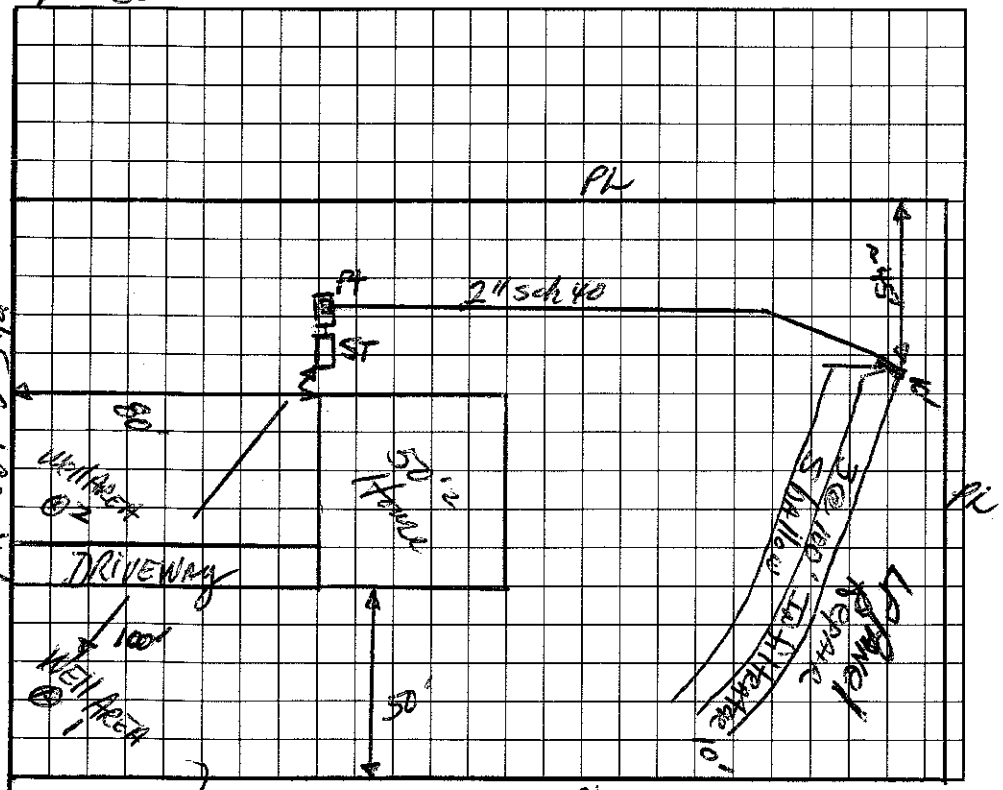

AS BUILT SKETCH

I understand that this permit can be suspended or revoked if any false information is supplied toward securing the permit/any unauthorized changes are made to the site/any unauthorized changes are made in the installation of the system.

Signed Keith Carroll

Improvement Permit by: DR Thurman RS date 11-29-95

Existing System Inspection by: DR Thurman IRS date 11-29-95

Installed by: Larry Tucker Jr.

Certificate of Completion by: date

Operation Permit by: E.H.S.T. date 8/29/96

Authorized to construct

HEALTH DEPT. COPY: WHITE INSPECTION COPY (FINAL): GREEN OWNER COPY (FINAL): YELLOW INSPECTION COPY (INITIAL): PINK OWNER COPY (INITIAL): GOLD