IREDELL COUNTY HEALTH DEPARTMENT

STATESVILLE 704-878-5305 MOORESVILLE 704-664-5281

IMPROVEMENT PERMIT / CERTIFICATE OF COMPLETION / OPERATION PERMIT / EXISTING SYSTEM INSPECTION

PROPERTY DESCRIPTION NO. 2926 DATE Nov. 29, '95 TAX MAP NO. part of 4H2 A11 4679 49 5303 Watershed: ☐ Yes ☑ No

OWNER OR CONTRACTOR Keith Carroll PHONE: Business _____ Home _____

ADDRESS 795 Front Bell Rd, ~~Statesville~~ Mtville

LOCATION Triplett Rd. TR Confederate Rd. TR Coal Creek Ln. on Right at end

SUBDIVISION Twin Brooks BLOCK / SECTION 2 LOT 6 LOT AREA .842ac SITE CLASS. B per 1952 DESIGN FLOW 360gpd L.T.A.R. .3

Septic Tank: 1000 Gallons; STB 794 Date 6/7/96

Pump Tank: 1000 Gallons; PT 12 Date 6/24/96

Pump Make: _____ Model _____ Serial No. _____

Nitrification Field: No Fields 1 Square Feet 900 Linear Feet 300

No Lines 3@100' Trench Width 36" Max Trench Bottom Depth 24" Gravel Depth NA

☑ New System ☐ Repair System Type: I, II, III, IV, V, VI

System Description: pumped/rm / Infiltrator

Repair System Description: LPP BRS

Maintenance Agreement Required: ☐ Yes ☑ No Initially

☐ Slab ☐ Crawl Space ☑ Basement w/plumbing ☐ Basement wo/plumbing

☑ House/Mod. Home No. Bedrooms 3

☐ Mobile Home No. Bathrooms 2

☐ Business No. Employees _____

☐ Other _____


Water Supply: ☑ Individual ☐ Community ☐ Public

Comments: Keep nitrification trenches shallow. House located in natural drainageway. Storm water to be diverted to midpoint between house and street

Comments: Lines, Tanks Pressure Checked 8/9/96

1" = 50'

INITIAL SITE SKETCH

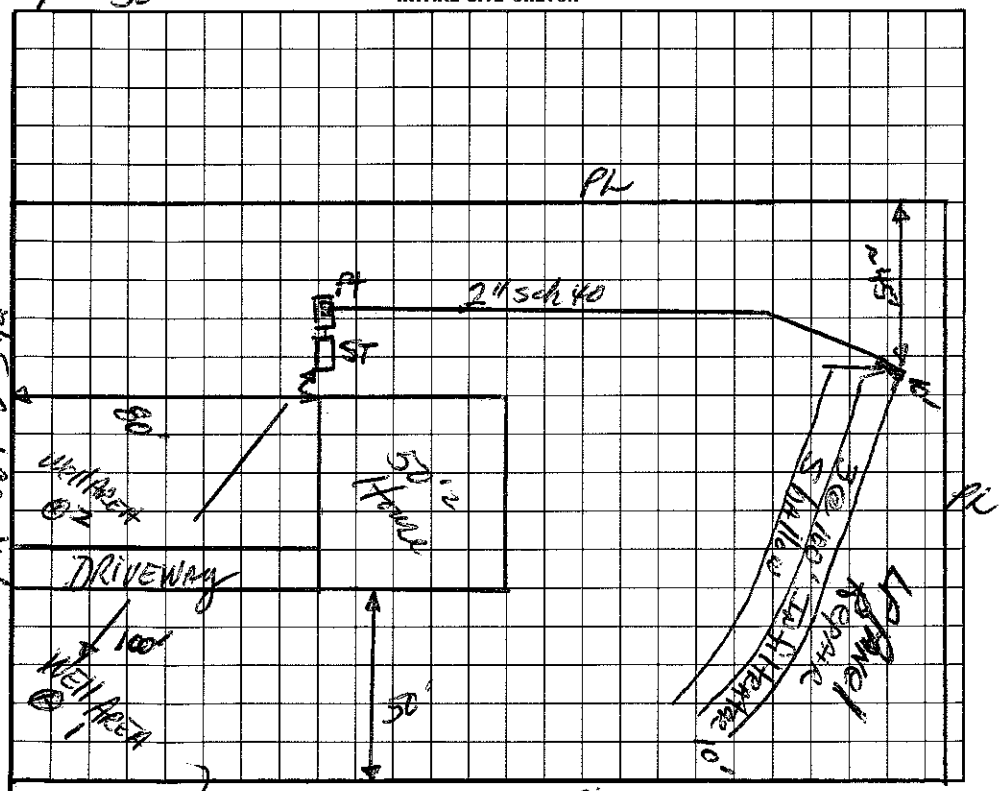

AS BUILT SKETCH

I understand that this permit can be suspended or revoked if any false information is supplied toward securing the permit/any unauthorized changes are made to the site/any unauthorized changes are made in the installation of the system.

Signed Keith Carroll

Improvement Permit by: DR Thompson, RS date 11-29-95

Existing System Inspection by: DR Thompson, RS date 11-29-95

Auth to construct

Installed by: Larry Tucker Jr.

Certificate of Completion by: _____ date _____

Operation Permit by: C. Ray Lowe EHS date 8/29/96

HEALTH DEPT. COPY: WHITE INSPECTION COPY (FINAL): GREEN OWNER COPY (FINAL): YELLOW INSPECTION COPY (INITIAL): PINK OWNER COPY (INITIAL): GOLD