1:30

IREDELL COUNTY HEALTH DEPARTMENT

Authorization to Construct

STATESVILLE 704-878-5305 MOORESVILLE 704-664-5281

IMPROVEMENT PERMIT / ~~CERTIFICATE OF COMPLETION~~ / OPERATION PERMIT / EXISTING SYSTEM INSPECTION

PROPERTY DESCRIPTION NO. 26074 DATE 2/5/97 TAX MAP NO. 4679 49 ~~5927~~ 5751 Watershed: ☒ Yes ☐ No

OWNER OR CONTRACTOR Carroll Custom Homes, Inc. PHONE: Business ____ Home 664-1155

ADDRESS 795 French Balk Rd. Mt Ulla, NC 28125

LOCATION Mazeppa Rd. TR Confederate Rd. TR Cool Creek Lane to 4 lot on (L)

SUBDIVISION Twin Brooks BLOCK / SECTION II LOT 13 LOT AREA .775 SITE CLASS. PS DESIGN FLOW 360 L.T.A.R. .25

Septic Tank: 1000 Gallons; STB 312 Date 11-21-99

Pump Tank: ____ Gallons; PT ____ Date ____

Pump Make: ____ Model ____ Serial No. ____

Nitrification Field: No Fields 1 Square Feet *1440 Linear Feet 480*

No Lines 4 Trench Width 36" Max Trench Bottom Depth 32" Gravel Depth SAND

☒ New System ☐ Repair System Type: I, II, III, IV, V, VI

System Description: *GRAV - CONVENTIONAL

Repair System Description: PRESSURE/CONVENTIONAL

Maintenance Agreement Required: ☐ Yes ☒ No

☒ House/Mod. Home No. Bedrooms 3

☐ Mobile Home No. Bathrooms 2

☐ Business No. Employees ____

☐ Other ____


☐ Slab ☒ Crawl Space ☐ Basement w/plumbing ☐ Basement wo/plumbing

Water Supply: ☒ Individual ☐ Community ☐ Public

Comments: Conventional Trenches

Comments:

INITIAL SITE SKETCH

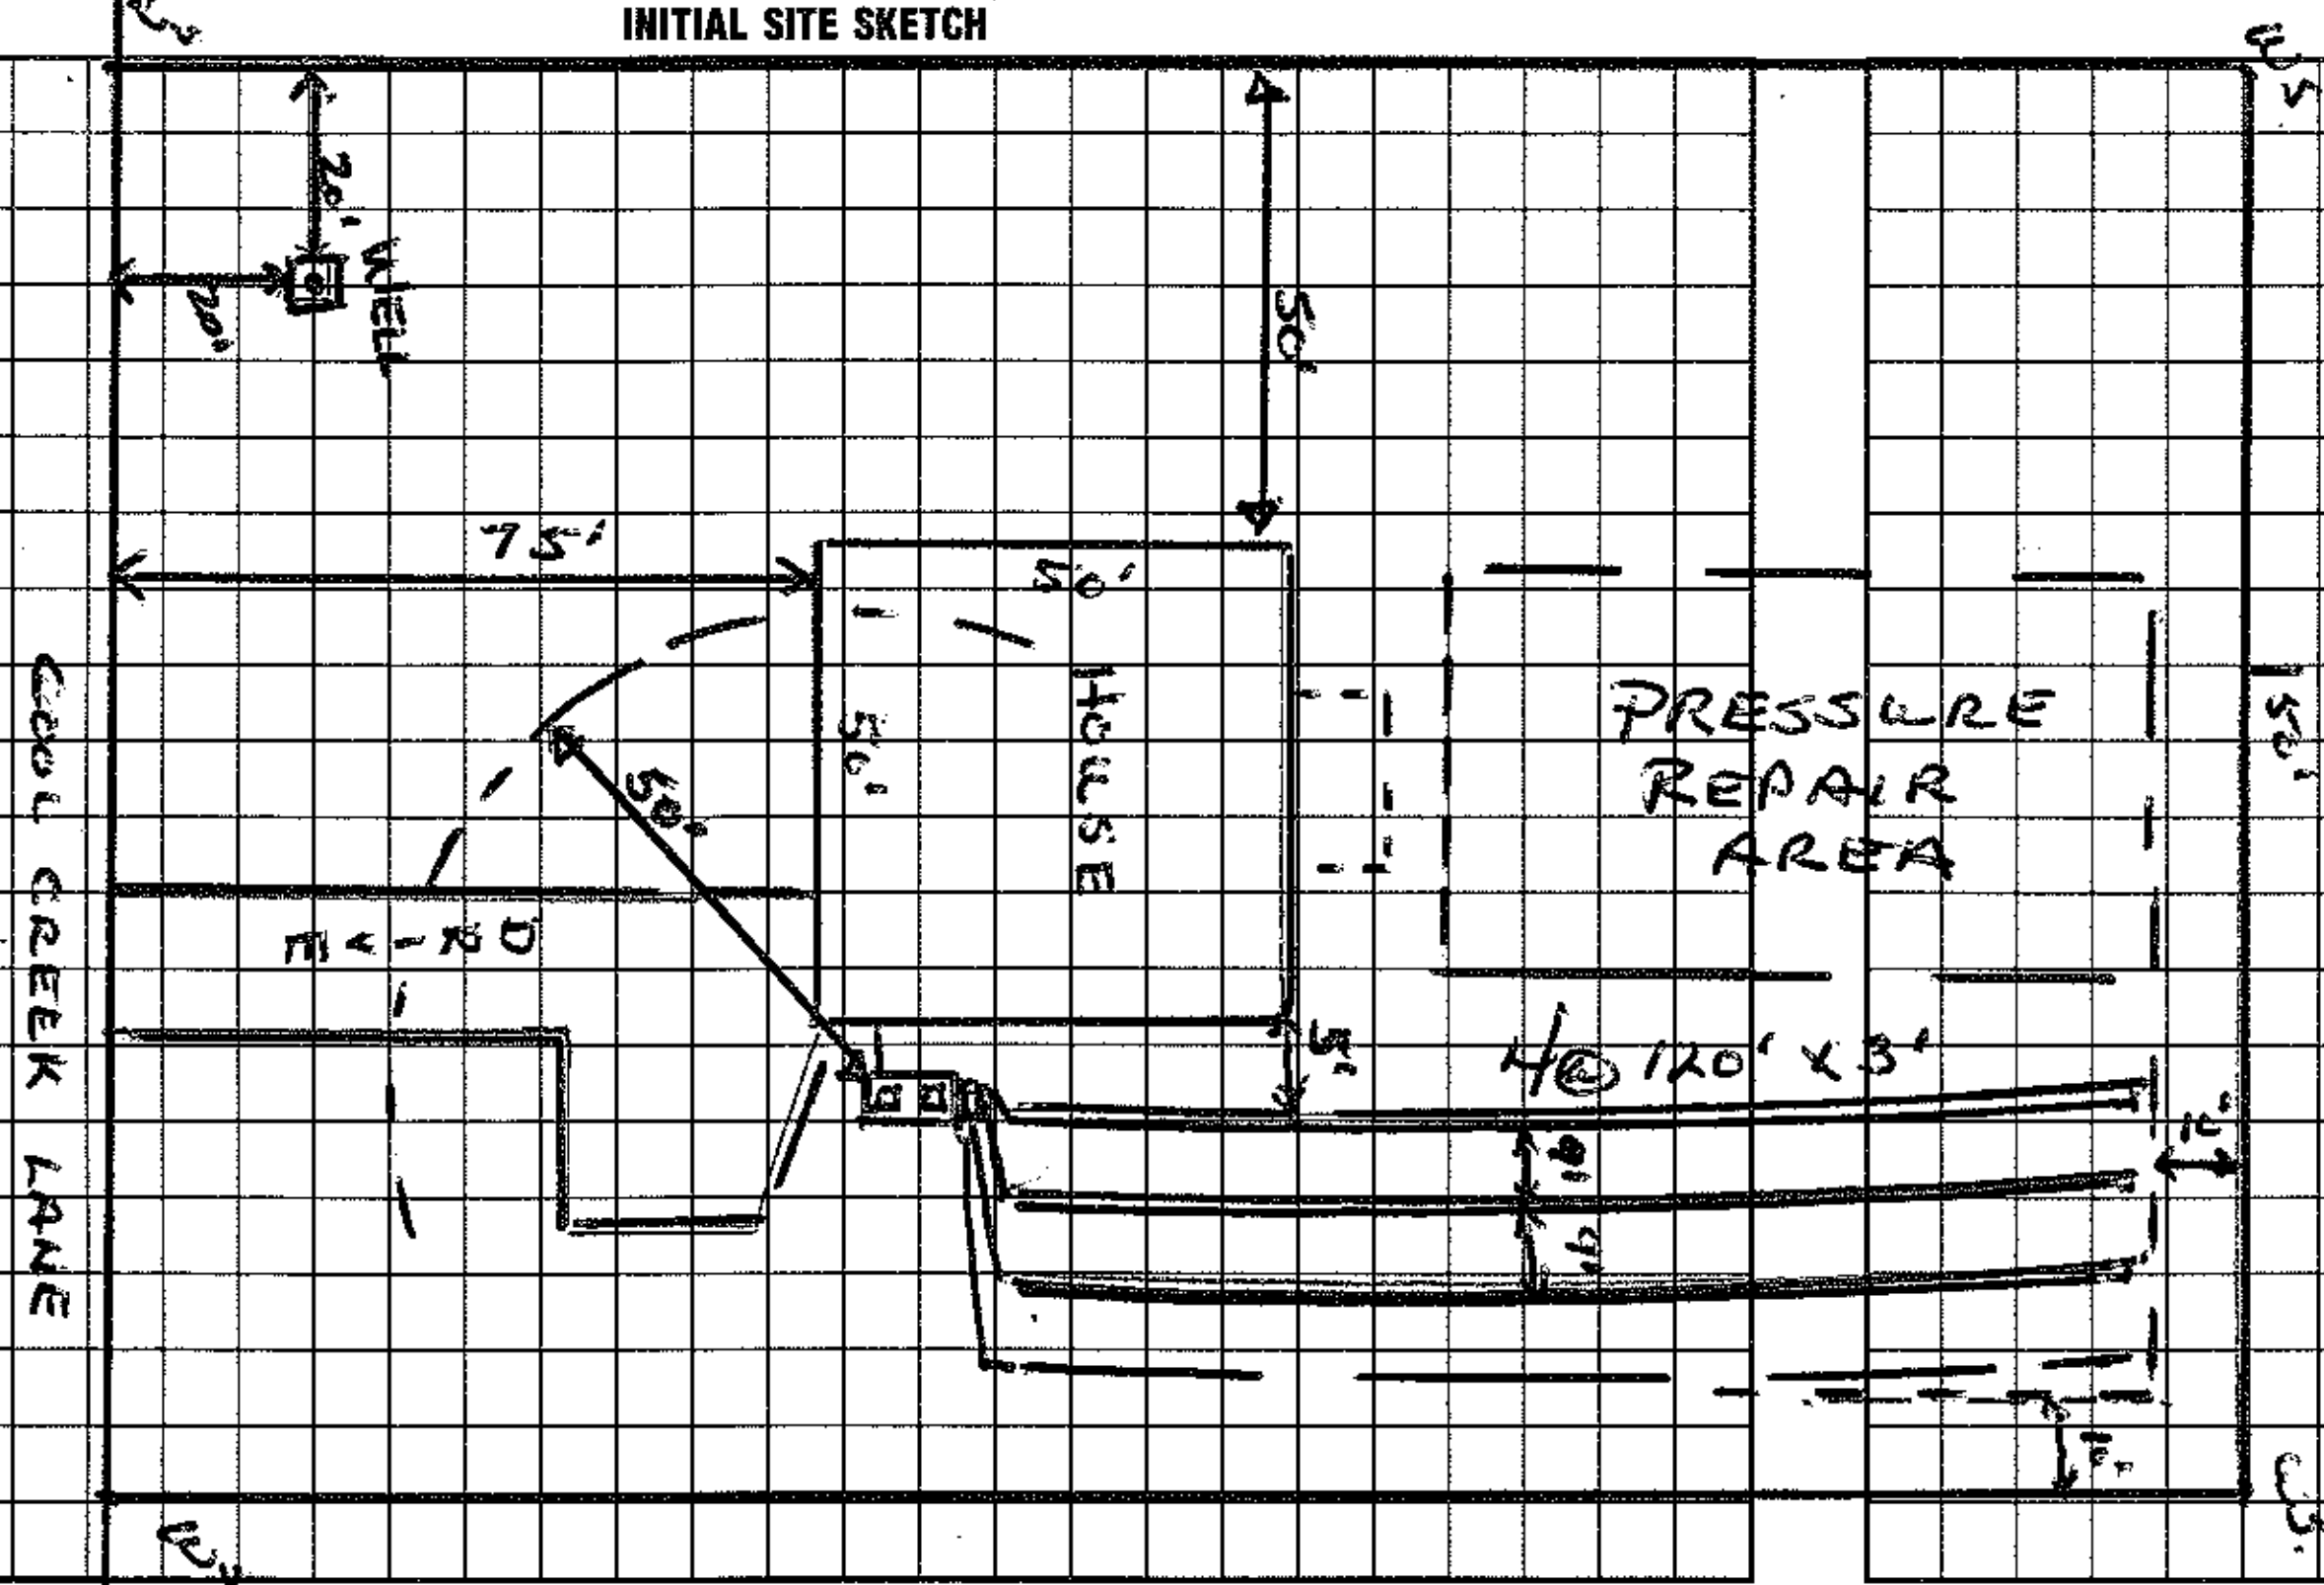

AS BUILT SKETCH

I understand that this permit can be suspended or revoked if any false information is supplied toward securing the permit/any unauthorized changes are made to the site/any unauthorized changes are made in the installation of the system. Improvement Permit is valid for 60 months from date of issuance.

Signed: * [signature]

Improvement Permit by: Wesley Sparks RS date 2/5/97

~~Existing System Inspection~~ Auth. Const. by: Wesley Sparks RS date 2/5/97

Installed by: F.J. Ervin

Certificate of Completion by: Maria H. Dobson RS date 2/29/2000

Operation Permit by: Maria H. Dobson RS date 2/29/2000

HEALTH DEPT. COPY: WHITE INSPECTION COPY (FINAL): GREEN OWNER COPY (FINAL): YELLOW INSPECTION COPY (INITIAL): PINK OWNER COPY (INITIAL): GOLD