IREDELL COUNTY HEALTH DEPARTMENT

STATESVILLE 704-878-5305 MOORESVILLE 704-664-5281

4679496162

IMPROVEMENT PERMIT / CERTIFICATE OF COMPLETION / OPERATION PERMIT / EXISTING SYSTEM INSPECTION

PROPERTY DESCRIPTION NO. 21927 DATE Jan 12, '96 TAX MAP NO. part of 4H2A11 Watershed: ☐ Yes ☐ No

OWNER OR CONTRACTOR Keith CARROLL PHONE: Business _____ Home _____

ADDRESS 795 French Belk Rd, Mt Ulla

LOCATION Triplett Rd Turn on Confederate Rd. TR Cool Creek Cr. on Right at end.

SUBDIVISION Twin Brooks BLOCK / SECTION _____ LOT 7 Revised LOT AREA 1.23 AC SITE CLASS PS DESIGN FLOW 360gpd L.T.A.R. .3

Septic Tank: 1000 Gallons; STB 794 Date 6/12/96
Pump Tank: _____ Gallons; PT _____ Date _____
Pump Make: _____ Model _____ Serial No. _____
Nitrification Field: No. Fields 1 Square Feet 1200 Linear Feet 400
No. Lines 4@100' Trench Width 36" Max Trench Bottom Depth 24"

☑ New System ☐ Repair System Type: I (II, III, IV, V, VI)
System Description: Shallow gravity conventional
Repair System Description: same & pumped conv.
Maintenance Agreement Required: ☐ Yes ☐ No
Gravel Depth 12"

☑ House/Mod. Home No. Bedrooms 3
☐ Mobile Home No. Bathrooms 2
☐ Business No. Employees _____
☐ Other _____
☐ Slab ☑ Crawl Space ☐ Basement w/plumbing ☐ Basement wo/plumbing


Water Supply:
☑ Individual
☐ Community
☐ Public

Comments: Plumbing must exit above existing grade. Backfill against foundation. KEEP LATERALS SHALLOW


Comments:

1"=60'

INITIAL SITE SKETCH

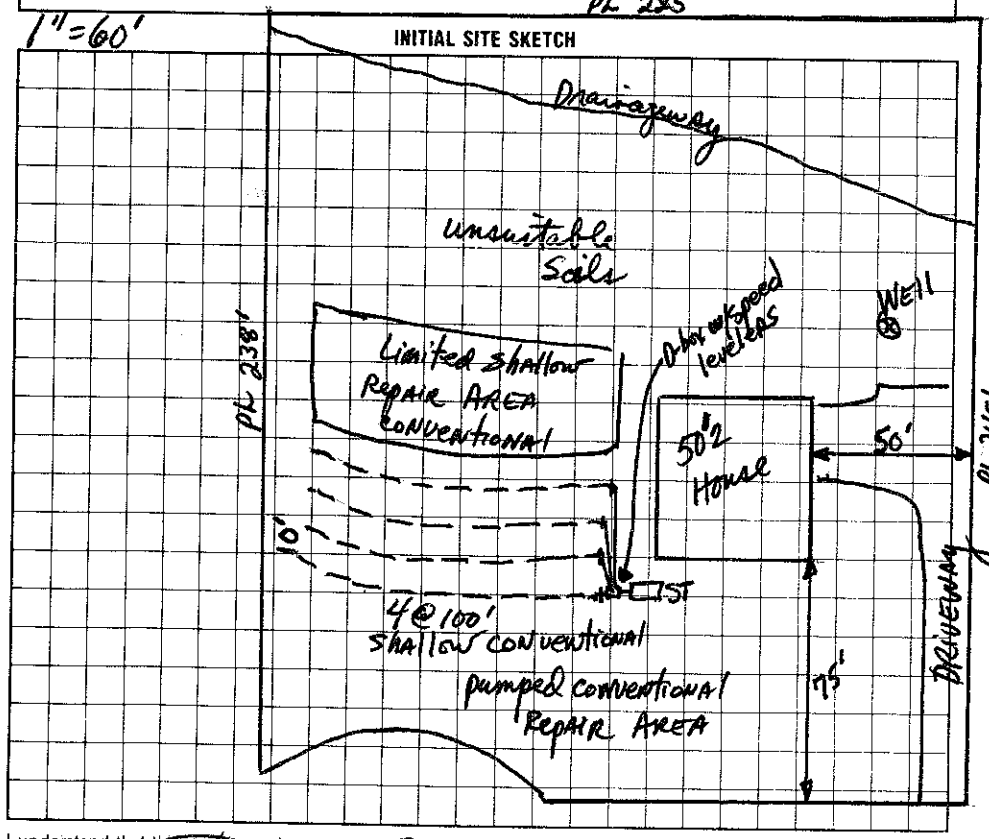

AS BUILT SKETCH

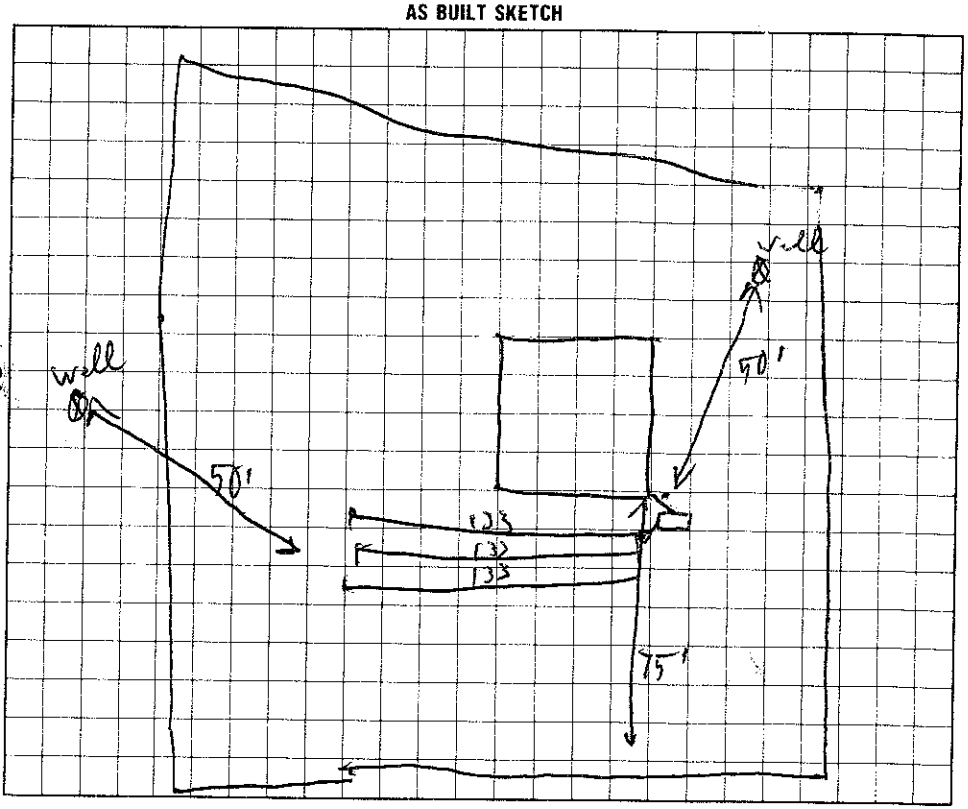

I understand that this permit can be suspended or revoked if any false information is supplied toward securing the permit/any unauthorized changes are made to the site/any unauthorized changes are made in the installation of the system.

Signed: Keith Carroll

Improvement Permit by: Howard Hinson, RS date Jan 12, '96

Existing System Inspection by: Howard Hinson, RS date Jan 12, '96

Authorization to construct

Installed by: Larry Tucker Septic Service

Certificate of Completion by: _____ date _____

Operation Permit by: C. Ball Jr. EHST date 8/6/96

HEALTH DEPT. COPY: WHITE INSPECTION COPY (FINAL): GREEN OWNER COPY (FINAL): YELLOW INSPECTION COPY (INITIAL): PINK OWNER COPY (INITIAL): GOLD