IREDELL COUNTY HEALTH DEPARTMENT

Authorization to Construct 4679496532

STATESVILLE 704-878-5305 MOORESVILLE 704-664-5281

IMPROVEMENT PERMIT / ~~CERTIFICATE OF COMPLETION~~ / OPERATION PERMIT / EXISTING SYSTEM INSPECTION

PROPERTY DESCRIPTION NO. 23322 DATE 3/27/96 TAX MAP NO. 4E-2-A-13 Watershed: ☐ Yes ☑ No

OWNER OR CONTRACTOR Keith Carroll PHONE: Business Home 664-1155

ADDRESS 745 French Belk Rd Mt Ulla NC 28125

LOCATION 115 S - Mocksville TR - TL Triplett Rd - TR Confederate - TR Twin Brooks

SUBDIVISION Twin Brooks BLOCK / SECTION 2 LOT 12 LOT AREA .904 ac SITE CLASS PS DESIGN FLOW 360 L.T.A.R. .3 gpd/ft²

Septic Tank: 1000 Gallons; STB 794 Date 9/10/96

Pump Tank: _____ Gallons; PT _____ Date _____

Pump Make: _____ Model _____ Serial No. _____

Nitrification Field: No Fields 1 Square Feet 280 Linear Feet 408

No Lines 3 Trench Width 36" Max Trench Bottom Depth ~~36"~~ 34" Gravel Depth 12"

☑ New System ☐ Repair System Type: I II III IV V VI

System Description: Gravity Conventional

Repair System Description: Pump Chamber

Maintenance Agreement Required: ☐ Yes ☑ No

☐ Slab ☑ Crawl Space ☐ Basement w/plumbing ☐ Basement wo/plumbing

☑ House/Mod. Home No. Bedrooms 3

☐ Mobile Home No. Bathrooms 2

☐ Business No. Employees _____


☐ Other _____

Water Supply:
☑ Individual
☐ Community
☐ Public


Comments:

Comments: WELL IS 50' 1" FROM UPPER LINE OF SEPTIC SYSTEM.

INITIAL SITE SKETCH

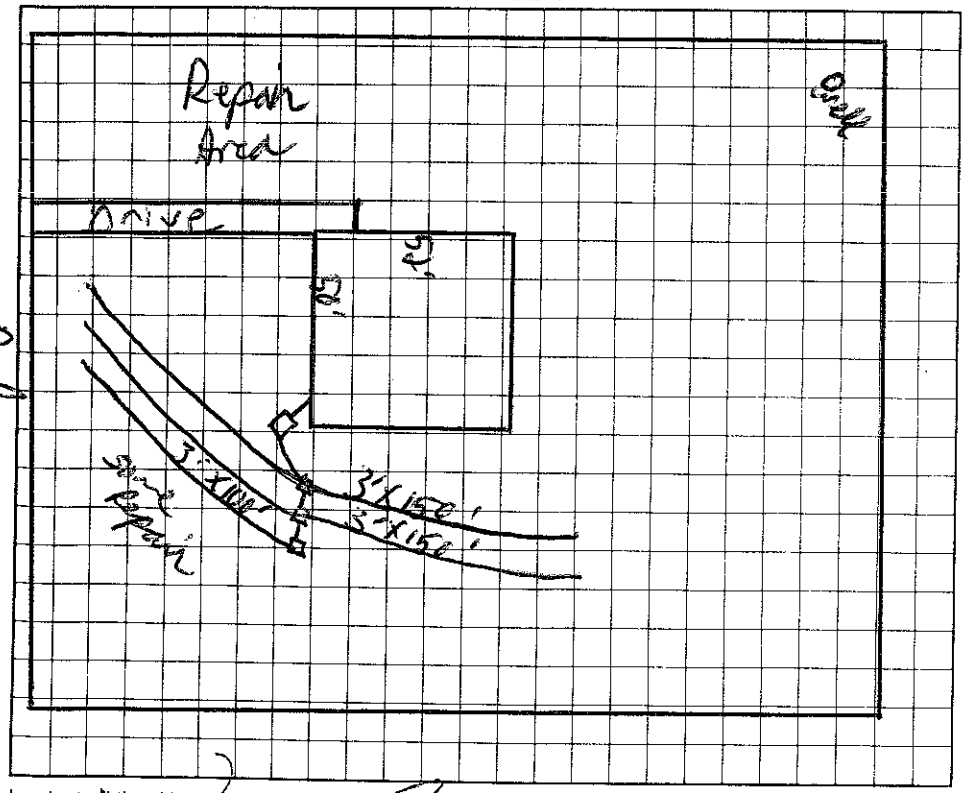

AS BUILT SKETCH

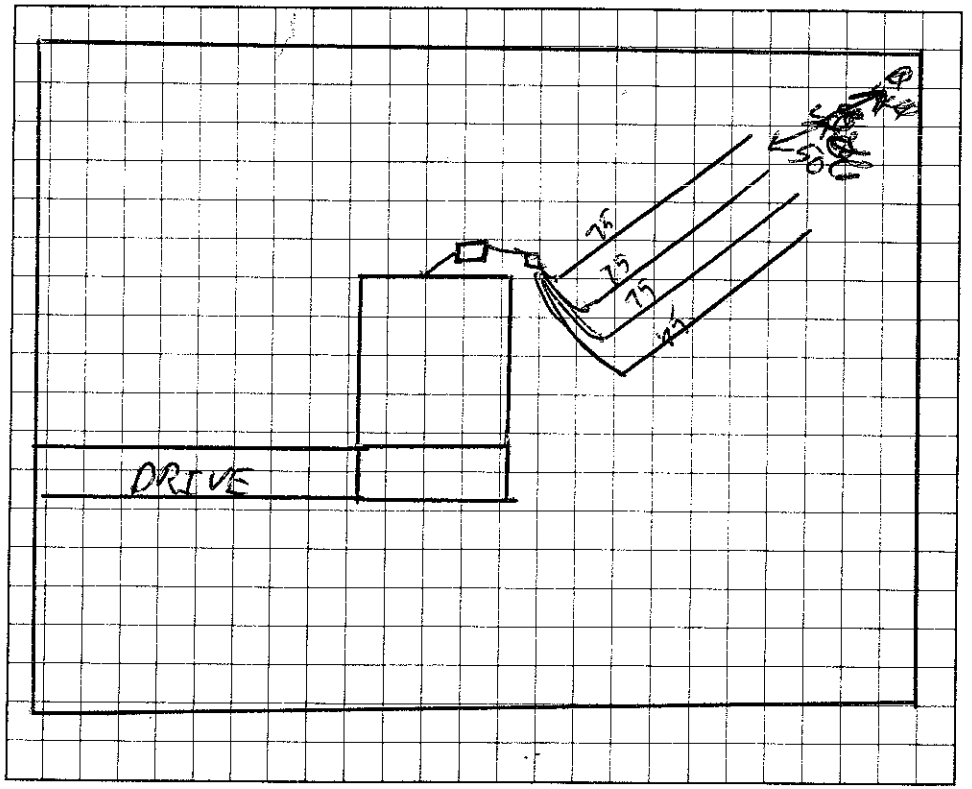

I understand that this permit can be suspended or revoked if any false information is supplied toward securing the permit/any unauthorized changes are made to the site/any unauthorized changes are made in the installation of the system.

Signed _____

Improvement Permit by: _____ date 3/27/96

Authorization to Construct by: C. Bridgeman EHS date 3/27/96

Existing System Inspection by: _____ date _____

Installed by: LARRY TUCKER

Certificate of Completion by: _____ date _____

Operation Permit by: C. Bridgeman date 10/3/96

HEALTH DEPT. COPY: WHITE INSPECTION COPY (FINAL): GREEN OWNER COPY (FINAL): YELLOW INSPECTION COPY (INITIAL): PINK OWNER COPY (INITIAL): GOLD

Authorization to Construct is valid for 60 mos. from date of issue