IREDELL COUNTY HEALTH DEPARTMENT

Authorization 4679497316

STATESVILLE 704-878-5305 MOORESVILLE 704-664-5281

IMPROVEMENT PERMIT / ~~CERTIFICATE OF COMPLETION~~ / OPERATION PERMIT / EXISTING SYSTEM INSPECTION

PROPERTY DESCRIPTION NO. 23321 DATE 3/26/96 TAX MAP NO. 4E-2-1-13 pt of

OWNER OR CONTRACTOR Keith Carroll PHONE: Business Home 664-1155 Watershed: ☐ Yes ☒ ~~No~~

ADDRESS 195 French Bell Rd - Mt Ulla NC 28125

LOCATION Triplett Rd - TR Confederate Rd - TR coal cracked - lot on left

SUBDIVISION Twin Brooks BLOCK / SECTION LOT 11 LOT AREA .904 ac SITE CLASS PS DESIGN FLOW ~~225~~ 360 L.T.A.R. .13 gpd/ft²

Septic Tank: 1000 Gallons; STB 825 Date 9/1/96

Pump Tank: Gallons; PT Date

Pump Make: Model Serial No.

Nitrification Field: No Fields 1 Square Feet 900 Linear Feet 300

No Lines 3 Trench Width 36" Max Trench Bottom Depth 36" Gravel Depth 12"

☑ New System ☐ Repair System Type: I. II. III. IV. V. VI

System Description: Gravity Chambered

Repair System Description: Same

Maintenance Agreement Required: ☐ Yes ☑ No

☑ House/Mod. Home No. Bedrooms 3

☐ Mobile Home No. Bathrooms 2

☐ Business No. Employees

☐ Other


☐ Slab ☑ Crawl Space ☐ Basement w/plumbing ☐ Basement wo/plumbing

Water Supply: ☒ ~~Individual~~ ☐ Community ☐ Public


Comments:

Comments:

INITIAL SITE SKETCH

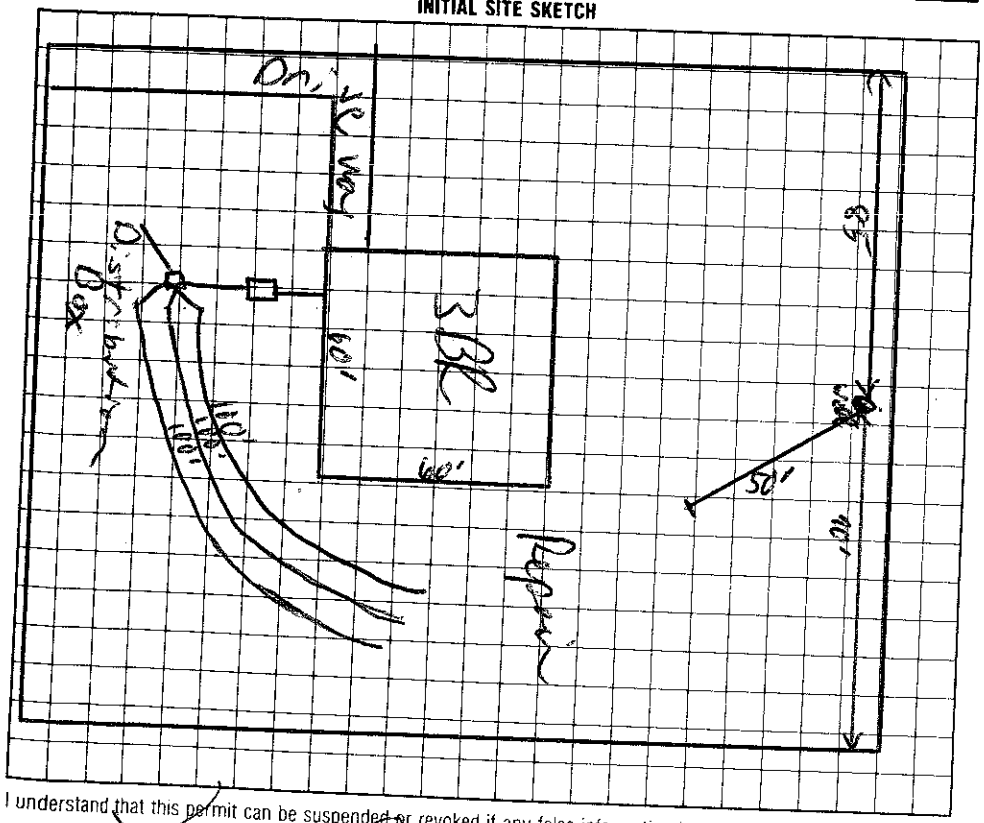

AS BUILT SKETCH

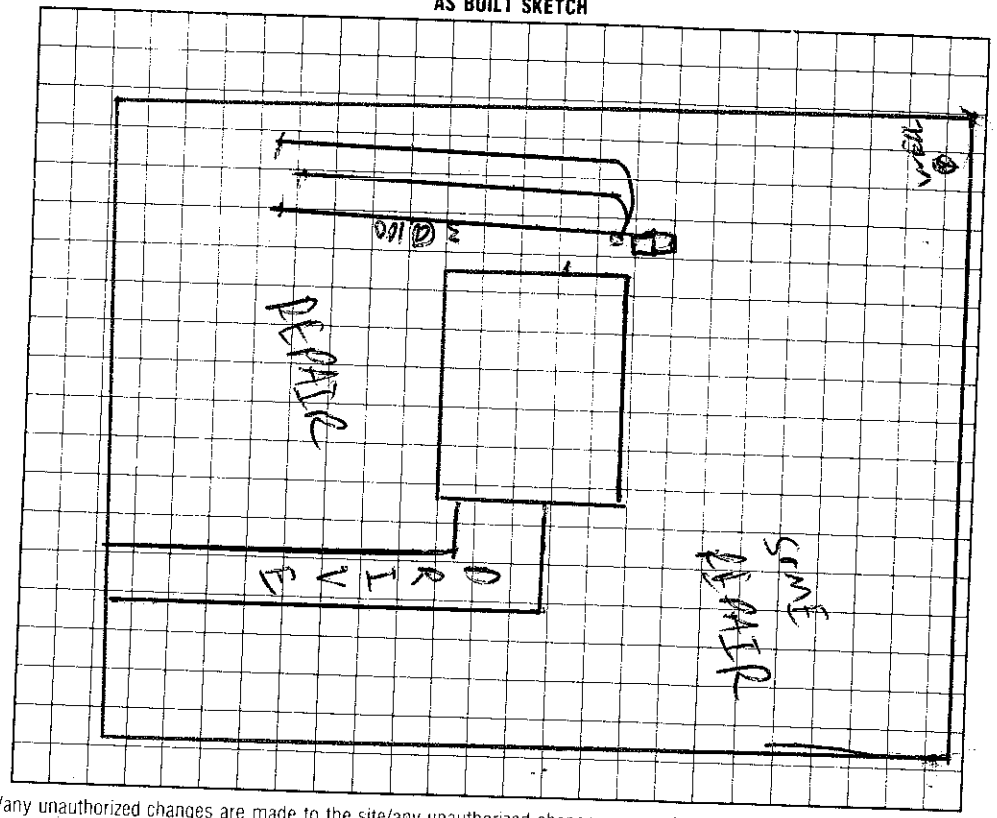

I understand that this permit can be suspended or revoked if any false information is supplied toward securing the permit/any unauthorized changes are made to the site/any unauthorized changes are made in the installation of the system.

Signed: Keith Carroll

Improvement Permit by: C. Brightman EHST date 3/26/96

Existing System Inspection by: C. Brightman EHST date 3/26/96

Installed by: MYERS SEPTIC

Certificate of Completion by: date

Operation Permit by: C. Brightman EHST date 11/13/96

HEALTH DEPT. COPY: WHITE INSPECTION COPY (FINAL): GREEN OWNER COPY (FINAL): YELLOW INSPECTION COPY (INITIAL): PINK OWNER COPY (INITIAL): GOLD

Authorization to Construct is valid for 60 months from date of issue.