IREDELL COUNTY HEALTH DEPARTMENT

Statesville Office (704) 878-5305 Mooresville Office (704) 660-3625 (10580) PERMIT # 179595

IMPROVEMENT PERMIT / AUTHORIZATION TO CONSTRUCT / OPERATION PERMIT / EXISTING SYSTEM

PIN # 4679506442

APPLICANT: CLAYTON HOMES APPLICANT ADDRESS: 1230 CONOVER BLVD - CONOVER NC

SITE ADDRESS: 259 WIGGINS RD PHONE: ALT. PHONE:

SITE DIRECTIONS: 150 E - TL WIGGINS RD - ON RT - # 259 WIGGINS

SUBDIVISION: — SECTION: — LOT # — LOT AREA: 2 AC DESIGN FLOW: 480 GPD L.T.A.R.: .3

Septic Tank 1000 (gal) STB 780 Date 3-1
Pump Tank (gal) PT Date
Pump Make Model Serial #
Nitrification Fields 1 # Lines 4 Linear Ft: 400
Trench Width 36" Max. Trench Bottom Depth 36" Gravel Depth N/A

☑ New System ☐ Repair ☐ Expansion System Type: I II (III) IV V VI
System Description: GRAVITY 25% RED.
Repair System Description: LA PAIRS
Maintenance Agreement Required: ☐ YES ☑ NO
☑ GRAVITY ☐ PRESSURE

☑ Residence No. Bedrooms 4
☐ Business No. Persons 8
☐ Other No. Employees
☐ Slab ☑ Crawl Space
☐ Basement w/plumbing ☐ Basement w/o plumbing

Water Supply: ☑ Private ☐ Public ☐ Community

Comments / Conditions:

INITIAL SITE SKETCH

SEE ROLLANS SOIL & ENVIRONMENTAL'S PLAN

AS BUILT SKETCH

SUBMITTED AS DRAWN

Permit can be suspended or revoked if any false information is supplied toward securing the permit / any unauthorized changes are made to the site / any unauthorized changes are made in the installation of the system. **CONTACT A LOCATOR SERVICE PRIOR TO ANY EXCAVATION**

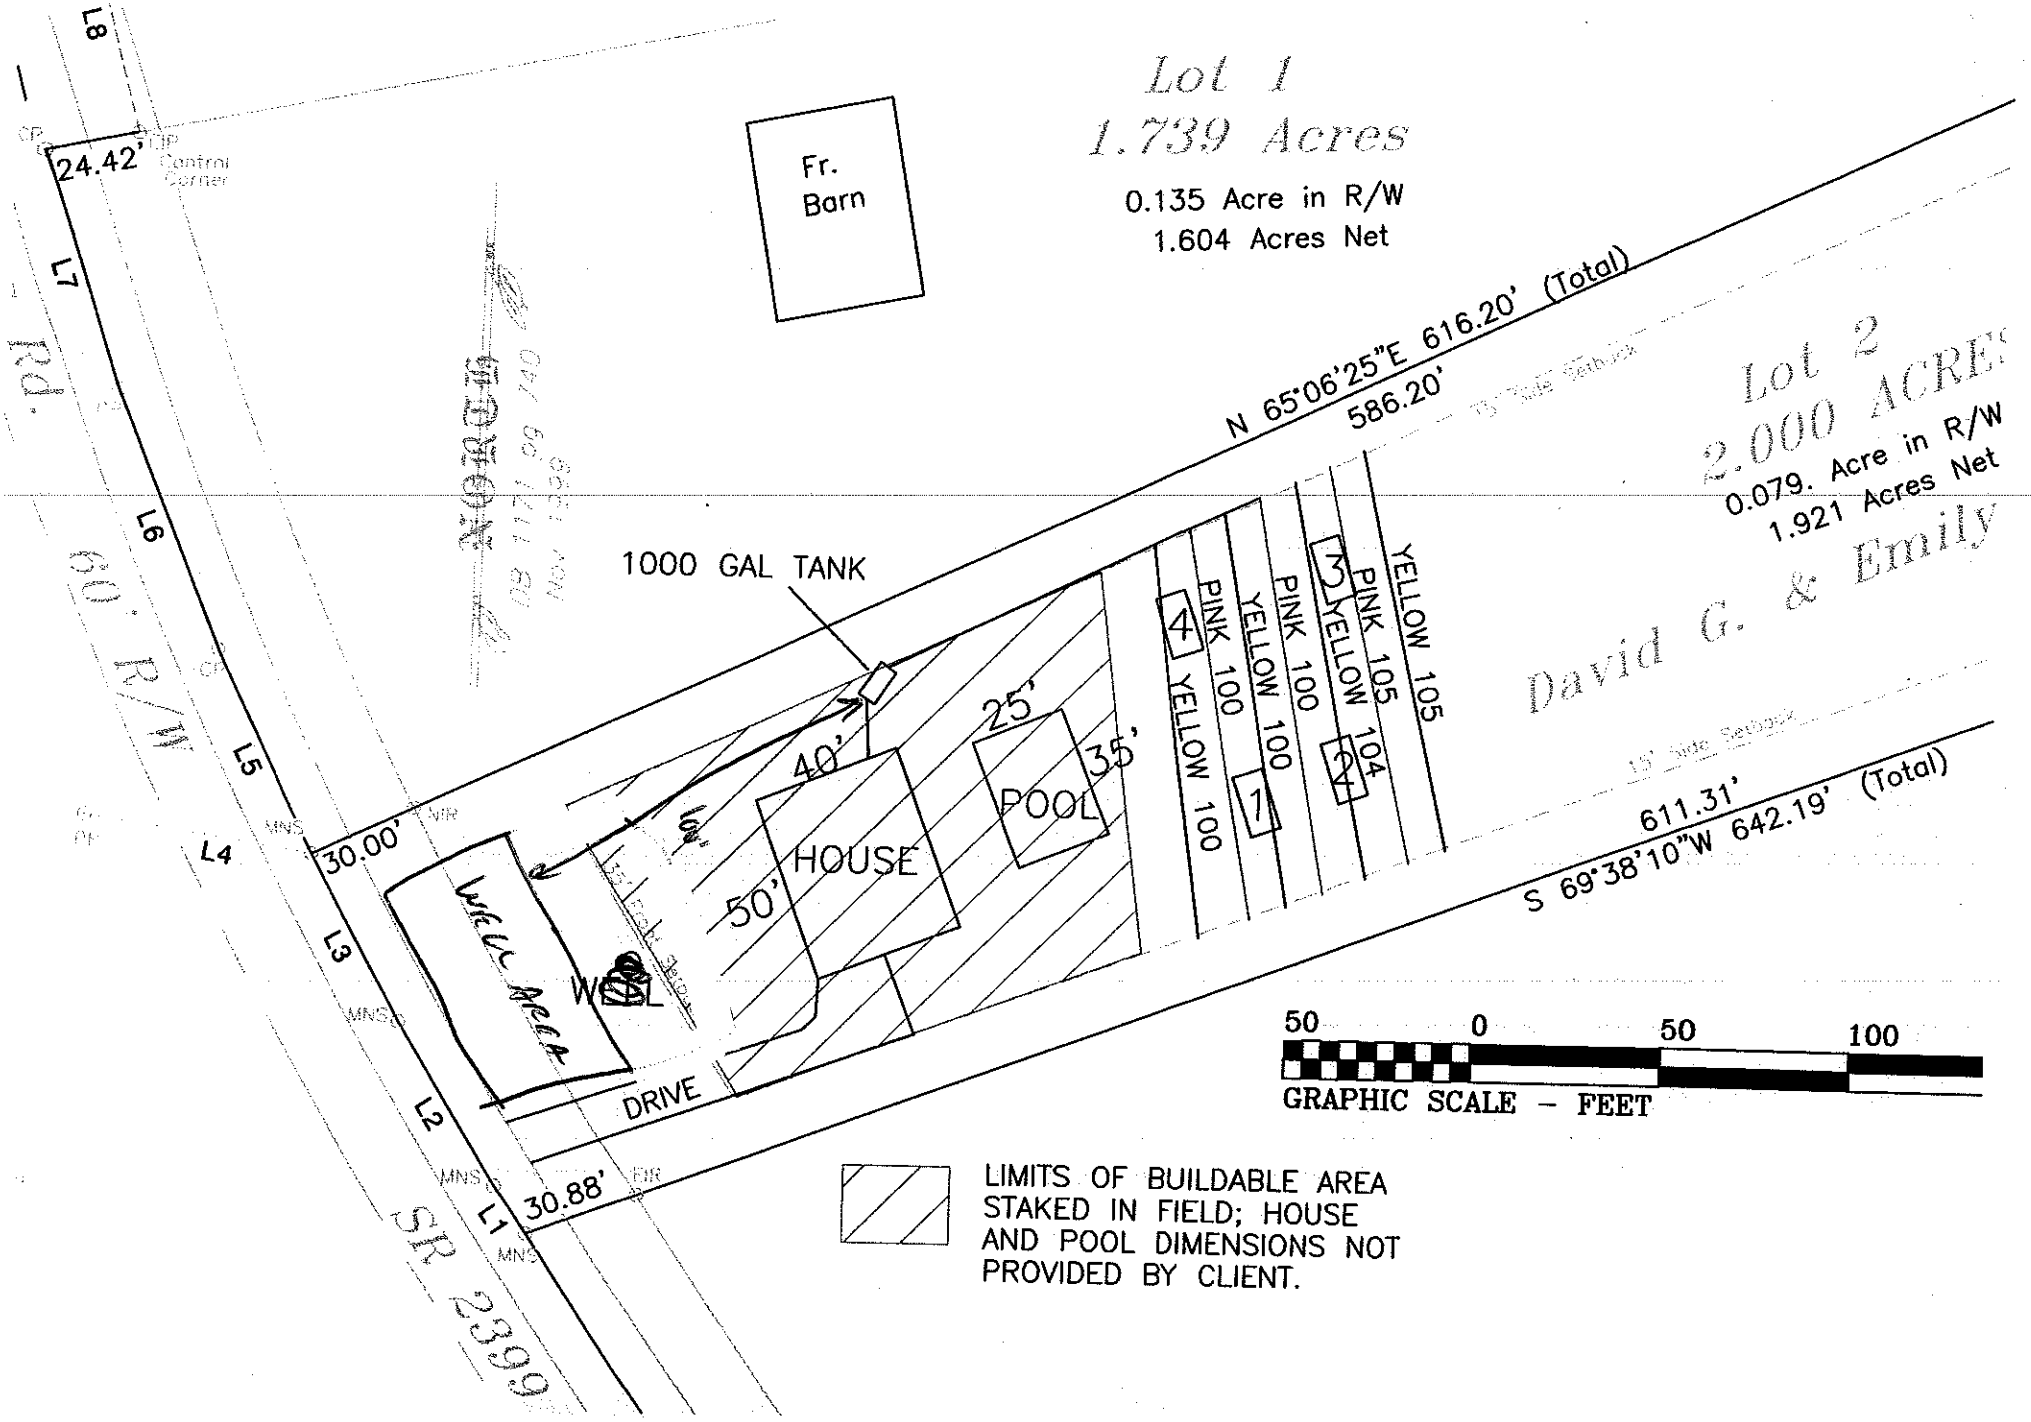
☐ **IMPROVEMENT PERMIT** *with plat valid without expiration.* ☑ **IMPROVEMENT PERMIT** *with site plan valid for 60 mos.* ☑ **AUTHORIZATION TO CONSTRUCT** *valid for period equal to IMPROVEMENT PERMIT--not to exceed 60 mo.*

Owner / Applicant Signature: Date: 7/3/13 Installed by: MATT BEAVER / MRB

IMPROVEMENT PERMIT by: Date: 7/3/13 OPERATION PERMIT by: Date: 7/24/13

AUTHORIZATION TO CONSTRUCT by: Date: 7/3/13 Existing System Inspected by: Date:

Health Dept. Copy - WHITE Applicant (Final Approval) - YELLOW Applicant (Conditional Approval) - PINK


Lot 1
1.739 Acres
0.135 Acre in R/W
1.604 Acres Net
Fr. Barn
24.42'
Control Corner
L8
L7
L6
L5
L4
L3
L2
L1
60' R/W
SR 2399
N 65°06'25"E 616.20' (Total)
586.20'
Lot 2
2.000 ACRES
0.079. Acre in R/W
1.921 Acres Net
David G. & Emily
1000 GAL TANK
40'
25'
35'
50'
HOUSE
POOL
WELL
Well Area
DRIVE
30.00'
30.88'
611.31'
S 69°38'10"W 642.19' (Total)
4 YELLOW 100
PINK 100
YELLOW 100
1
PINK 100
YELLOW 100
2
3 YELLOW 104
PINK 105
YELLOW 105
50 0 50 100
GRAPHIC SCALE – FEET
LIMITS OF BUILDABLE AREA STAKED IN FIELD; HOUSE AND POOL DIMENSIONS NOT PROVIDED BY CLIENT.