IREDELL COUNTY HEALTH DEPARTMENT

STATESVILLE 704-878-5305 $130 MOORESVILLE 704-664-5281

IMPROVEMENT PERMIT / AUTHORIZATION TO CONSTRUCT / OPERATION PERMIT / EXISTING SYSTEM INSPECTION

PERMIT# 125615 PIN# 4679-60-0562 4679-50-9472 DATE 12/23/04

OWNER OR CONTRACTOR Larry Beam Jr. PHONE: Business 704-634-5248 Home

ADDRESS 221 Wiggins Rd Mooresville NC 28115

LOCATION HWY 801, TR Wiggins, on Lt #253

SUBDIVISION BLOCK / SECTION LOT LOT AREA 5.12 AC SITE CLASS. PS DESIGN FLOW 360 L.T.A.R. 0.3

Septic Tank: 1000 Gallons; STB 312 Date 10/03/04
Pump Tank: 1000 Gallons; PT 283 Date 6/22/05
Pump Make: Model Serial No.
Nitrification Field: No Fields 1 Square Feet 1200 Linear Feet 400'
No Lines 3@133' Trench Width 36" Max Trench Bottom Depth 36" Gravel Depth 12"

☒ New System ☐ Repair System Type: I, II, (III), IV, V, VI
System Description: PM Conventional
Repair System Description: Same
Maintenance Agreement Required: ☐ Yes ☒ No

☒ House/Mod. Home No. Bedrooms 3
☐ Mobile Home No. Bathrooms
☐ Business No. Employees
☐ Other

☐ Slab ☐ Crawl Space ☒ Basement w/plumbing ☐ Basement wo/plumbing


Water Supply:
☒ Individual
☐ Public
☐ Community

Comments:/Conditions:


Not to Scale

Comments:/Conditions:

INITIAL SITE SKETCH

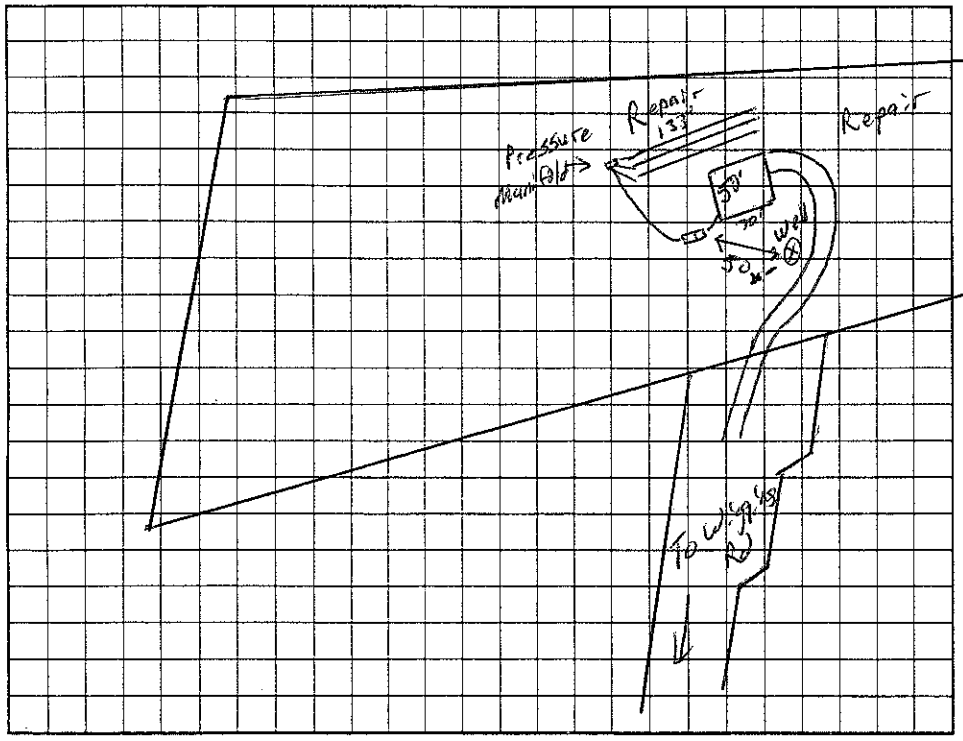

AS BUILT SKETCH

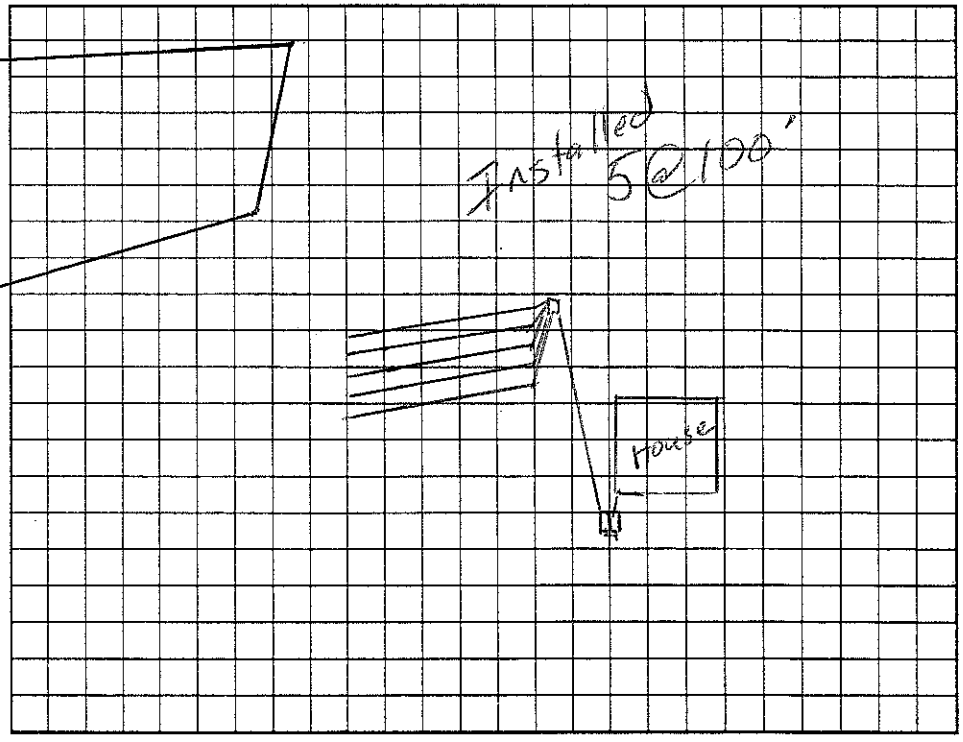

Permit can be suspended or revoked if any false information is supplied toward securing the permit/any unauthorized changes are made to the site/any unauthorized changes are made in the installation of the system. Improvement Permit with plat valid without expiration. Improvement Permit with site plan valid for sixty months. Authorization to Construct is valid for a period equal to that of Improvement Permit – not to exceed sixty months.

Signed: Larry E Beam Jr date 12-23-04 Installed by: Larry Beam

Improvement Permit by: RS date 12/23/04 Operation Permit by: RS date 8/10/05

Authorization to Construct by: RS date 12/23/04 Existing System Inspection by: date

HEALTH DEPT. COPY: WHITE OWNER COPY (FINAL): YELLOW OWNER COPY (INITIAL): PINK