IREDELL COUNTY HEALTH DEPARTMENT

STATESVILLE 704-878-5305 MOORESVILLE 704-664-5281

IMPROVEMENT PERMIT / AUTHORIZATION TO CONSTRUCT / OPERATION PERMIT / EXISTING SYSTEM INSPECTION

PERMIT# Repair PIN# 4679 51 1826 DATE 8/15/01

OWNER OR CONTRACTOR Winnie McNeely PHONE: Business Home 663 1499

ADDRESS 189 Wiggins Rd Mooresville NC 28115

LOCATION 801 N, 3rd R Wiggins Rd, on Lt

SUBDIVISION BLOCK / SECTION LOT LOT AREA SITE CLASS. PS DESIGN FLOW 240 L.T.A.R. 0.4

Septic Tank: Existing Gallons; STB Date

Pump Tank: Gallons; PT Date

Pump Make: Model Serial No.

Nitrification Field: No Fields 1 Square Feet 600 Linear Feet 200

No Lines 3 or 4 Trench Width 36" Max Trench Bottom Depth 36" Gravel Depth 12

☐ New System ☒ Repair System Type: I (II) III, IV, V, VI

System Description:

Repair System Description: Gravity Conventional

Maintenance Agreement Required: ☐ Yes ☑ No

☒ House/Mod. Home No. Bedrooms 2

☐ Mobile Home No. Bathrooms 1

☐ Business No. Employees

☐ Other


☐ Slab ☐ Crawl Space ☐ Basement w/plumbing ☒ Basement wo/plumbing

Water Supply: ☒ Individual ☐ Public ☐ Community

Comments:/Conditions: Existing Tank - replace tee if needed
Can Install New
Tank (Owner Opt.) if needed

Comments:/Conditions: No Foundation Drain
2@160'x3' Conventional

INITIAL SITE SKETCH

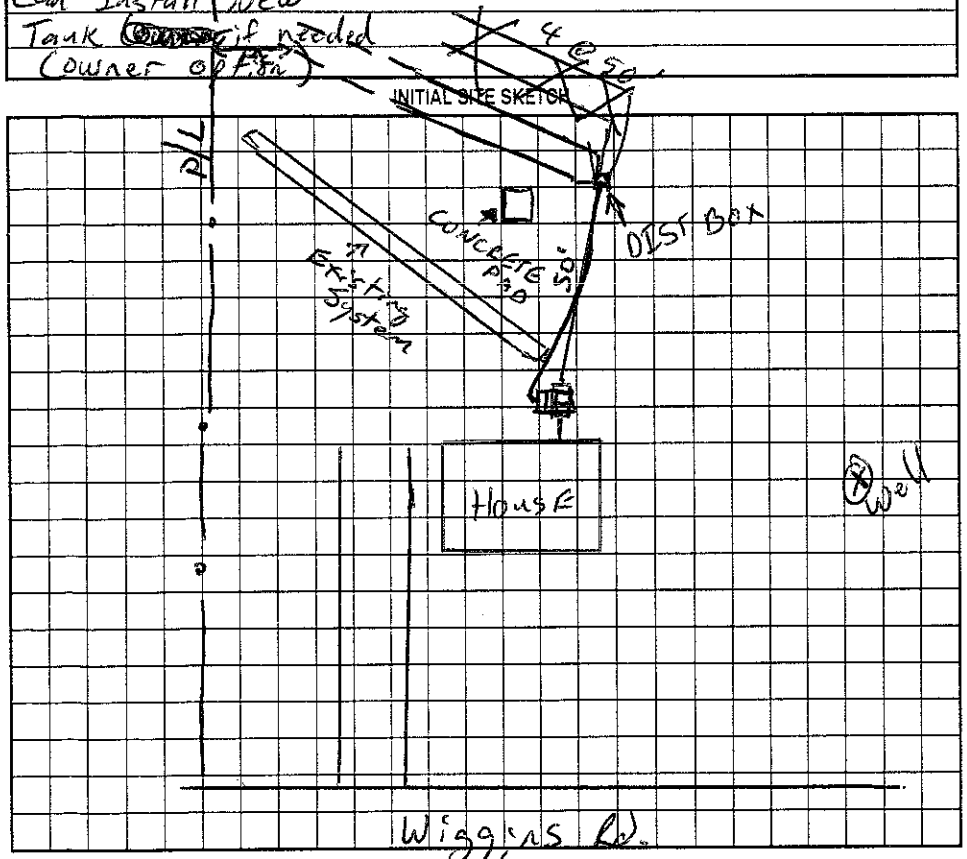

AS BUILT SKETCH

Permit can be suspended or revoked if any false information is supplied toward securing the permit/any unauthorized changes are made to the site/any unauthorized changes are made in the installation of the system. Improvement Permit with plat valid without expiration. Improvement Permit with site plan valid for sixty months. Authorization to Construct is valid for a period equal to that of Improvement Permit -- not to exceed sixty months.

Signed: date 8/15/01 Installed by: Larry Beam

Improvement Permit by: CS date 8/15/01 Operation Permit by: Wesley Sparks RS. date 8/16/01

Authorization to Construct by: CS date 8/15/01 Existing System Inspection by: date

HEALTH DEPT. COPY: WHITE OWNER COPY (FINAL): YELLOW OWNER COPY (INITIAL): PINK