IREDELL COUNTY HEALTH DEPARTMENT

Statesville Office (704) 878-5305 Mooresville Office (704) 660-3625 PERMIT # 209389

IMPROVEMENT PERMIT / AUTHORIZATION TO CONSTRUCT / OPERATION PERMIT / EXISTING SYSTEM

PIN # 4679-51-2631.000

APPLICANT: Alan C Allman APPLICANT ADDRESS: 207 Wiggins Rd. Mooresville

SITE ADDRESS: 207 Wiggins Rd. Mooresville NC PHONE: 704-239-3175 ALT. PHONE:

SITE DIRECTIONS: 801 N from Hwy 150, TR Wiggins, Property on L

SUBDIVISION: — SECTION: — LOT # — LOT AREA: 4 Acre DESIGN FLOW: 480 GPD. L.T.A.R.: Existing

Septic Tank Existing (gal) STB Date

Pump Tank (gal) PT Date

Pump Make Model Serial #

Nitrification Fields Ex. 2 # Lines Ex. Linear Ft: Ex.

Trench Width Ex. Max. Trench Bottom Depth Ex. Gravel Depth Ex.

☐ New System ☐ Repair ☐ Expansion System Type: (II) III IV V VI

System Description: Existing Conventional

Repair System Description:

Maintenance Agreement Required: ☐ YES ☒ NO

☒ GRAVITY ☐ PRESSURE

☒ Residence No. Bedrooms 4

☐ Business No. Persons 8

☐ Other No. Employees


☐ Slab ☐ Crawl Space

☒ Basement w/plumbing ☐ Basement w/o plumbing


Water Supply: ☒ Private ☐ Public ☐ Community

Comments / Conditions: Mountain 25' from well and 3' from any septic with new storage building. Systems appeared to be functioning at time of inspection.

INITIAL SITE SKETCH

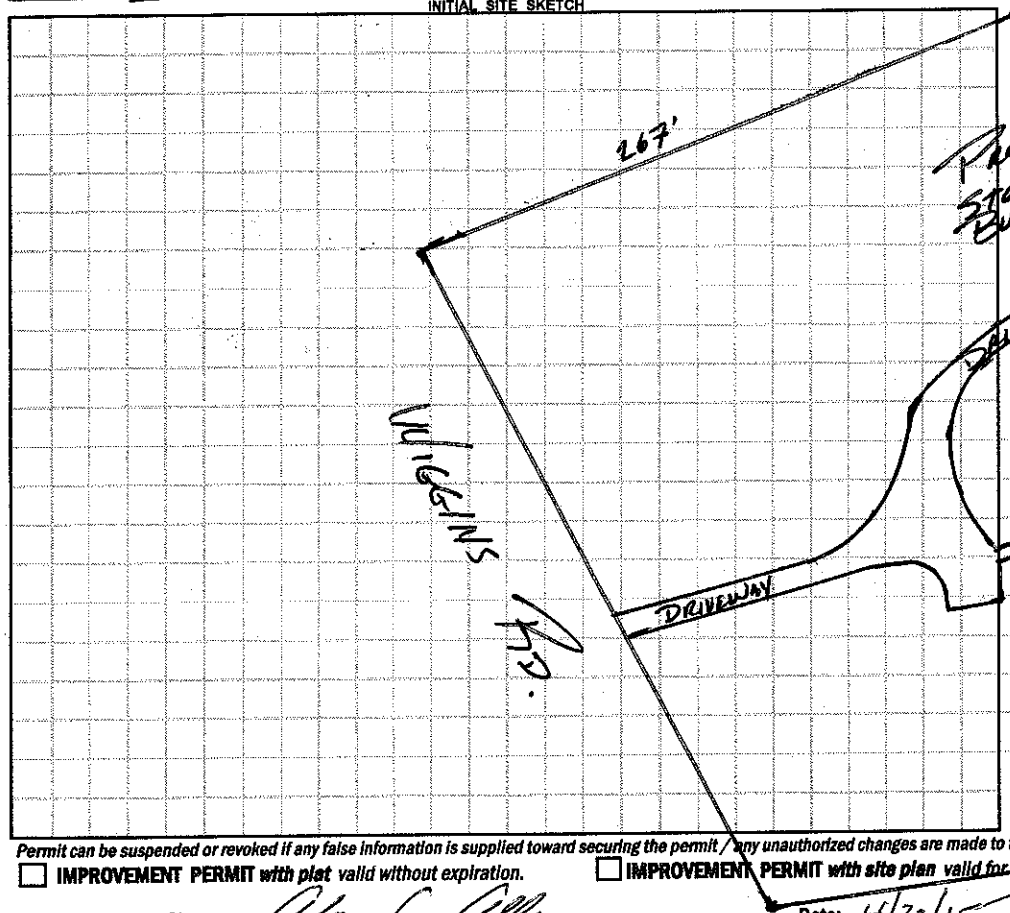

AS BUILT SKETCH

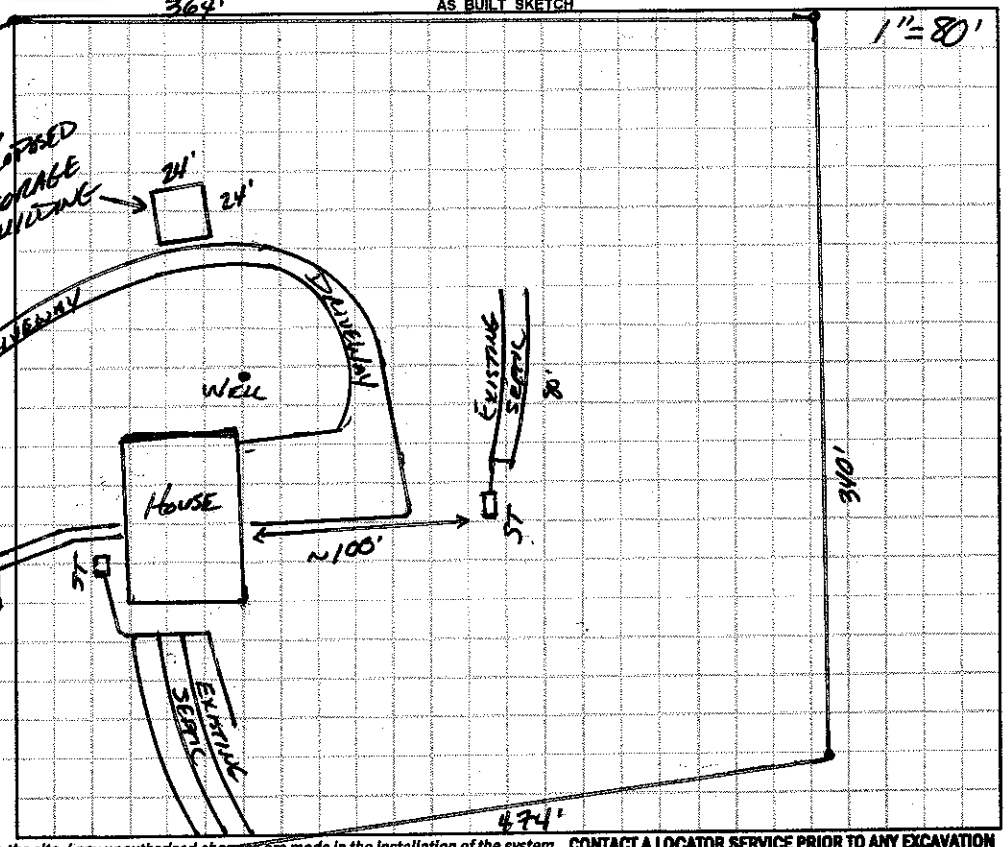

Permit can be suspended or revoked if any false information is supplied toward securing the permit / any unauthorized changes are made to the site / any unauthorized changes are made in the installation of the system. **CONTACT A LOCATOR SERVICE PRIOR TO ANY EXCAVATION**

☐ **IMPROVEMENT PERMIT** *with plat valid without expiration.* ☐ **IMPROVEMENT PERMIT** *with site plan valid for 60 mos.* ☐ **AUTHORIZATION TO CONSTRUCT** *valid for period equal to IMPROVEMENT PERMIT--not to exceed 60 mo.*

Owner / Applicant Signature: Alan C. Allman Date: 4/20/15 Installed by:

IMPROVEMENT PERMIT by: Date: OPERATION PERMIT by: Date:

AUTHORIZATION TO CONSTRUCT by: Date: Existing System Inspected by: APPROVED Date: APR 20 2015

Health Dept. Copy - WHITE Applicant (Final Approval) - YELLOW Applicant (Conditional Approval) - PINK