4679520079

IREDELL COUNTY HEALTH DEPARTMENT

STATESVILLE 704-878-5305 MOORESVILLE 704-664-5281

IMPROVEMENT PERMIT / CERTIFICATE OF COMPLETION / OPERATION PERMIT / EXISTING SYSTEM INSPECTION

PROPERTY DESCRIPTION NO. 19576 DATE 10/17/94 TAX MAP NO. 4CA 32 Watershed: ☐ Yes ☐ No

OWNER OR CONTRACTOR Mildred Wiles (Glen Bennett) PHONE: Business 662-6244 Home

ADDRESS Rt 8 Box 56 Mooresville, NC.

LOCATION Wiggins Rd 801 N TR ~1/2 mile on (L)

SUBDIVISION N/A BLOCK / SECTION LOT LOT AREA ~.5 ac. SITE CLASS. P DESIGN FLOW 360 L.T.A.R. N/A

Septic Tank: Exist Gallons; STB Date

Pump Tank: Gallons; PT Date

Pump Make: Model Serial No.

Nitrification Field: No Fields Square Feet Linear Feet

No Lines Trench Width Max Trench Bottom Depth Gravel Depth

☐ New System ☐ Repair System Type: I, II, III, IV, V, VI

System Description: Existing System

Repair System Description:

Maintenance Agreement Required: ☐ Yes ☑ No

☐ House/Mod. Home No. Bedrooms 3

☐ Mobile Home No. Bathrooms 2

☐ Business No. Employees

☐ Other

☐ Slab ☐ Crawl Space ☐ Basement w/plumbing ☐ Basement wo/plumbing


Water Supply:
☑ Individual
☐ Community
☐ Public
Homesite (R)

Comments:

Comments:

INITIAL SITE SKETCH

AS BUILT SKETCH

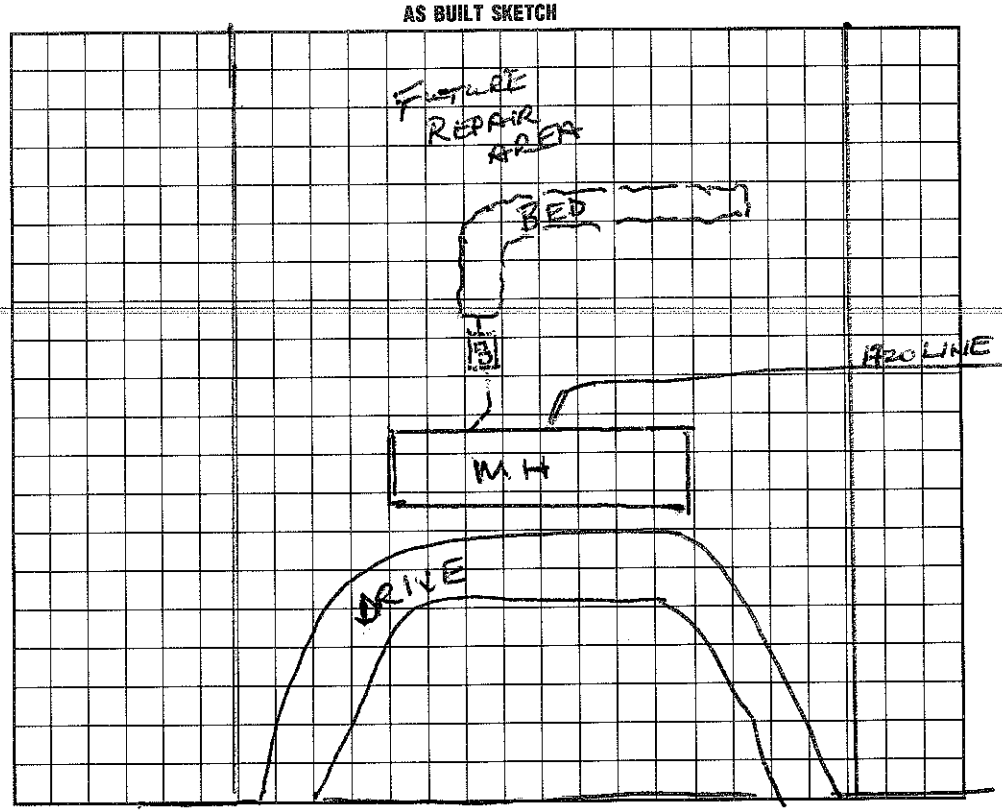

I understand that this permit can be suspended or revoked if any false information is supplied toward securing the permit/any unauthorized changes are made to the site/any unauthorized changes are made in the installation of the system. Improvement Permit is valid for 60 months from date of issuance.

WIGGINS RD.

Signed:

Improvement Permit by: date

Existing System Inspection by: Wesley Sparks RS. date 10/17/94

Installed by:

Certificate of Completion by: date

Operation Permit by: date

HEALTH DEPT. COPY: WHITE INSPECTION COPY (FINAL): GREEN OWNER COPY (FINAL): YELLOW INSPECTION COPY (INITIAL): PINK OWNER COPY (INITIAL): GOLD