IREDELL COUNTY HEALTH DEPARTMENT

STATESVILLE 704-878-5305 MOORESVILLE 704-664-5281

IMPROVEMENT PERMIT / AUTHORIZATION TO CONSTRUCT / OPERATION PERMIT / EXISTING SYSTEM INSPECTION

PERMIT# Repair PIN# N/A 4679520449 DATE 4/21/03

OWNER OR CONTRACTOR Melvin McLaughlin PHONE: Business Home 704-663-4386

ADDRESS 163 Wiggins Rd. Mooresville, NC.

LOCATION 301 N SR Wiggins Rd on D ct 163

SUBDIVISION No BLOCK / SECTION LOT LOT AREA EXISTING SITE CLASS PS DESIGN FLOW 360 L.T.A.R.

Septic Tank: 1000 Gallons; STB 760 Date 2-21-03
Pump Tank: Gallons; PT Date
Pump Make: Model Serial No.
Nitrification Field: No Fields Square Feet 900 Linear Feet 300
No Lines 3@100' Trench Width 3' Max Trench Bottom Depth 36' Gravel Depth

☐ New System ☒ Repair System Type: I, II, III, IV, V, VI
System Description:
Repair System Description: Ch. Plastic on EZ Flow
Maintenance Agreement Required: ☐ Yes ☒ No


☒ House/Mod. Home No. Bedrooms 3
☐ Mobile Home No. Bathrooms 2
☐ Business No. Employees
☐ Other
☐ Slab ☒ Crawl Space ☐ Basement w/plumbing ☐ Basement wo/plumbing

Water Supply: ☒ Individual ☐ Public ☐ Community


Comments:/Conditions:

Comments:/Conditions: Grey filter installed. No speed levelers used.

INITIAL SITE SKETCH

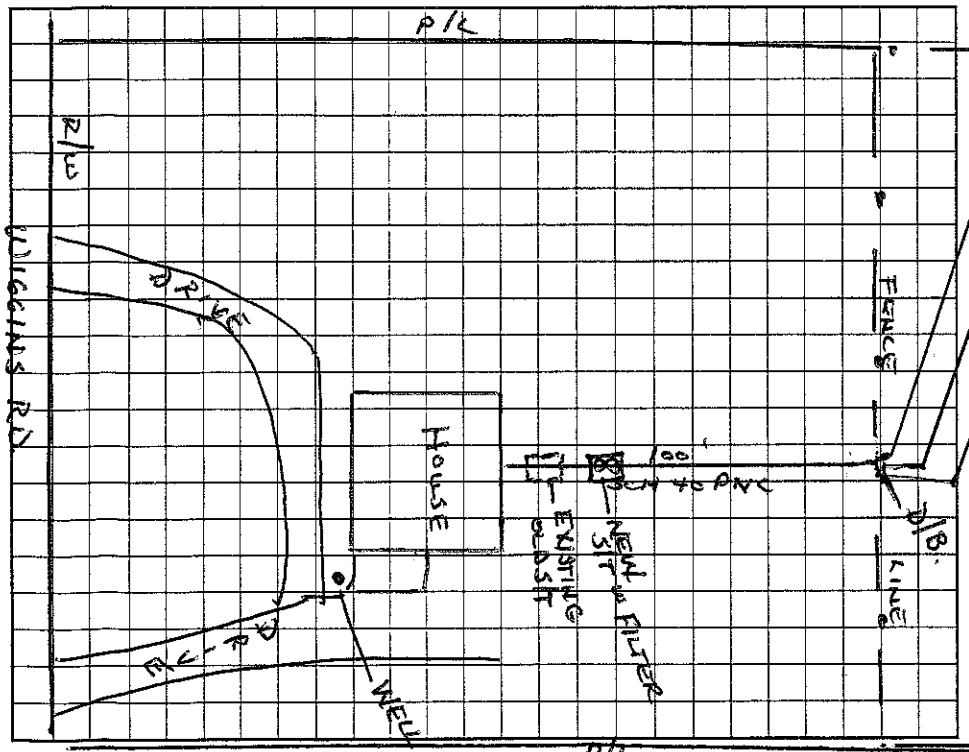

AS BUILT SKETCH

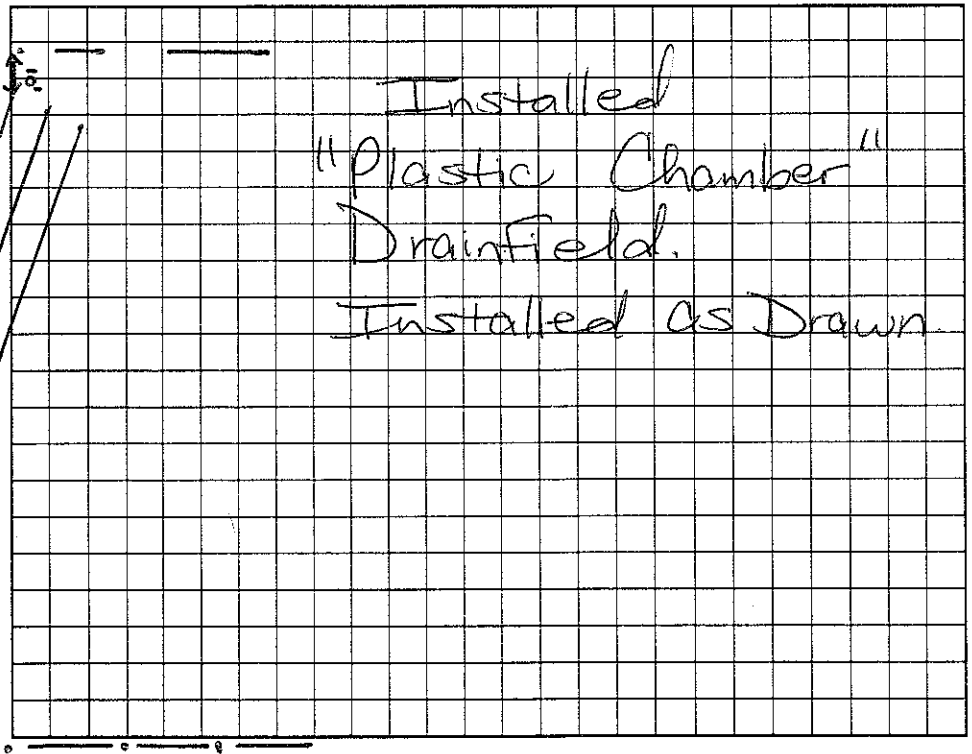

Permit can be suspended or revoked if any false information is supplied toward securing the permit/any unauthorized changes are made to the site/any unauthorized changes are made in the installation of the system. Improvement Permit with plat valid without expiration. Improvement Permit with site plan valid for sixty months. Authorization to Construct is valid for a period equal to that of Improvement Permit – not to exceed sixty months.

Signed: Teresa M Sloop date 4-22-03

Improvement Permit by: Wesley Sparks R.S. date 4/21/03

Authorization to Construct by: Wesley Sparks RS date 4/21/03

Installed by: Powell Backhoe Service

Operation Permit by: Maria H Dickson RS date 5/15/03

Existing System Inspection by: date

HEALTH DEPT. COPY: WHITE OWNER COPY (FINAL): YELLOW OWNER COPY (INITIAL): PINK