IREDELL COUNTY HEALTH DEPARTMENT

Authorization to Construct 9679523874

STATESVILLE 704-878-5305 MOORESVILLE 704-664-5281

IMPROVEMENT PERMIT / CERTIFICATE OF COMPLETION / OPERATION PERMIT / EXISTING SYSTEM INSPECTION

PROPERTY DESCRIPTION NO. 22759 DATE 12/14/95 TAX MAP NO. 4C-4-54 Watershed: ☑ Yes ☐ No

OWNER OR CONTRACTOR Michelle Rollings PHONE: Business _____ Home 663-7106

ADDRESS 2320 Sloop Rd. Mt. Ulla NC 28125

LOCATION Hwy 901 to Sloop Rd. Behind 3rd House on right

SUBDIVISION _____ BLOCK / SECTION _____ LOT _____ LOT AREA 3.5 ac SITE CLASS. PS DESIGN FLOW 240 L.T.A.R. .3 gpd/ft²

Septic Tank: 1000 Gallons; STB 825 Date 12/1/95

Pump Tank: _____ Gallons; PT _____ Date _____

Pump Make: _____ Model _____ Serial No. _____

Nitrification Field: No Fields 1 Square Feet 800 Linear Feet 267

No Lines 3 Trench Width 36" Max Trench Bottom Depth 36" Gravel Depth 12"

☑ New System ☐ Repair System Type: I, II, III, IV, V, VI

System Description: Gravity Conventional

Repair System Description: Same

Maintenance Agreement Required: ☐ Yes ☑ No

☐ House/Mod. Home No. Bedrooms 2

☑ Mobile Home No. Bathrooms 2

☐ Business No. Employees _____

☐ Other _____


☐ Slab ☑ Crawl Space ☐ Basement w/plumbing ☐ Basement wo/plumbing

Water Supply: ☑ Individual ☐ Community ☐ Public


Comments:

Comments:

INITIAL SITE SKETCH

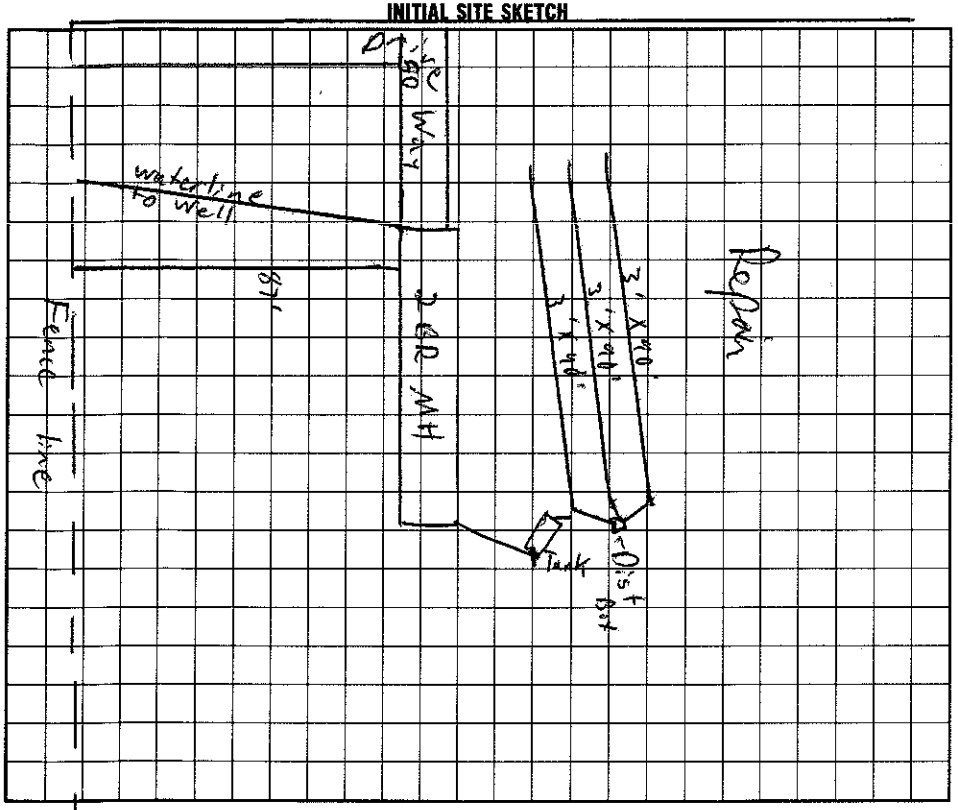

AS BUILT SKETCH

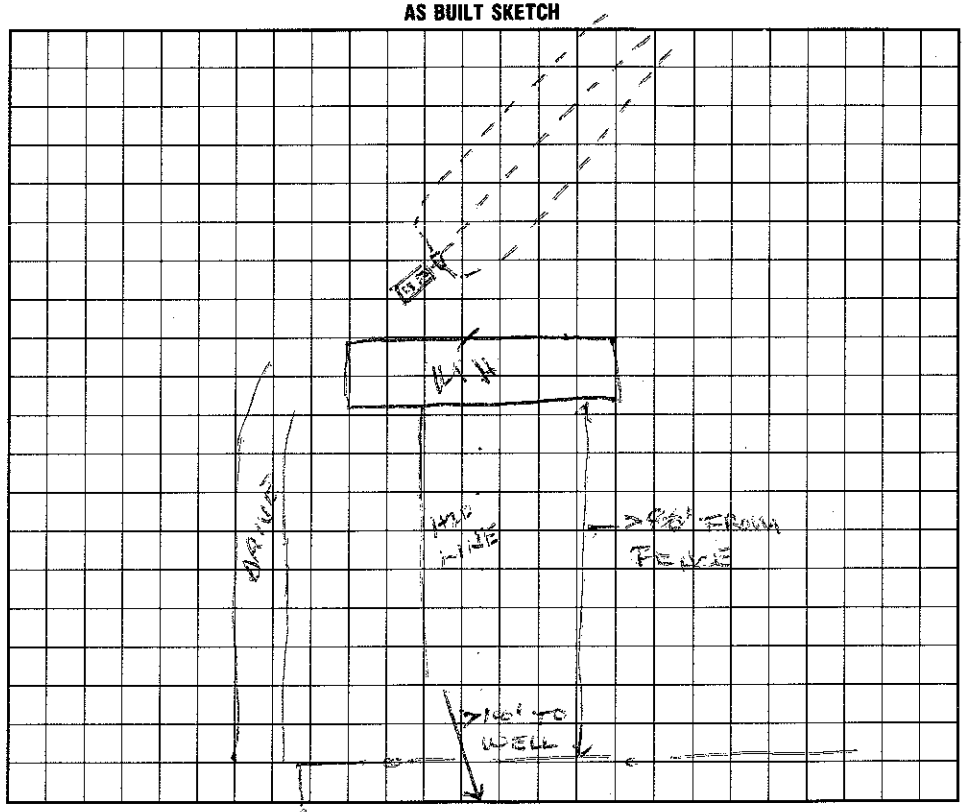

I understand that this permit can be suspended or revoked if any false information is supplied toward securing the permit/any unauthorized changes are made to the site/any unauthorized changes are made in the installation of the system.

Signed: Michelle Rollings

Improvement Permit by: Wesley Sparks R.S. date 12/14/95

Existing System Inspection by: Authorization to Construct Wesley Sparks R.S. date 12/14/95

Installed by: Rowan Septic Tank

Certificate of Completion by: Wesley Sparks R.S. date 2/13/96

Operation Permit by: Wesley Sparks R.S. date 2/13/96

HEALTH DEPT. COPY: WHITE INSPECTION COPY (FINAL): GREEN OWNER COPY (FINAL): YELLOW INSPECTION COPY (INITIAL): PINK OWNER COPY (INITIAL): GOLD