IREDELL COUNTY HEALTH DEPARTMENT

STATESVILLE 704-878-5305 MOORESVILLE 704-664-5281

IMPROVEMENT PERMIT / AUTHORIZATION TO CONSTRUCT / OPERATION PERMIT / EXISTING SYSTEM INSPECTION

PERMIT# 10954 PIN# 4679-52-9067 / 4679528098 DATE 11/7/02

OWNER OR CONTRACTOR Josh Arrowood PHONE: Business _____ Home 704-662-9043

ADDRESS 2450 Sloop Rd Mt. Ulla NC 28125

LOCATION 801, TR Sloop, TR Gravel Drive Before #2450 on Rt.

SUBDIVISION _____ BLOCK / SECTION _____ LOT _____ LOT AREA 3.16 Ac. SITE CLASS PS DESIGN FLOW 240 L.T.A.R. _____

Septic Tank: Exist. Gallons; STB _____ Date _____

Pump Tank: _____ Gallons; PT _____ Date _____

Pump Make: _____ Model _____ Serial No. _____

Nitrification Field: No Fields ___ Square Feet 720 Linear Feet 240'

No Lines 3 @ 80' Trench Width 36" Max Trench Bottom Depth _____ Gravel Depth _____

☐ New System ☐ Repair System Type: I. (II) III. IV. V. VI

System Description: Exist. Conventional

Repair System Description: _____

Maintenance Agreement Required: ☐ Yes ☒ No

☐ House/Mod. Home ☒ Mobile Home ☐ Business ☐ Other

No. Bedrooms 2 No. Bathrooms 2 No. Employees ___

☐ Slab ☒ Crawl Space ☐ Basement w/plumbing ☐ Basement wo/plumbing

Water Supply: ☑ Individual ☐ Public ☐ Community


Existing

Comments:/Conditions:

Comments:/Conditions:

INITIAL SITE SKETCH

AS BUILT SKETCH

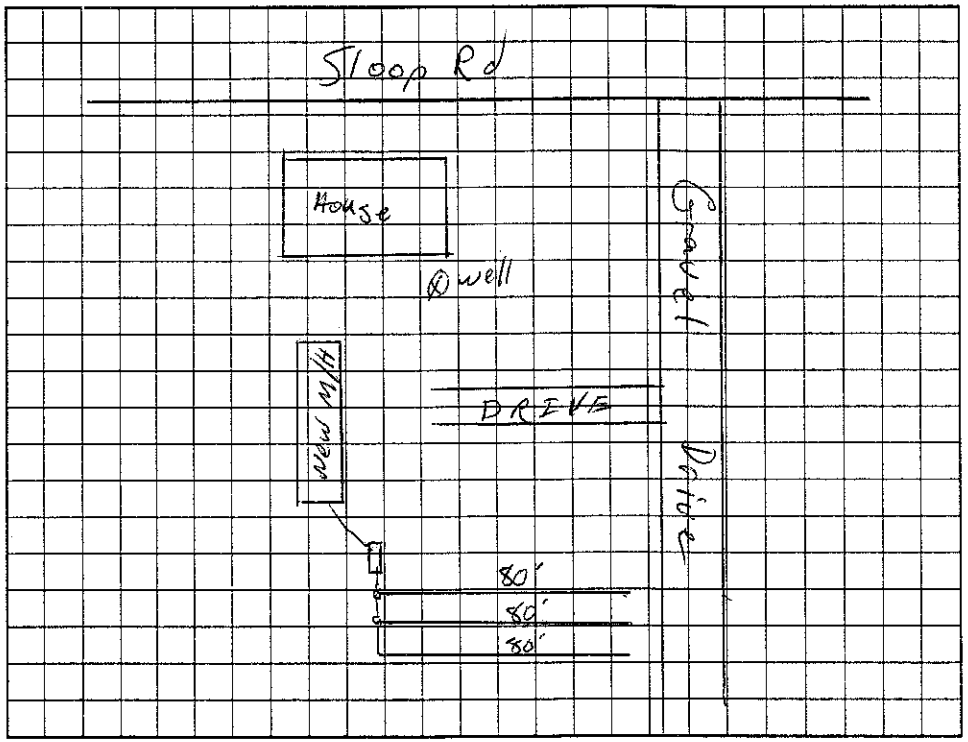

Permit can be suspended or revoked if any false information is supplied toward securing the permit/any unauthorized changes are made to the site/any unauthorized changes are made in the installation of the system. Improvement Permit with plat valid without expiration. Improvement Permit with site plan valid for sixty months. Authorization to Construct is valid for a period equal to that of Improvement Permit – not to exceed sixty months.

Signed: _____ date 11/7/02 Installed by: _____

Improvement Permit by: _____ date _____ Operation Permit by: _____ date _____

Authorization to Construct by: _____ date _____ Existing System Inspection by: _____ RS date 11/7/02

HEALTH DEPT. COPY: WHITE OWNER COPY (FINAL): YELLOW OWNER COPY (INITIAL): PINK