IREDELL COUNTY HEALTH DEPARTMENT

Statesville Office (704) 878-5305 Mooresville Office (704) 660-3625 PERMIT # 205034 ~~20216O~~

IMPROVEMENT PERMIT / AUTHORIZATION TO CONSTRUCT / OPERATION PERMIT / EXISTING SYSTEM

PIN # 4679-93-9311

APPLICANT: Hoyle Legacy Trust APPLICANT ADDRESS: 6741 Hickory Ridge Rd Harrisburg NC 28075

SITE ADDRESS: 823 Mazeppa Rd PHONE: 704-455-2125 ALT. PHONE:

SITE DIRECTIONS: Hwy 115 N, TR on Mazeppa Rd, Lot on R before Triplett Rd


SUBDIVISION: SECTION: LOT # 2 LOT AREA: 4.325 ac DESIGN FLOW: 360 gpd L.T.A.R.: 0.25

Septic Tank	1000 (gal)	STB	825	Date	9-7-14	☑ New System ☐ Repair ☐ Expansion	System Type: I II III IV V VI	☑ Residence	No. Bedrooms 3
Pump Tank	(gal)	PT		Date		System Description:	Gravity 25% Reduction	☐ Business	No. Persons 6
Pump Make		Model		Serial #		Repair System Description:	Gravity 25% Reduction	☐ Other	No. Employees
# Nitrification Fields	1	# Lines	4	Linear Ft:	360'	Maintenance Agreement Required:	☐ YES ☑ NO	☐ Slab	☑ Crawl Space
Trench Width	36"	Max. Trench Bottom Depth	24"	Gravel Depth	N/A	☑ GRAVITY	☐ PRESSURE	☐ Basement w/plumbing	☐ Basement w/o plumbing


Water Supply: ☑ Private ☐ Public ☐ Community

Comments / Conditions:

INITIAL SITE SKETCH

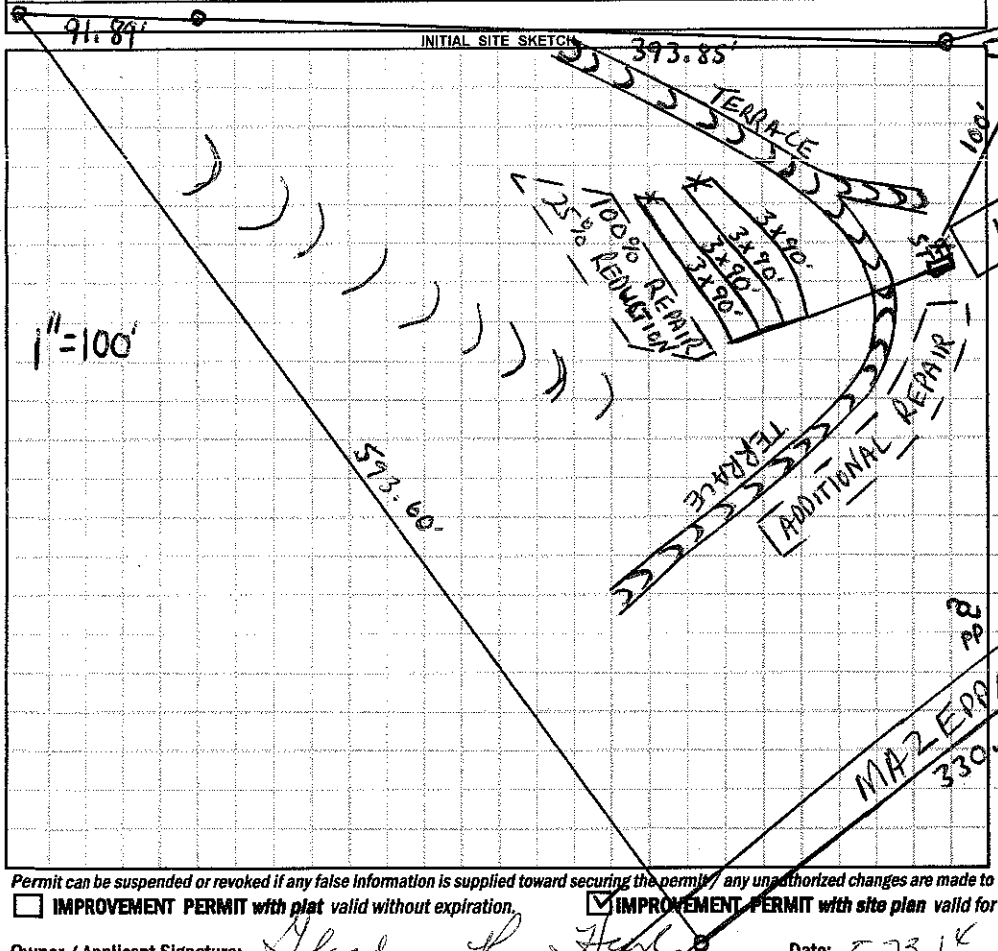

AS BUILT SKETCH

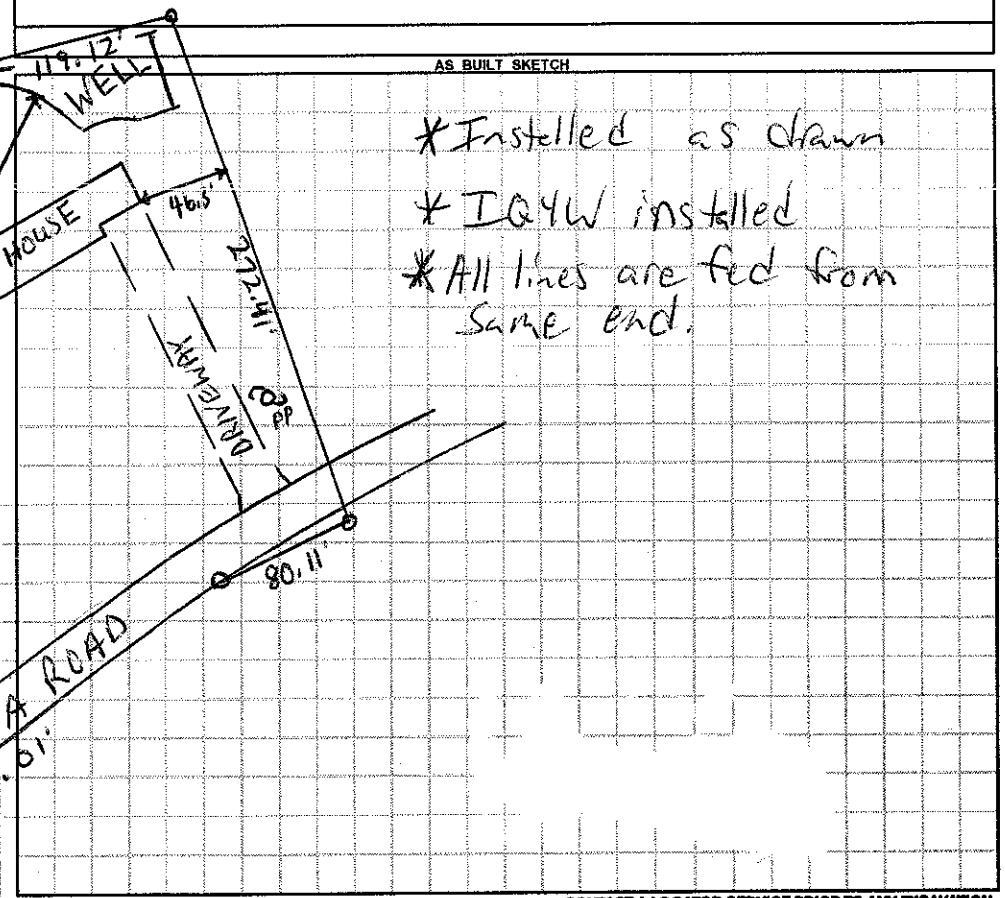

Permit can be suspended or revoked if any false information is supplied toward securing the permit / any unauthorized changes are made to the site / any unauthorized changes are made in the installation of the system. **CONTACT A LOCATOR SERVICE PRIOR TO ANY EXCAVATION**

☐ **IMPROVEMENT PERMIT** *with plat valid without expiration.* ☑ **IMPROVEMENT PERMIT** *with site plan valid for 60 mos.* ☐ **AUTHORIZATION TO CONSTRUCT** *valid for period equal to IMPROVEMENT PERMIT--not to exceed 60 mo.*

Owner / Applicant Signature: Hoyle L. Hoyle Date: 5-23-14 Installed by: Huneycutt Land Services

IMPROVEMENT PERMIT by: [signature] Date: 5-21-14 OPERATION PERMIT by: [signature] Date: 11-12-14

AUTHORIZATION TO CONSTRUCT by: [signature] Date: 5-21-14 Existing System Inspected by: Date:

Health Dept. Copy - WHITE Applicant (Final Approval) - YELLOW Applicant (Conditional Approval) - PINK