IREDELL COUNTY HEALTH DEPARTMENT

Authorization to Construct

4684068504

STATESVILLE 704-878-5305 MOORESVILLE 704-664-5281

IMPROVEMENT PERMIT / ~~CERTIFICATE OF COMPLETION~~ / OPERATION PERMIT / EXISTING SYSTEM INSPECTION

PROPERTY DESCRIPTION NO. 22647 DATE 3/19/96 TAX MAP NO. 1A-A-49 Watershed: ☑ Yes ☐ No

OWNER OR CONTRACTOR Robert V. Rathbone PHONE: Business _____ Home 559-0649 - Beeper

ADDRESS PO Box 1709 Mooresville NC 28115

LOCATION 136 S - TL Patterson Farm Rd - TR Rustic Rd. TR Rathbone Drive - last at end of drive

SUBDIVISION Regina's Place BLOCK / SECTION _____ LOT 1 LOT AREA 3.898 ac SITE CLASS PS DESIGN FLOW 360 gpd L.T.A.R. 3 gpd/sq ft

Septic Tank: 1000 Gallons; STB 794 Date 3-4-96

Pump Tank: _____ Gallons; PT _____ Date _____

Pump Make: _____ Model _____ Serial No. _____

Nitrification Field: No Fields 1 Square Feet 1200 Linear Feet 400

No Lines 4 Trench Width 36" Max Trench Bottom Depth 24" Gravel Depth 12"

☑ New System ☐ Repair System Type: I ☐ II ☐ III ☐ IV ☐ V ☐ VI

System Description: Gravity Conventional

Repair System Description: Pump Conventional

Maintenance Agreement Required: ☐ Yes ☑ No

☐ House/Mod. Home ☑ Mobile Home ☐ Business ☐ Other

No. Bedrooms 3 No. Bathrooms 2 No. Employees _____


☐ Slab ☑ Crawl Space ☐ Basement w/plumbing ☐ Basement wo/plumbing

Water Supply: ☑ Individual ☐ Community ☐ Public


Comments: MH needs to be 5' away from any part of septic system. Driveway shall be diverted away from any part of septic system

Comments:

INITIAL SITE SKETCH (NOT TO SCALE)

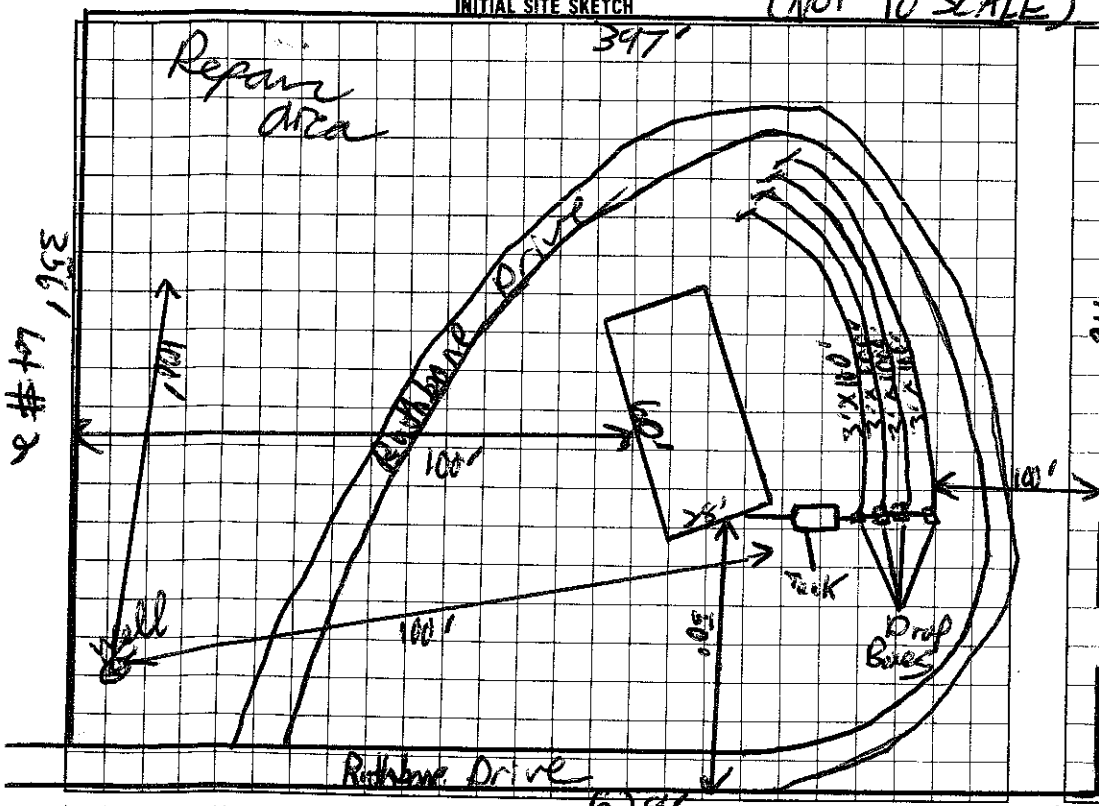

AS BUILT SKETCH

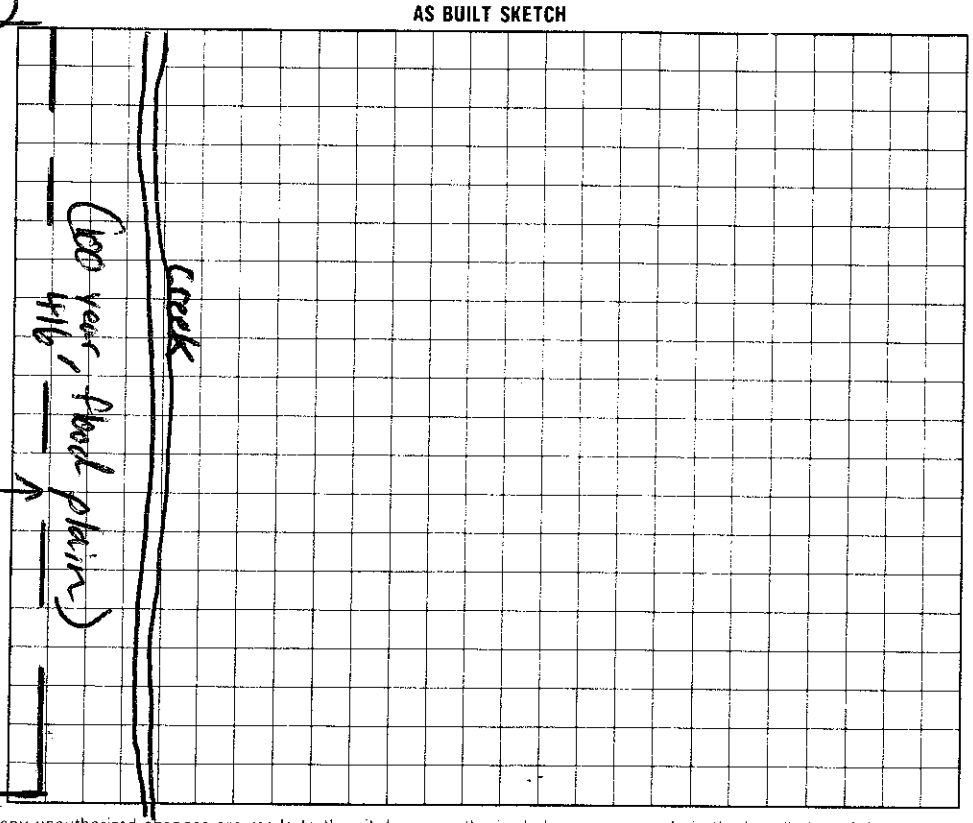

I understand that this permit can be suspended or revoked if any false information is supplied toward securing the permit/any unauthorized changes are made to the site/any unauthorized changes are made in the installation of the system.

Signed: X Edgar Johnson

Improvement Permit by: C. Bridgeman EHS date 3/19/96

~~Authorization to Construct~~ Existing System Inspection by: C. Bridgeman EHS date 3/19/96

Installed by: B&W Christenberry

Certificate of Completion by: _____ date _____

Operation Permit by: C. Bridgeman date 5/1/96

HEALTH DEPT. COPY: WHITE INSPECTION COPY (FINAL): GREEN OWNER COPY (FINAL): YELLOW INSPECTION COPY (INITIAL): PINK OWNER COPY (INITIAL): GOLD

Authorization to Construct is valid for 60 months from date of issue