4684263265

IREDELL COUNTY HEALTH DEPARTMENT

STATESVILLE 704-878-5305 MOORESVILLE 704-664-5281

IMPROVEMENT PERMIT / CERTIFICATE OF COMPLETION / OPERATION PERMIT / EXISTING SYSTEM INSPECTION

PROPERTY DESCRIPTION NO. 19605 DATE 11/21/94 TAX MAP NO. 1A-A-7 Watershed: ☐ Yes ☑ No

OWNER OR CONTRACTOR Anna Lee Duncan PHONE: Business _____ Home 663-6291

ADDRESS 338 Rustic Rd. Mooresville, NC. 28115

LOCATION on D just before end of road

SUBDIVISION Annalee Duncan BLOCK _____ SECTION _____ LOT 2 LOT AREA ~30,000 Ft² SITE CLASS. P DESIGN FLOW 360/360 L.T.A.R. .3

Septic Tank: 1000/1000 Gallons; STB 825/825 Date 12/1/94/12/1/94 ☑ New System ☐ Repair System Type: I (II) III, IV, V, VI

Pump Tank: _____ Gallons; PT _____ Date _____ System Description: DIST. Box - conv.

Pump Make: _____ Model _____ Serial No. _____ Repair System Description: _____

Nitrification Field: No Fields 1 Square Feet 1200/1200 Linear Feet 800 Maintenance Agreement Required: ☐ Yes ☑ No

No Lines 3/3 Trench Width 36" Max Trench Bottom Depth 36" Gravel Depth 12" ☐ Slab ☐ Crawl Space ☐ Basement w/plumbing ☐ Basement wo/plumbing

☐ House/Mod. Home No. Bedrooms _____

☐ Mobile Home No. Bathrooms _____


☐ Business No. Employees _____

☑ Other 3 - 3BRM APT.

Water Supply: ☑ Individual ☐ Community ☐ Public

Comments:

INITIAL SITE SKETCH

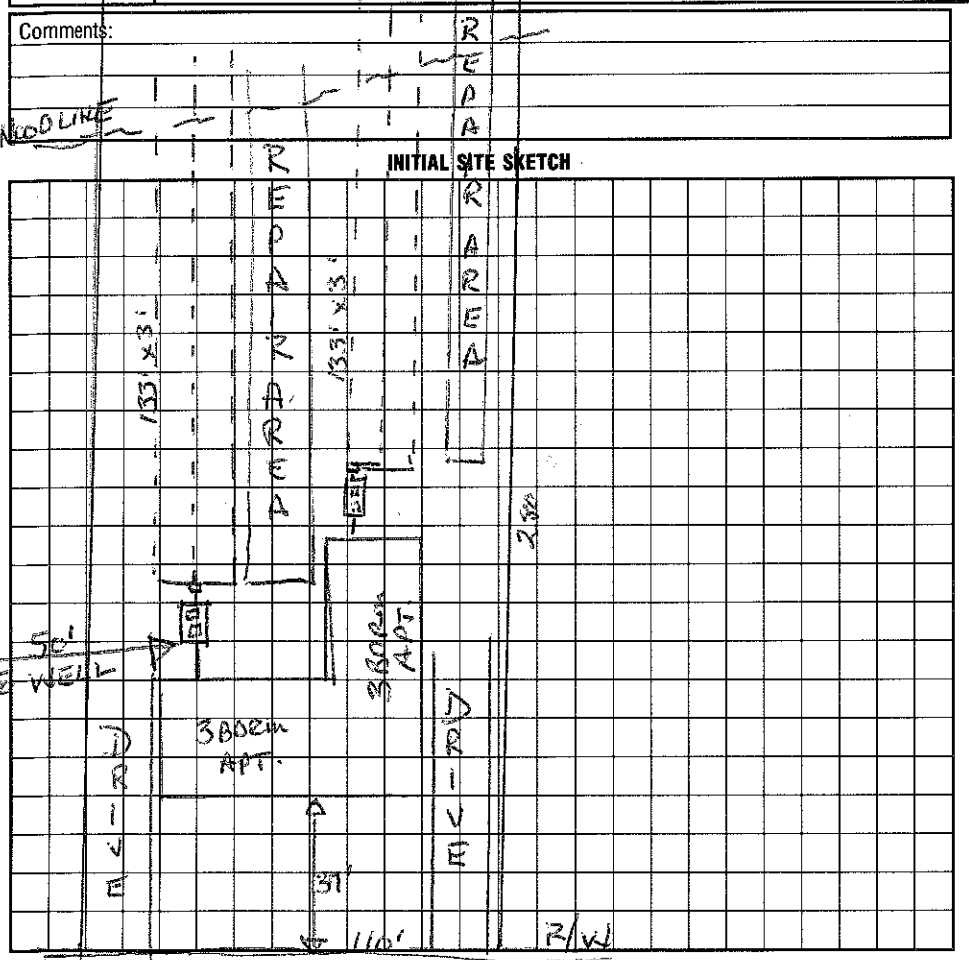

Comments:

Installed as drawn.

Plumbing must be shutdown on other buildings

AS BUILT SKETCH

I understand that this permit can be suspended or revoked if any false information is supplied toward securing the permit/any unauthorized changes are made to the site/any unauthorized changes are made in the installation of the system. Improvement Permit is valid for 60 months from date of issuance.

Signed: [signature] Rustic Rd. Just before Corner

Improvement Permit by: Wesley Sparks RS date 11/21/94

Existing System Inspection by: _____ date _____

Installed by: Delbert Bostian

Certificate of Completion by: Wesley Sparks RS. date 2/3/95

Operation Permit by: _____ date _____

HEALTH DEPT. COPY: WHITE INSPECTION COPY (FINAL): GREEN OWNER COPY (FINAL): YELLOW INSPECTION COPY (INITIAL): PINK OWNER COPY (INITIAL): GOLD