4684-26-3304

IREDELL COUNTY HEALTH DEPARTMENT

STATESVILLE 704-878-5305 MOORESVILLE 704-664-5281

IMPROVEMENT PERMIT / CERTIFICATE OF COMPLETION / OPERATION PERMIT / EXISTING SYSTEM INSPECTION

PROPERTY DESCRIPTION NO. 19836 DATE 1/17/95 TAX MAP NO. 1A-A-7 Pt of. Watershed: ☑ Yes ☐ No

OWNER OR CONTRACTOR Anna Lee Duncan PHONE: Business _____ Home 663-6291

ADDRESS 338 Rustic Rd. Mooresville, NC. 28115

LOCATION on (L) near end, 1st building on (L)

SUBDIVISION Anna Lee Duncan BLOCK / SECTION _____ LOT 1 LOT AREA 1.17 AC SITE CLASS. P DESIGN FLOW 360/360 L.T.A.R. .3

Septic Tank: 1000/1000 Gallons; STB 825/825 Date 9/1/95 8/5/95 ☑ New System ☐ Repair System Type: I (II) III, IV, V, VI

Pump Tank: _____ Gallons; PT _____ Date _____ System Description: CONV -

Pump Make: _____ Model _____ Serial No. _____ Repair System Description: PANEL

Nitrification Field: No Fields 2 Square Feet 1200/1200 Linear Feet 400/400 Maintenance Agreement Required: ☐ Yes ☑ No

No Lines 3/3 Trench Width 36" Max Trench Bottom Depth 36" Gravel Depth 12"

☐ House/Mod. Home No. Bedrooms ____
☐ Mobile Home No. Bathrooms ____
☐ Business No. Employees ____
☑ Other 2 - 3 BD. APTS


☐ Slab ☑ Crawl Space ☐ Basement w/plumbing ☐ Basement wo/plumbing

Water Supply: ☑ Individual ☐ Community ☐ Public


Comments:

Comments:

INITIAL SITE SKETCH

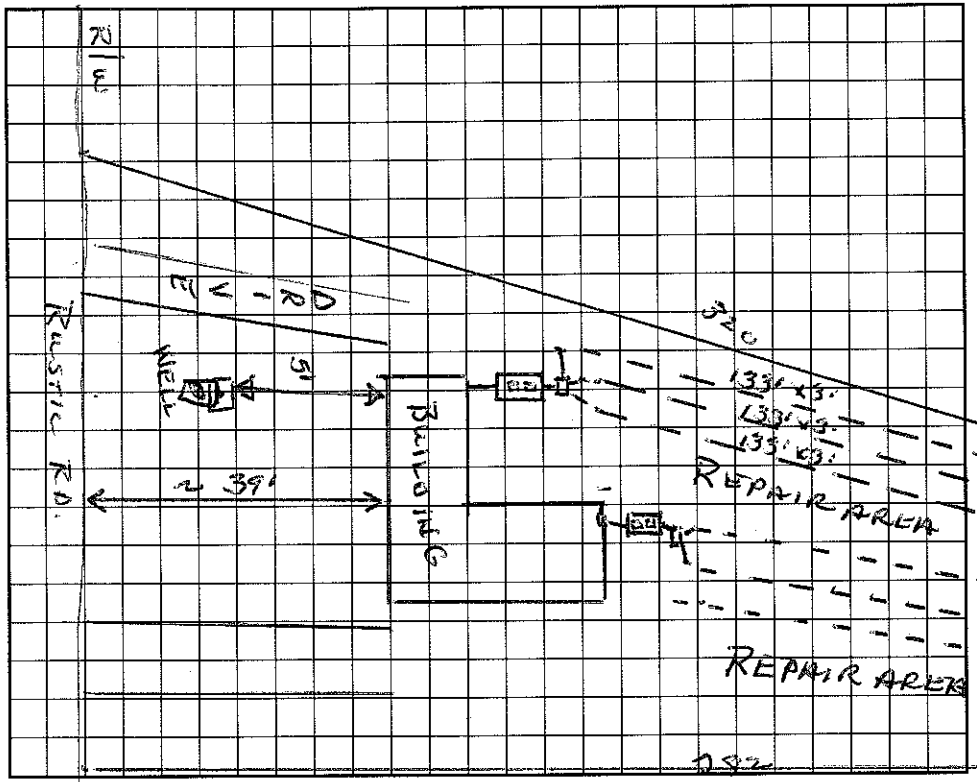

AS BUILT SKETCH

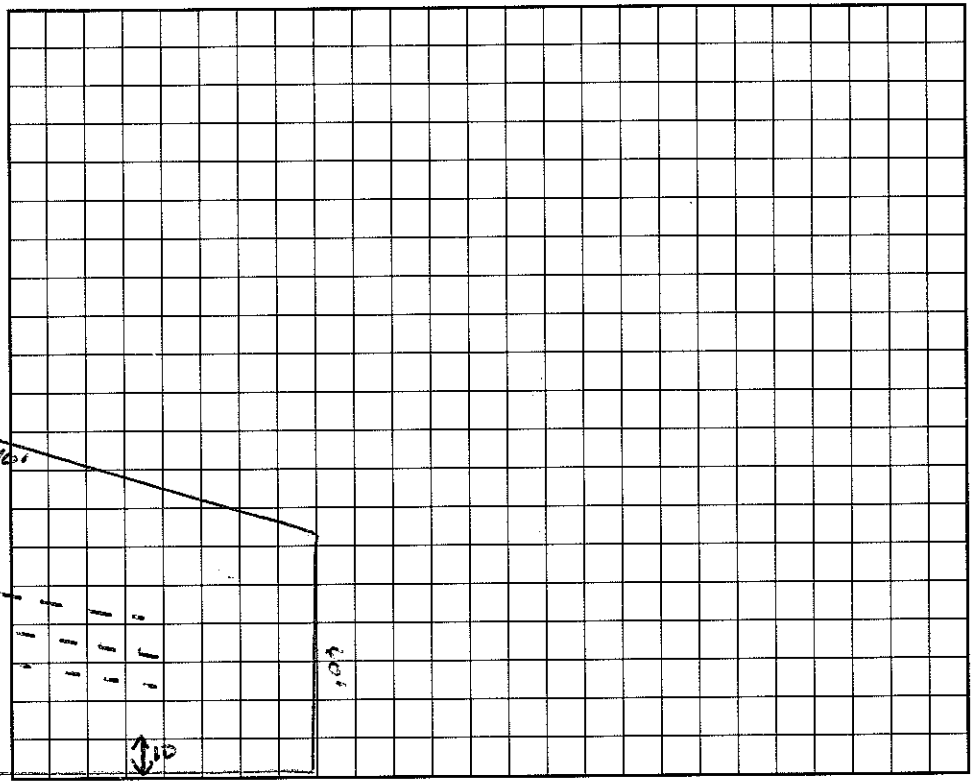

I understand that this permit can be suspended or revoked if any false information is supplied toward securing the permit/any unauthorized changes are made to the site/any unauthorized changes are made in the installation of the system. Improvement Permit is valid for 60 months from date of issuance.

Signed: H. F. Gentenbergy

Improvement Permit by: Wesley Sparks RS. date 1/17/95

Existing System Inspection by: Wesley Sparks RS date 10/20/95

Installed by: D Hunt Beaton

Certificate of Completion by: _____ date _____

Operation Permit by: Wesley Sparks RS. date 10/20/95

HEALTH DEPT. COPY: WHITE INSPECTION COPY (FINAL): GREEN OWNER COPY (FINAL): YELLOW INSPECTION COPY (INITIAL): PINK OWNER COPY (INITIAL): GOLD