4684-26-5020 COPY 1

IREDELL COUNTY HEALTH DEPARTMENT

STATESVILLE 704-878-5305 MOORESVILLE 704-664-5281

IMPROVEMENT PERMIT / CERTIFICATE OF COMPLETION / OPERATION PERMIT / EXISTING SYSTEM INSPECTION

PROPERTY DESCRIPTION NO. 19838 - 19839 DATE 1/17/95 TAX MAP NO. 1A-A-7 Pt of Watershed: ☑ Yes ☐ No

OWNER OR CONTRACTOR Anna Lee Duncan PHONE: Business _____ Home 663-6291

ADDRESS 338 Rustic Rd. Mooresville

LOCATION Rustic Rd. left hand side (L)

SUBDIVISION Anna L. Duncan BLOCK / SECTION _____ LOT 4+5 LOT AREA .64 Ac EACH SITE CLASS. P DESIGN FLOW 360/360 L.T.A.R. .3

Septic Tank: 1000/1000 Gallons; STB _____ Date _____

Pump Tank: _____ Gallons; PT _____ Date _____

Pump Make: _____ Model _____ Serial No. _____

Nitrification Field/ No Fields 2 Square Feet 1200/1200 Linear Feet 400/400

No Lines 3/4 Trench Width 36" Max Trench Bottom Depth 36" Gravel Depth 12"

☑ New System ☐ Repair System Type: I, II, III, IV, V, VI

System Description: CONV

Repair System Description: PANEL

Maintenance Agreement Required: ☐ Yes ☑ No

☐ House/Mod. Home No. Bedrooms ____

☐ Mobile Home No. Bathrooms ____

☐ Business No. Employees ____

☑ Other 2 3BD APTS.

☐ Slab ☑ Crawl Space ☐ Basement w/plumbing ☐ Basement wo/plumbing

Water Supply: ☑ Individual ☐ Community ☐ Public

LOT 1


Comments:

Comments:


(1) See Imp Permit

(2) LOWER (RIGHT SIDE SYSTEM)

INITIAL SITE SKETCH

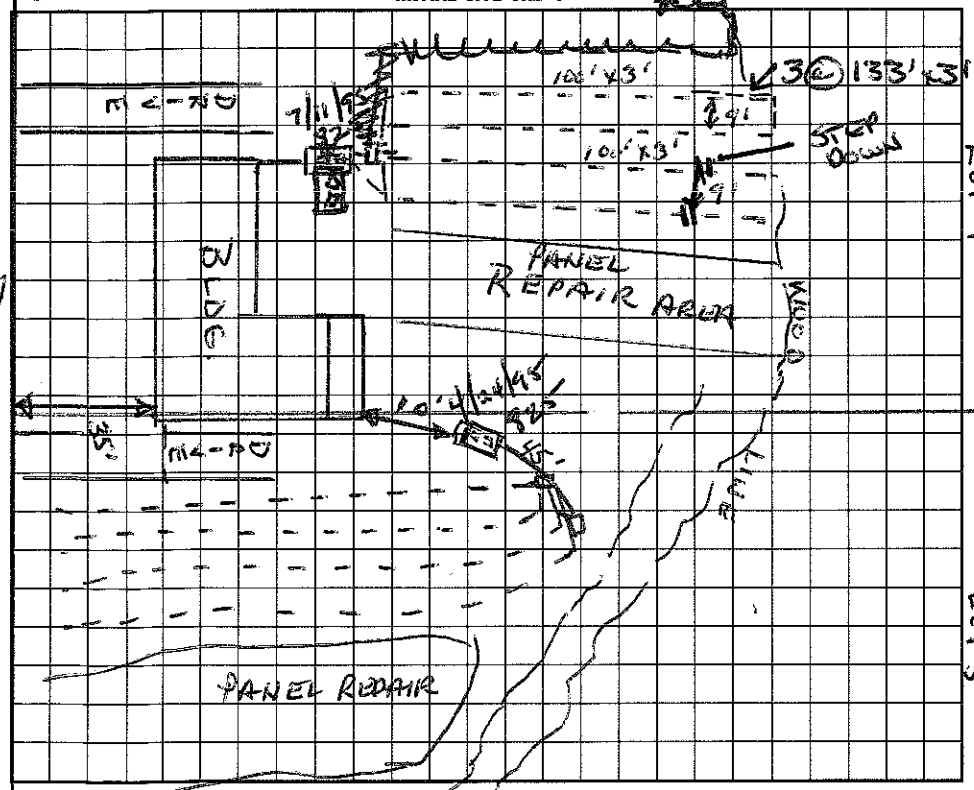

AS BUILT SKETCH

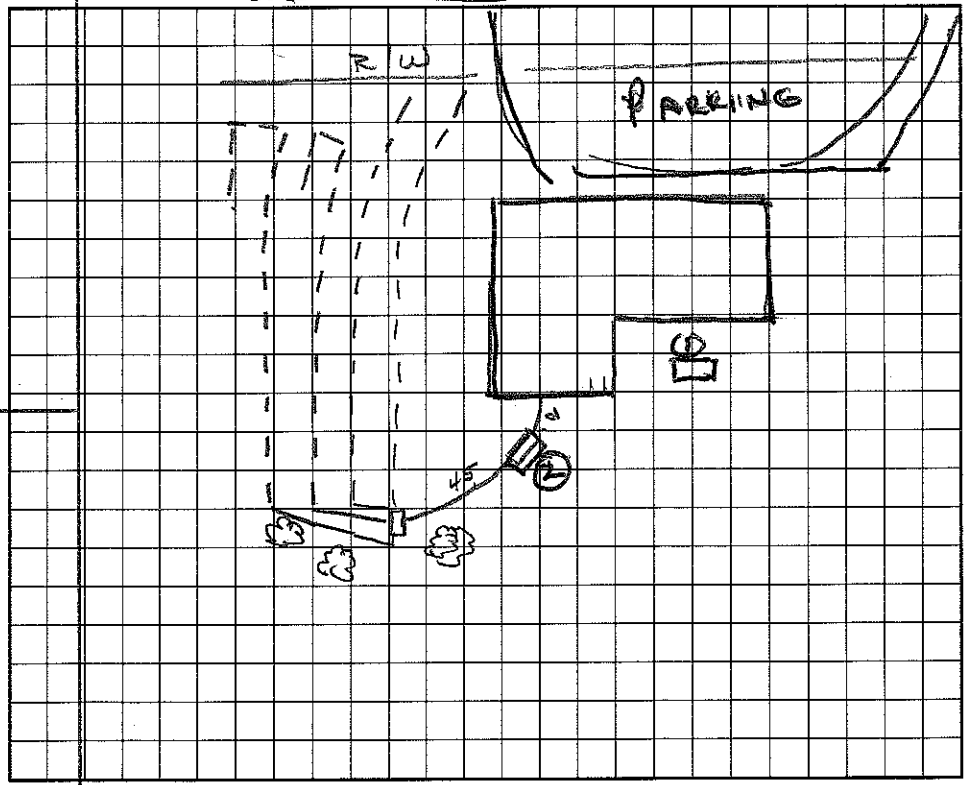

I understand that this permit can be suspended or revoked if any false information is supplied toward securing the permit/any unauthorized changes are made to the site/any unauthorized changes are made in the installation of the system. Improvement Permit is valid for 60 months from date of issuance.

Signed: H.B. Jones (agent) George

Improvement Permit by: Wesley Sparks RS. date 1/17/95

Existing System Inspection by: _____ date _____

Installed by: Delbert Bostian

Certificate of Completion by: Wesley Sparks RS. date 8/23/95

Operation Permit by: _____ date _____

HEALTH DEPT. COPY: WHITE INSPECTION COPY (FINAL): GREEN OWNER COPY (FINAL): YELLOW INSPECTION COPY (INITIAL): PINK OWNER COPY (INITIAL): GOLD