10:00

IREDELL COUNTY HEALTH DEPARTMENT

STATESVILLE 704-878-5305 MOORESVILLE 704-664-5281

IMPROVEMENT PERMIT / AUTHORIZATION TO CONSTRUCT / OPERATION PERMIT / EXISTING SYSTEM INSPECTION

PERMIT# 086982 PIN# 4685026669 PT 4685025627 DATE 1/24/2000

OWNER OR CONTRACTOR Terry Welcher PHONE: Business 528-4516 Richard Oakwood Home (704) 662-6498

ADDRESS 1551 Mt. Ulla Hwy Mooresville NC 28115

LOCATION Hwy 1365 TL Patterson Farm Rd on left just past Greggs Wood (Near Chicken houses)

SUBDIVISION _____ BLOCK / SECTION _____ LOT _____ LOT AREA 5.87 Acres SITE CLASS. PS DESIGN FLOW 360gpd L.T.A.R. .25-.3

Septic Tank: 1000 Gallons; STB 794 Date 12/10/99

Pump Tank: _____ Gallons; PT _____ Date _____

Pump Make: _____ Model _____ Serial No. _____

Nitrification Field: No Fields 1 Square Feet 1200' Linear Feet 400'

No Lines 4 at 100' Trench Width 36" Max Trench Bottom Depth 36" Gravel Depth 12"

☒ New System ☐ Repair System Type: I, (II), III, IV, V, VI

System Description: Gravity - Conventional

Repair System Description: Pump/Grav. - Conventional

Maintenance Agreement Required: ☐ Yes ☒ No

☐ House/Mod. Home ☒ Mobile Home ☐ Business ☐ Other

No. Bedrooms 3 No. Bathrooms 2 No. Employees ____


☐ Slab ☒ Crawl Space ☐ Basement w/plumbing ☐ Basement wo/plumbing

Water Supply: ☒ Individual ☐ Public ☐ Community


Comments/Conditions: Keep Septic System (tanks & drainfield) at least 5' from house, 10' from PL & 100' to well. Keep well at least 25' from home. Keep Septic System at least 50' from Neighbor's well.

Comments/Conditions: Must keep drainlines out of low area further uphill the better.

INITIAL SITE SKETCH Scale = 1:100

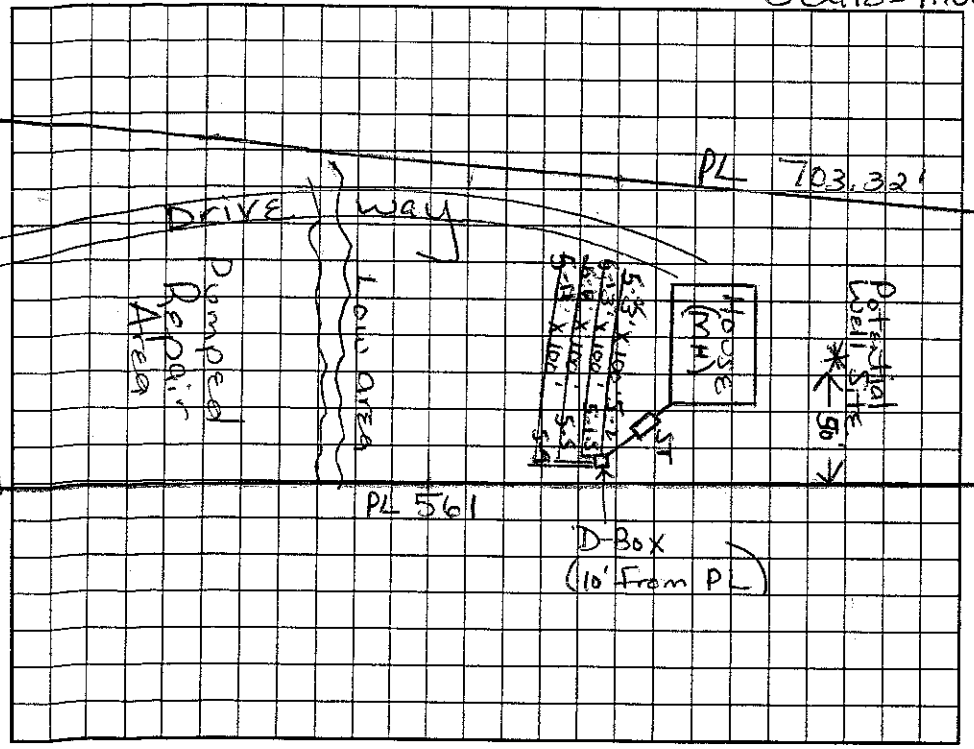

AS BUILT SKETCH

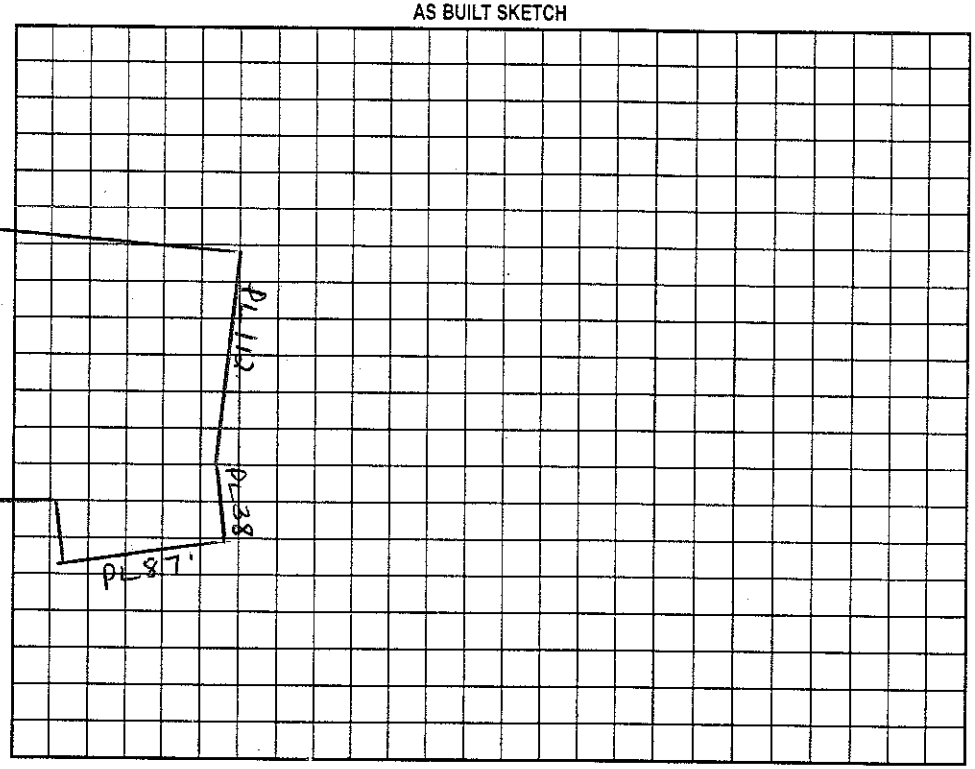

Permit can be suspended or revoked if any false information is supplied toward securing the permit/any unauthorized changes are made to the site/any unauthorized changes are made in the installation of the system. Improvement Permit with plat valid without expiration. Improvement Permit with site plan valid for sixty months. Authorization to Construct is valid for a period equal to that of Improvement Permit – not to exceed sixty months.

Signed: _____ date 1-27-00 Installed by: Larry Tucker

Improvement Permit by: Maria H. Dotson R.S. date 1/24/2000 Operation Permit by: Wesley Sparks R.S. date 2/23/00

Authorization to Construct by: Maria H. Dotson R.S. date 1/24/2000 Existing System Inspection by: _____ date _____

HEALTH DEPT. COPY: WHITE OWNER COPY (FINAL): YELLOW OWNER COPY (INITIAL): PINK