4685049184

IREDELL COUNTY HEALTH DEPARTMENT

STATESVILLE 704-878-5305 MOORESVILLE 704-664-5281

IMPROVEMENT PERMIT / CERTIFICATE OF COMPLETION / OPERATION PERMIT / EXISTING SYSTEM INSPECTION

PROPERTY DESCRIPTION NO. 16738 DATE August 2, '93 TAX MAP NO. 1FA43

OWNER OR CONTRACTOR Tom Daily PHONE: Business Home

ADDRESS RT 10, Box 732 Mooresville

LOCATION 136 S. TL Williford Rd. TR Enochville (Linwood) Rd. TR Patterson Farm Rd ~ ½ mile on Rt.

SUBDIVISION BLOCK / SECTION LOT LOT AREA SITE CLASS. L.T.A.R. .63 - .4

Water Supply: ☑ Individual ☐ Community ☐ Public

Septic Tank: Existing 1000 Gallons; STB Date

Pump Tank: Gallons; PT Date

Nitrification Field: No Fields 1 Square Feet 1200 total Linear Feet 200 + Ex.

No Lines 2 + Ex. Trench Width 36" Trench Depth 24-36" Gravel Depth 12"

☐ New System ☑ Repair System Type: I, II, III, IV, V, VI

System Description: gravity conventional

Repair System Description: SAME

Maintenance Agreement Required: ☐ Yes ☑ No

☑ House/Mod. Home No. Bedrooms 3 Garbage Disposal: ☐ Yes ☑ No

☐ Mobile Home No. Bathrooms 2 Auto. Dishwasher: ☐ Yes ☑ No


☐ Business No. Employees Auto. Washing Machine: ☑ Yes ☐ No

☐ Other Other

☐ Slab ☑ Crawl Space ☐ Basement w/plumbing ☐ Basement wo/plumbing

Comments: Upgrading septic system to accomodate 3 bedroom structure. Mobile home to be removed once home is set up. Use speed levelator box.

INITIAL SITE SKETCH

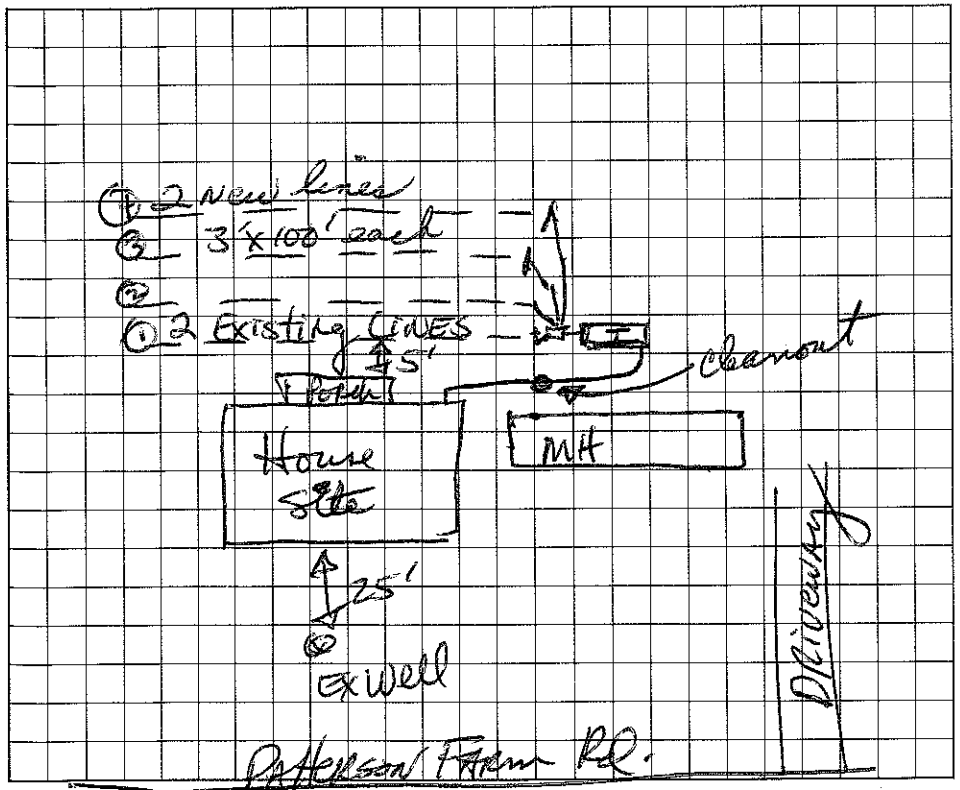

AS BUILT SKETCH

Cleanout to be installed as shown on I.P.

Line 1 doing majority of work in old DIB

Installed as shown on I.P.

I understand that this permit can be suspended or revoked if any false information is supplied toward securing the permit/any unauthorized changes are made to the site/any unauthorized changes are made in the installation of the system. Improvement Permit is valid for 60 months from date of issuance.

Signed: Tom Daily

Improvement Permit by: David R. Hunsucker RS date 8/2/93

Existing System Inspection by: date

Installed by: Richard Abernathy

Certificate of Completion by: Wesley Parks RS date 7/25/94

Operation Permit by: date

HEALTH DEPT. COPY: WHITE INSPECTION COPY (FINAL): GREEN OWNER COPY (FINAL): YELLOW INSPECTION COPY (INITIAL): PINK OWNER COPY (INITIAL): GOLD