IREDELL COUNTY HEALTH DEPARTMENT

STATESVILLE 704-878-5305 (1) MOORESVILLE 704-664-5281

IMPROVEMENT PERMIT / AUTHORIZATION TO CONSTRUCT / OPERATION PERMIT / EXISTING SYSTEM INSPECTION

PERMIT# 106042 PIN# 4685 21 3073 4685108901 4685205665 DATE 5/21/02

OWNER OR CONTRACTOR Dina Baker PHONE: Business Home 704-660-1738

ADDRESS 634 Mills Wood Dr. Mooresville, NC. 28115 4685-26-0790

LOCATION 1365 Tr Patterson Farm Rd. ~ 2 miles on (R)

SUBDIVISION Patterson Creek BLOCK / SECTION LOT 7 LOT AREA ~12 AC SITE CLASS. PS DESIGN FLOW 360 L.T.A.R. .3

Septic Tank: 1000 Gallons; STB 794 Date 3/1/02

Pump Tank: Gallons; PT Date

Pump Make: Model Serial No.

Nitrification Field: No Fields 1 Square Feet 1200 Linear Feet 400

No Lines 3 @ 133 Trench Width 3' Max Trench Bottom Depth 3' Gravel Depth 1"

☒ New System ☐ Repair System Type: I, (II), III, IV, V, VI

System Description: Gravity - Conventional

Repair System Description: Same

Maintenance Agreement Required: ☐ Yes ☒ No

☒ House/Mod. Home No. Bedrooms 3

☐ Mobile Home No. Bathrooms 3

☐ Business No. Employees

☐ Other


☐ Slab ☐ Crawl Space ☒ Basement w/plumbing ☐ Basement wo/plumbing

Water Supply: ☒ Individual ☐ Public ☐ Community


Comments:/Conditions: 3 @ 133' x 3' may be used on this site.

Comments:/Conditions:

(NOT TO SCALE) INITIAL SITE SKETCH

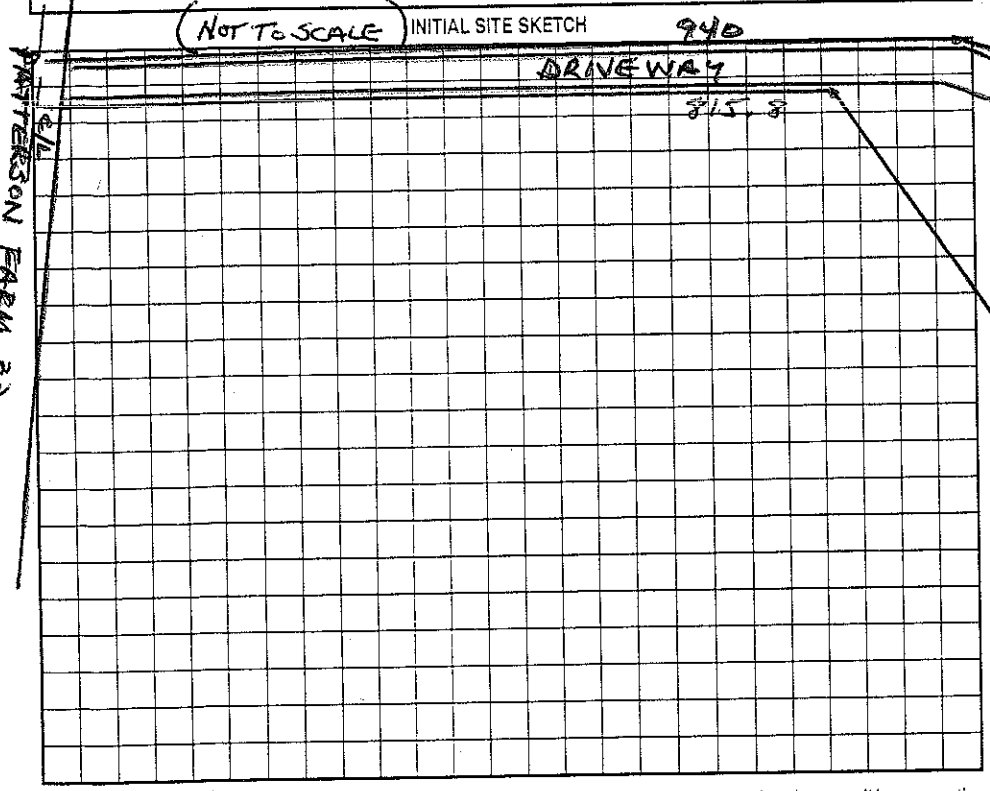

AS BUILT SKETCH

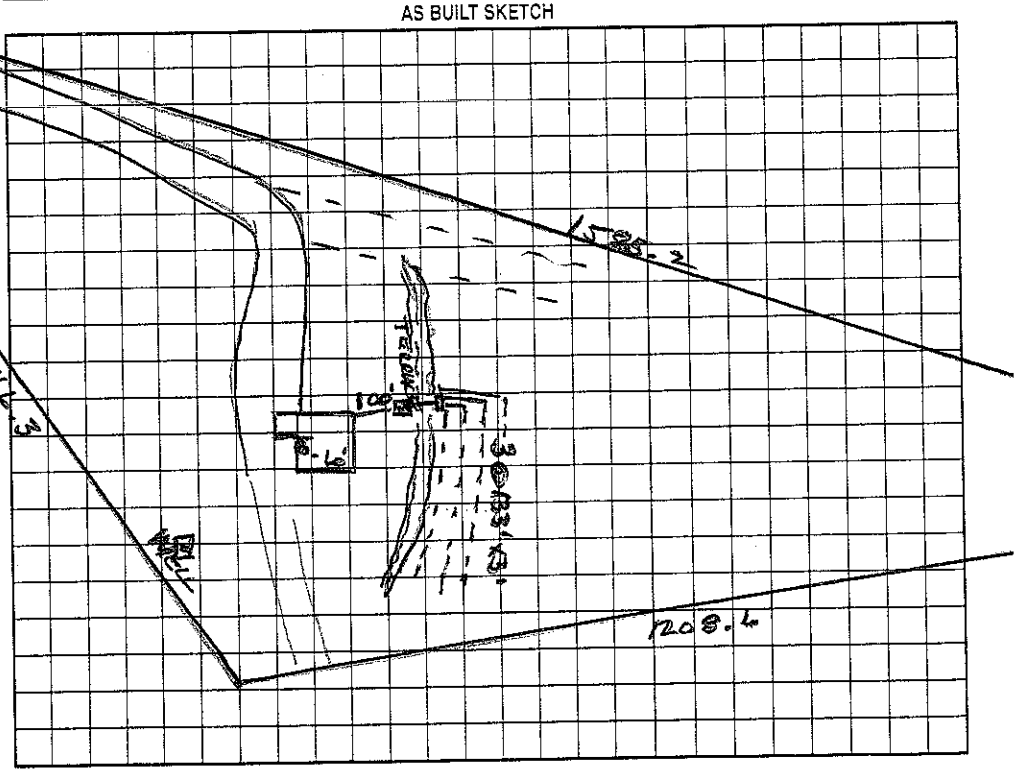

Permit can be suspended or revoked if any false information is supplied toward securing the permit/any unauthorized changes are made to the site/any unauthorized changes are made in the installation of the system. Improvement Permit with plat valid without expiration. Improvement Permit with site plan valid for sixty months. Authorization to Construct is valid for a period equal to that of Improvement Permit – not to exceed sixty months.

Signed: * Dina Baker date 5-21-02 Installed by: Larry Beam

Improvement Permit by: Wesley Sparks R.S. date 5/21/02 Operation Permit by: Wesley Sparks R.S. date 11/26/02

Authorization to Construct by: Wesley Sparks R.S. date 5/21/02 Existing System Inspection by: date

HEALTH DEPT. COPY: WHITE OWNER COPY (FINAL): YELLOW OWNER COPY (INITIAL): PINK