IREDELL COUNTY HEALTH DEPARTMENT

STATESVILLE 704-878-5305 $130 MOORESVILLE 704-664-5281

IMPROVEMENT PERMIT / AUTHORIZATION TO CONSTRUCT / OPERATION PERMIT / EXISTING SYSTEM INSPECTION

PERMIT# 125634 PIN# 4685 14 6355 DATE 1/13/05

OWNER OR CONTRACTOR Fred Ervin PHONE: Business 704-664-5418 Home

ADDRESS 380 Mackwood Rd. Mooresville, NC. 28115

LOCATION 746 Patterson Farm Rd.

SUBDIVISION N/A BLOCK / SECTION LOT N/A LOT AREA SITE CLASS PS DESIGN FLOW 240 L.T.A.R. .25

Septic Tank: 1000 Gallons; STB 353 Date

Pump Tank: Gallons; PT Date

Pump Make: Model 960 Serial No. 32c

Nitrification Field: No Fields 1 Square Feet 480 Linear Feet 240

No Lines 4 @ 80' Trench Width 3 Max Trench Bottom Depth 3' Gravel Depth No

☒ New System ☐ Repair System Type: I, II, III, IV, V, VI

System Description: GRAV - 25% REDUCED

Repair System Description: SAME

Maintenance Agreement Required: ☐ Yes ☒ No

☐ House/Mod. Home No. Bedrooms 2

☒ Mobile Home No. Bathrooms 1

☐ Business No. Employees

☐ Other

☐ Slab ☒ Crawl Space ☐ Basement w/plumbing ☐ Basement w/o plumbing

Water Supply: ☒ Individual ☐ Public ☐ Community


Comments:/Conditions:

Comments:/Conditions:


4@80'x3' Conventional

1"=50'

INITIAL SITE SKETCH

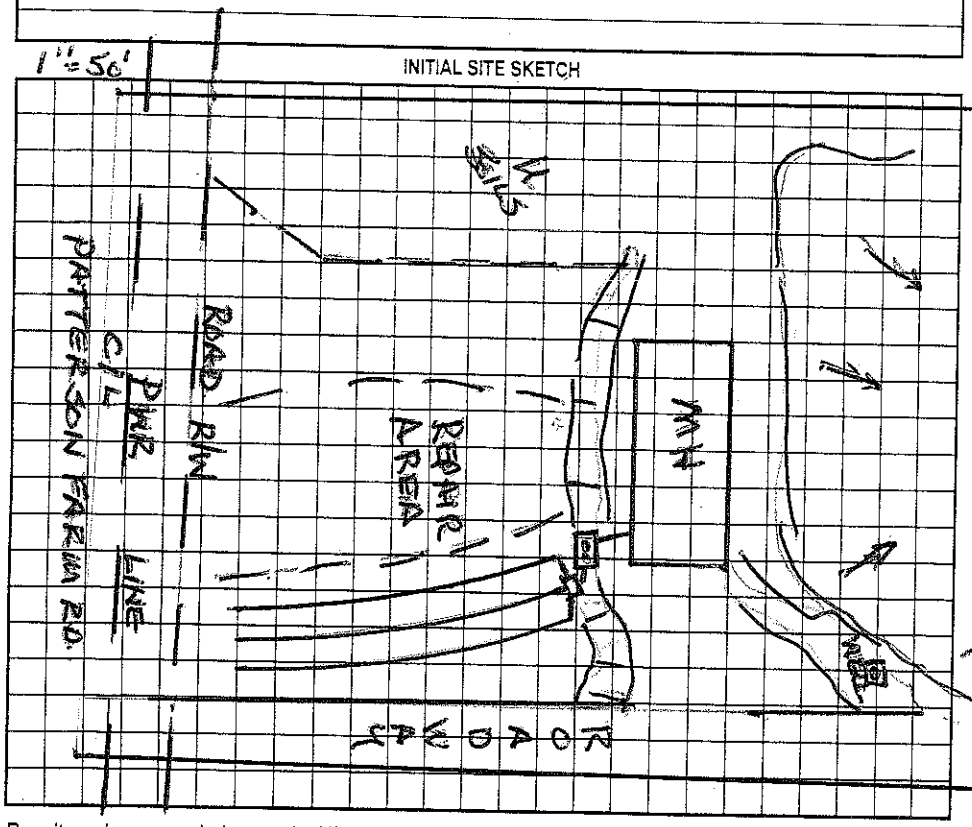

AS BUILT SKETCH

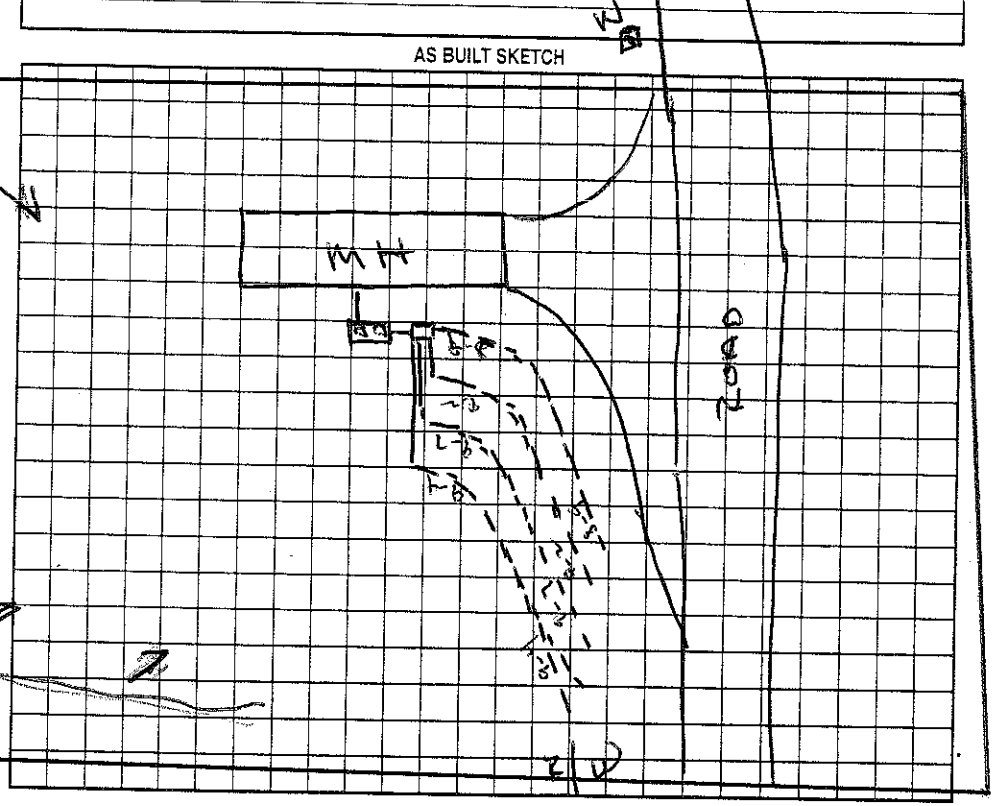

Permit can be suspended or revoked if any false information is supplied toward securing the permit/any unauthorized changes are made to the site/any unauthorized changes are made in the installation of the system. Improvement Permit with plat valid without expiration. Improvement Permit with site plan valid for sixty months. Authorization to Construct is valid for a period equal to that of Improvement Permit – not to exceed sixty months.

Signed: * F. A. Ervin date

Improvement Permit by: Wesley Sparks R.S. date 1/13/05

Authorization to Construct by: Wesley Sparks R.S. date 1/13/05

Installed by: F & Ervin

Operation Permit by: Wesley Sparks R.S. date 2/8/05

Existing System Inspection by: date

HEALTH DEPT. COPY: WHITE OWNER COPY (FINAL): YELLOW OWNER COPY (INITIAL): PINK