IREDELL COUNTY HEALTH DEPARTMENT

STATESVILLE 704-878-5305 MOORESVILLE 704-664-5281

IMPROVEMENT PERMIT / AUTHORIZATION TO CONSTRUCT / OPERATION PERMIT / EXISTING SYSTEM INSPECTION

PERMIT # 157770 PIN # 4685-14-7004 DATE 3-8-10

OWNER or APPLICANT BOBBY JOHNSON PHONE: Business 704-798-4642 Home:

OWNER or APPLICANT ADDRESS 738 PATTERSON FARM RD

LOCATION / DIRECTIONS HWY 3, TL PATTERSON FARM, ON R

SUBDIVISION — BLOCK / SECTION — LOT # — LOT AREA 6.44 AC DESIGN FLOW 360 GPD L.T.A.R. .3

Septic Tank 1000 Gallons: STB 794 Date 4-9-11

Pump Tank — Gallons: P T — Date —

Pump Make — Model — Serial # —

Nitrification Field No Fields 1 No Lines 4 Linear Feet 300'

Trench Width 36" Max. Trench Bottom Depth 36" Gravel Depth —

☒ New System ☐ Repair ☐ Expansion System Type I (II) III IV V VI

System Description: GRAVITY 25% RED

Repair System Description: SAME

Maintenance Agreement Required ☐ YES ☒ NO

☒ GRAVITY ☐ PRESSURE

☒ Residence No. Bedrooms 3

☐ Business No. Persons —

☐ Other No. Employees —

☐ Slab ☐ Crawl Space

☒ Basement w/plumbing ☐ Basement w/o plumbing


Water Supply: ☒ Private ☐ Public ☐ Community

Comments / Conditions


15-CM (5') PER LINE

Comments / Conditions 1) MEET ALL REQUIRED SETBACKS
2) GARAGE TO HAVE NO PLUMBING

INITIAL SITE SKETCH

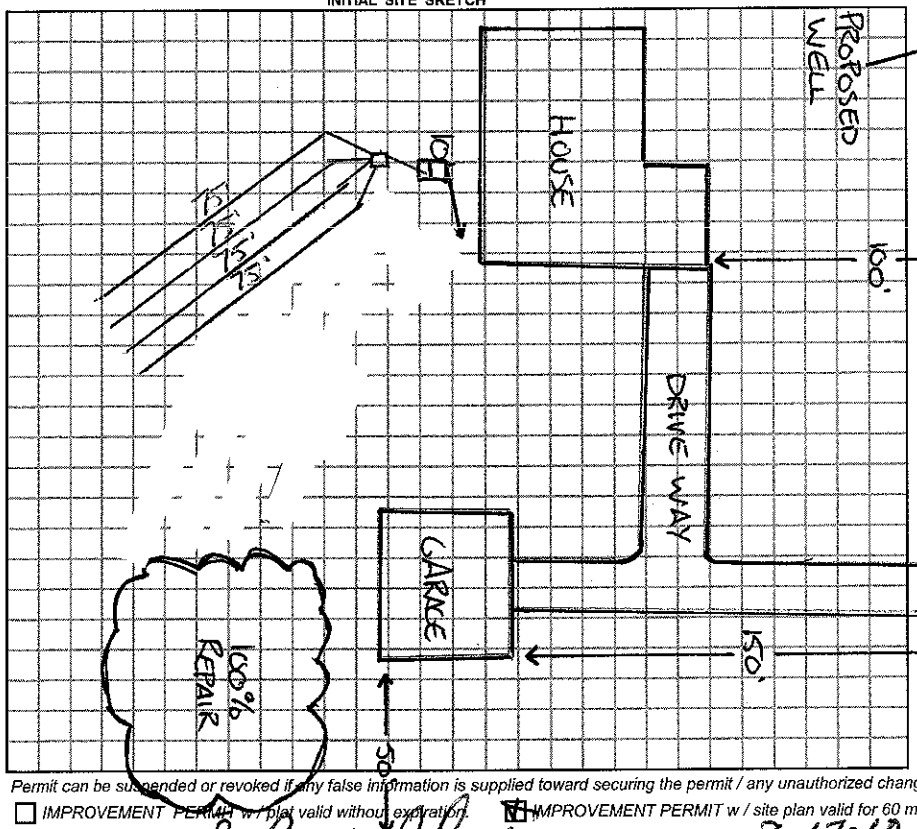

AS BUILT SKETCH

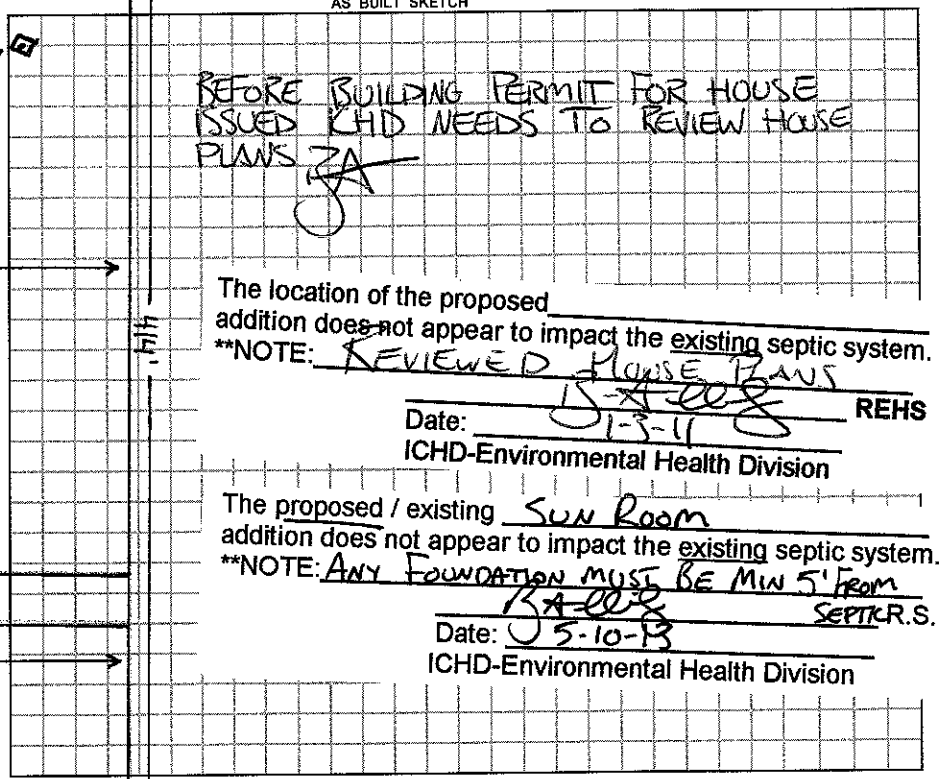

The location of the proposed addition does not appear to impact the existing septic system.
**NOTE: REVIEWED HOUSE PLANS
JA-EHS REHS
Date: 1-3-11
ICHD-Environmental Health Division

The proposed / existing SUN ROOM addition does not appear to impact the existing septic system.
**NOTE: ANY FOUNDATION MUST BE MIN 5' FROM SEPTIC R.S.
JA-EHS
ICHD-Environmental Health Division

Permit can be suspended or revoked if any false information is supplied toward securing the permit / any unauthorized changes are made to the site / any unauthorized changes are made in the installation of the system.

☐ IMPROVEMENT PERMIT w / plat valid without expiration ☒ IMPROVEMENT PERMIT w / site plan valid for 60 mos. ☒ AUTHORIZATION TO CONSTRUCT valid for period equal to IMPROVEMENT PERMIT-not to exceed 60 mo.

~~Owner / Applicant Signature:~~ Bobby Johnson Date 7-17-10

Improvement Permit by: JA-EHS REHS Date 3-8-10

Authorzation to Construct by: JA-EHS REHS Date 3-16-10

Installed by: CURT DUNNING

Operation Permit by: JA-EHS REHS Date: 8-24-11

Existing System Inspected by: Date:

YOU SHOULD CONTACT A LOCATOR SERVICE PRIOR TO ANY EXCAVATION.

WHITE COPY Environmental Health YELLOW COPY (Final) Owner / Applicant PINK COPY (Initial) Owner / Applicant