IREDELL COUNTY HEALTH DEPARTMENT

PJB

Statesville Office (704) 878-5305 | Mooresville Office (704) 660-3625

PERMIT # 244203

SEPTIC IMPROVEMENT PERMIT / AUTHORIZATION TO CONSTRUCT / OPERATION PERMIT / EXISTING SYSTEM

PIN # 4685151610

APPLICANT/OWNER: Lynnease Armstrong | APPLICANT ADDRESS: 792 Patterson Farm Rd. Mooresville, NC

SITE ADDRESS: 792 Patterson Farm Rd. Mooresville, NC | PHONE: 704-902-3648 | ALT. PHONE —


SITE DIRECTIONS: NC 3(S) → Lon Williford → Ron Linwood → Ron Patterson Farm → lot on L | SAP CONTROLLED: ☑ YES ☐ NO

SUBDIVISION: — | SECTION: — | LOT # — | LOT AREA: 1ac | DESIGN FLOW: 360gpd | L.T.A.R.: .3

Septic Tank 1000 (gal)	STB 760	Date 8-25-18	☑ New System ☐ Repair ☐ Expansion	System Type: I II III IV V VI	☑ Residence	No. Bedrooms 3	Water Supply
Pump Tank (gal)	PT	Date	System Description: 25% reduction		☐ Business	No. Persons 6	☑ Private
Pump Make	Model	Serial #	Repair System Description: gravity 50% reduction		☐ Other	No. Employees	☐ Public
# Nitrification Fields 1	# Lines 4	Linear Ft 300'	Maintenance Agreement Required:	☐ YES ☑ NO	☐ Slab	☑ Crawl Space	☐ Community
Trench Width 36"	Trench Bottom Depth(Low side) 32"/36" highs	Gravel Depth —	☑ GRAVITY	☐ PRESSURE	☐ Basement w/plumbing	☐ Basement w/o plumbing	

Comments / Conditions: Drive cannot exceed 10' from property line.* Install 25% reduction with serial distribution. Ok to cheat contour up to 3". Septic tank must maintain 5' from house. * Property must be recorded prior to issuing AC ok 7-17-19

INITIAL SITE SKETCH

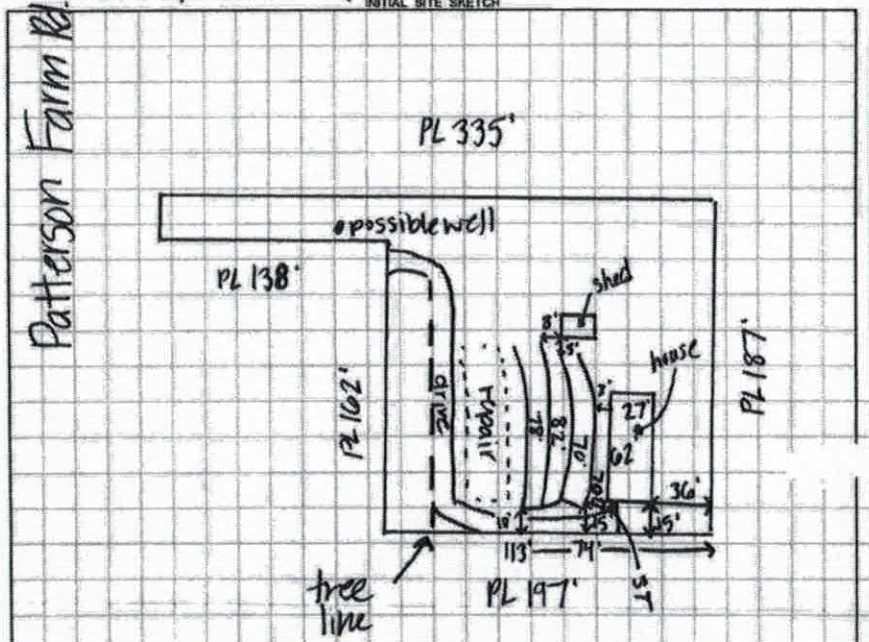

AS BUILT SKETCH

Permit can be suspended or revoked if any false information is supplied toward securing the permit / any unauthorized changes are made to the site / any unauthorized changes are made in the installation of the system. CONTACT A LOCATOR SERVICE PRIOR TO ANY EXCAVATION

☐ IMPROVEMENT PERMIT with plan valid without expiration. ☑ IMPROVEMENT PERMIT with site plan valid for 60 mos. ☑ AUTHORIZATION TO CONSTRUCT valid for period equal to IMPROVEMENT PERMIT--not to exceed 60 mo.

Owner / Applicant Signature: John B Armstrong Date: 7-17-19 | Installed by: Craig Thompson

IMPROVEMENT PERMIT by: Kayla Wilson Date: 6-18-19 | OPERATION PERMIT by: Date: 11-4-19

AUTHORIZATION TO CONSTRUCT by: Kayla Wilson Date: 7-17-19 | Existing System Inspected by: Date:

FOR SEPTIC FINAL INSPECTION: CALL 704-664-3703 between 8am-9am the day t[illegible]ection is needed. Be sure to speak with an inspector to confirm your inspection time.

PJB

IREDELL COUNTY HEALTH DEPARTMENT

Statesville Office (704) 878-5305 | Mooresville Office (704) 660-3625 | PERMIT # 244203

SEPTIC IMPROVEMENT PERMIT / AUTHORIZATION TO CONSTRUCT / OPERATION PERMIT / EXISTING SYSTEM

PIN # 4685151293

APPLICANT/OWNER: Lynnease Armstrong | APPLICANT ADDRESS: 792 Patterson Farm Rd. Mooresville, NC

SITE ADDRESS: 792 Patterson Farm Rd. Mooresville, NC | PHONE: 704-902-3648 | ALT. PHONE —

SITE DIRECTIONS: NC 3(S) → L on Williford → R on Linwood → R on Patterson Farm → lot on L | SAP CONTROLLED: ☑ YES ☐ NO


SUBDIVISION: — | SECTION: — | LOT #: — | LOT AREA: 1ac | DESIGN FLOW: 360gpd | L.T.A.R.: .3

Septic Tank	1000 (gal)	STB	Date	☑ New System ☐ Repair ☐ Expansion	System Type: I II (III) IV V VI	☑ Residence	No. Bedrooms 3
Pump Tank	(gal)	PT	Date	System Description:	25% reduction	☐ Business	No. Persons 6
Pump Make		Model	Serial #	Repair System Description:	gravity 50% reduction	☐ Other	No. Employees
# Nitrification Fields	1	# Lines 4	Linear Ft 300'	Maintenance Agreement Required:	☐ YES ☑ NO	☐ Slab	☑ Crawl Space
Trench Width	36"	Trench Bottom Depth(Low side)	32"/36" high side	Gravel Depth —	☑ GRAVITY ☐ PRESSURE	☐ Basement w/plumbing	☐ Basement w/o plumbing

Water Supply: ☑ Private ☐ Public ☐ Community

Comments / Conditions: Drive cannot exceed 10' from property line.* Install 25% reduction with serial distribution. Ok to cheat contour up to 3". Septic tank must maintain 5' from house. * Property must be recorded prior to issuing AC ✓ 7-17-19

INITIAL SITE SKETCH

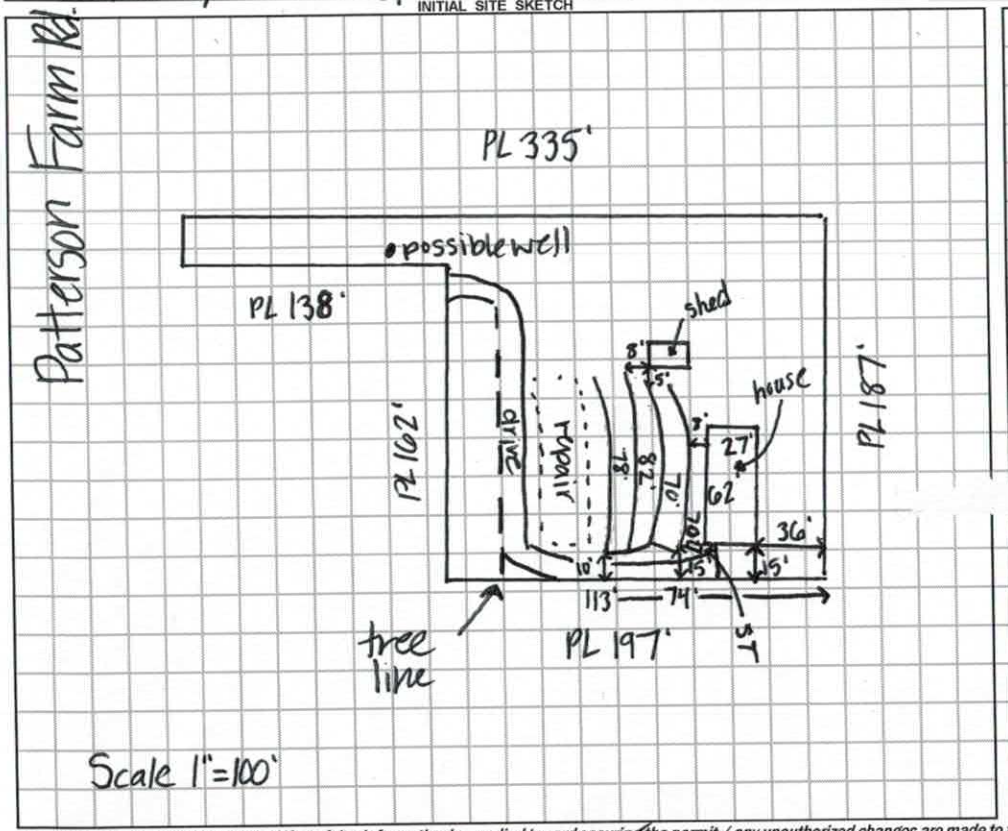

AS BUILT SKETCH

Permit can be suspended or revoked if any false information is supplied toward securing the permit / any unauthorized changes are made to the site / any unauthorized changes are made in the installation of the system. **CONTACT A LOCATOR SERVICE PRIOR TO ANY EXCAVATION**

☐ **IMPROVEMENT PERMIT** *with plat valid without expiration.* ☑ **IMPROVEMENT PERMIT** *with site plan valid for 60 mos.* ☑ **AUTHORIZATION TO CONSTRUCT** *valid for period equal to IMPROVEMENT PERMIT--not to exceed 60 mo.*

Owner / Applicant Signature: John B Armstrong Date: 7-17-19 | Installed by:

IMPROVEMENT PERMIT by: Kayla Wilson Date: 6-18-19 | OPERATION PERMIT by: Date:

AUTHORIZATION TO CONSTRUCT by: Kayla Wilson Date: 7-17-19 | Existing System Inspected by: Date:

FOR SEPTIC FINAL INSPECTION: CALL 704-664-3703 between 8am-9am the day t[hat] [ins]pection is needed. Be sure to speak with an inpsector to confirm your inspection time.

DEPARTMENT OF HEALTH AND HUMAN SERVICES
DIVISION OF PUBLIC HEALTH, ENVIRONMENTAL HEALTH SECTION
ON-SITE WATER PROTECTION BRANCH

Sheet 1 of 1
PROPERTY ID #: 4685151293
COUNTY: Iredell


SOIL/SITE EVALUATION
for ON-SITE WASTEWATER SYSTEM
(Complete all fields in full)

OWNER: Lynnease Armstrong
APPLICATION DATE 4-30-19
ADDRESS: 742 Patterson Farm Rd
DATE EVALUATED: 6-14-19
PROPOSED FACILITY: SFR
PROPOSED DESIGN FLOW (.1949): 360gpd
PROPERTY SIZE: 1ac
LOCATION OF SITE: NC 3 5 → L on Williford → R on Linwood → R on Patterson Farm → lot on L
PROPERTY RECORDED: no
WATER SUPPLY: ☑ Private ☐ Public ☑ Well ☐ Spring ☐ Other
EVALUATION METHOD: ☐ Auger Boring ☑ Pit ☐ Cut
TYPE OF WASTEWATER: ☑ Sewage ☐ Industrial Process ☐ Mixed

PROFILE #	.1940 LANDSCAPE POSITION/ SLOPE %	HORIZON DEPTH (IN.)	SOIL MORPHOLOGY (.1941) .1941 STRUCTURE/ TEXTURE	.1941 CONSISTENCE/ MINERALOGY	OTHER PROFILE FACTORS .1942 SOIL WETNESS/ COLOR	.1943 SOIL DEPTH	.1956 SAPRO CLASS	.1944 RESTR HORIZ	PROFILE CLASS & LTAR
1	7% LS	0-10	WSBK CL	Fr,SS,SP,SE	—	64	0-10 many SAP inc		PS .3
		10-64	LS SAP	Fr-Fi,NS,NP			10-64 few-com RC SAP		
2	9% LS	0-10	compacted	—	—	61	10-61 com RC SAP		PS .3
		10-61	SL SAP	Fr-Fi,NS,NP					
3	7% LS	0-10	WSBK CL	Fr,SS,SP,SE	—	49	10-49 com RC SAP		PS .3
		10-49	LS SAP	Fr-Fi,NS,NP					
		49-64	RC SAP	Fi-VFi					
4	6% LS	0-11	WSBK CL	Fr,S,P,SE	48-62" few YB mottles	48	11-48 com RC SAP		PS .25
		11-48	SL SAP	Fr-Fi,NS,NP					
		48-62	RC SAP	Fi-VFi					

DESCRIPTION	INITIAL SYSTEM	REPAIR SYSTEM
Available Space (.1945)	PS	PS
System Type(s)	III	III
Site LTAR	.3	.25

OTHER FACTORS (.1946): PS
SITE CLASSIFICATION (.1948): PS
EVALUATED BY: Kayla Wilson
OTHER(S) PRESENT:

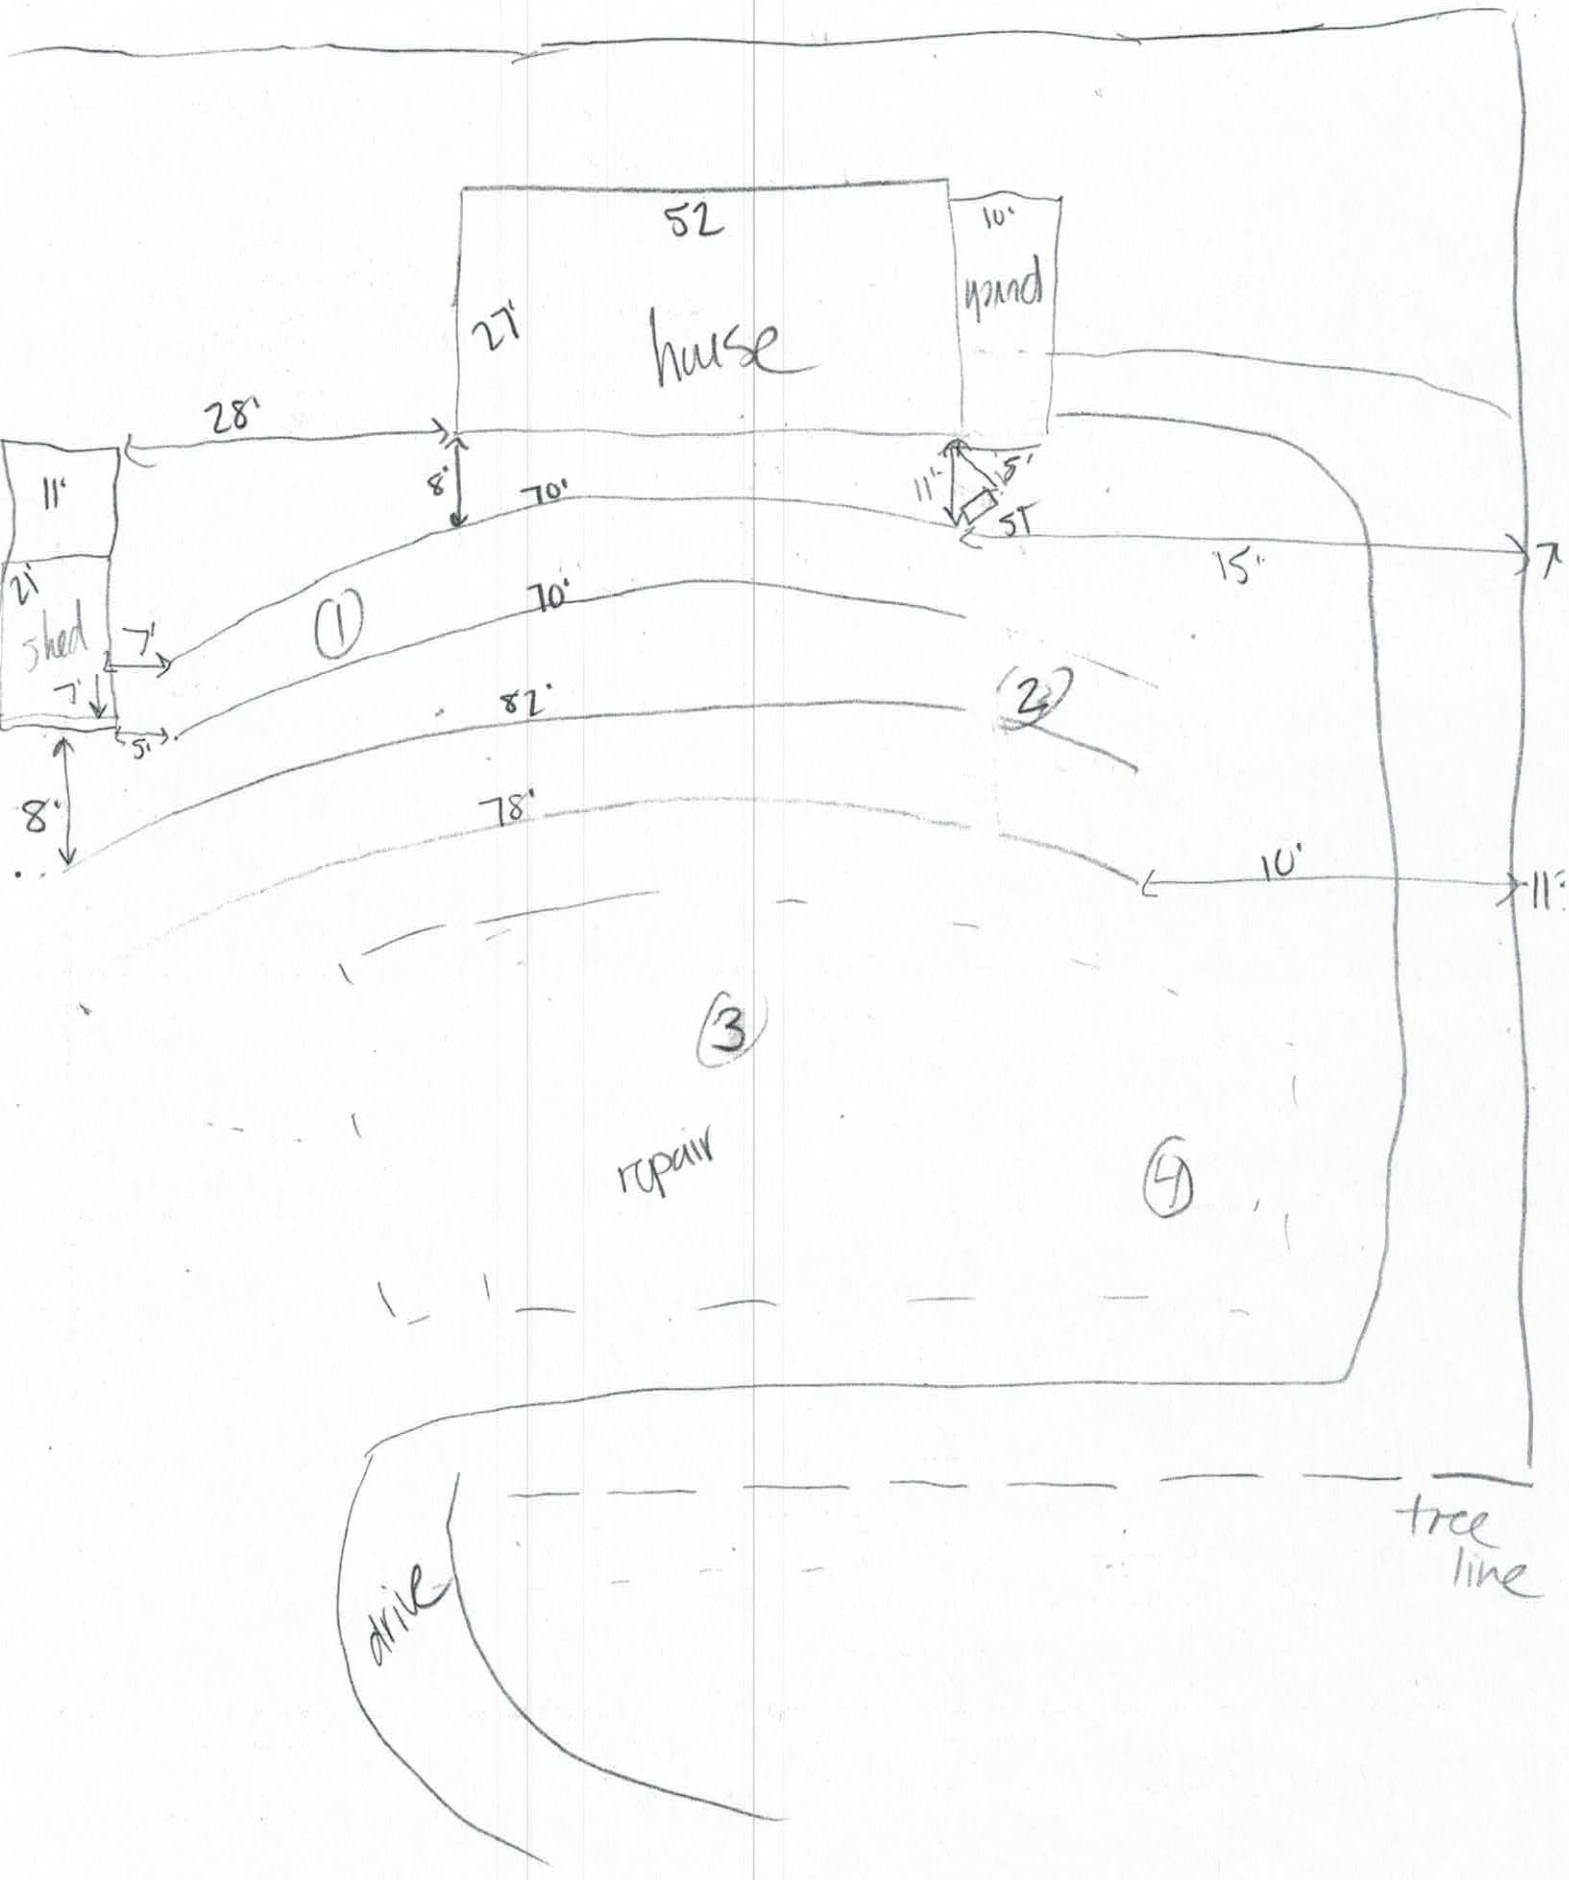
52
10'
27'
house
porch
28'
11'
8'
70'
11'
5'
5T
15'
21'
shed
7'
7'
5'
70'
82'
78'
8'
10'
11'
1
2
3
4
repair
drive
tree line

#2449&05
pd. $500.00
5-13-19

IREDELL COUNTY DEPARTMENT of ENVIRONMENTAL HEALTH

APPLICATION FORM

Application For: ( ) New Well Permit ( ) Well Repair Permit ( ) Well Abandonment
(X) Septic Improvement Permit ( ) Authorization to Construct ( ) Existing System Inspection ( ) Septic System Repair

THE ABOVE PERMIT DOCUMENTS WILL BECOME INVALID IF INFORMATION PROVIDED ON THIS APPLICATION IS FALSIFIED OR CHANGED, OR IF THE SITE IS ALTERED. THE IMPROVEMENT PERMIT IS VALID FOR EITHER 60 MONTHS OR WITHOUT EXPIRATION DEPENDING UPON DOCUMENTATION SUBMITTED. APPLICATION WITH SITE PLAN 60 MONTHS, APPLICATION WITH COMPLETE, SCALED PLAT WITHOUT EXPIRATION. SEE 15A NCAC 18A .1937(f) FOR DETAILS.

Page 2: *Site Plan Worksheet* form MUST accompany this application

The following optional attachments may also be submitted: ( ) Survey Plat, scaled no more than 1 inch = 60 feet
( ) Custom Site Plan, scaled no more than 1 inch = 60 feet

Place an (X) beside whichever is submitted if applicable

Applicant Information: (PRINT CLEARLY)

Applicant Name: Lynnese D Armstrong **Address:** 792 Patterson Farm Rd **Zip:** 28115

Applicant Email: LArmstrong01@windstream.net **Phone:** 704 902 3648 **Alt. Phone:** _____

Owner Name: Earl F. Armstrong **Address:** 795 Patterson Farm **Zip:** 28115

Owner Email: Larmstrong01@windstream.net **Phone:** 2046643255 **Alt. Phone:** _____

Property Information:

Street Address: 79 LOT 792 Patterson Farm Rd Mooresville NC 28115

Subdivision Name: _____ **Section/Phase:** _____ **Lot Number:** _____

Driving Directions: Hwy 150/152 towards China Grove, Turn Right on Mooresville Draystrip Rd (W. Kinsow Rd), Go to Cantrai light, Cross over to Patterson Farm Rd. Property is across from 795 Patterson Farm

Site Development Information: *(check or complete ALL that apply*

CHECK FOUNDATION TYPE

(X) New Single Family Residence
( ) New Multi-Family Residence
( ) Accessory Building
( ) Bedroom(s) Addition
( ) Repair to failing septic system ___ Tank ___ Drain lines **Describe Problem:** _____

Maximum Number of Bedrooms: 3
Maximum Number of Occupants: 1
( ) Swimming Pool
( ) Other Addition/Structure: _____

( ) Crawl Space Foundation
( ) Concrete Slab Foundation
( ) Basement with Plumbing
( ) Basement without Plumbing

Non-Residential Site Development: **Type of Business:** _____
Square Footage of Building: _____ **Max. Number of Employees:** _____ **Max. Number of Seats/Beds/Other:** _____

Water Supply: ( ) Replacement Well – Reason: _____
( ) Multi-connection Well **Number of Houses:** _____ **Number of Persons:** _____

( ) New Well ( ) Existing Well ( ) Community Well ( ) City Water ( ) Other Public Water

Desired Septic System Type: *(you may rank in order of preference)* **Year existing system installed:** _____

(X) No Preference ( ) Alternative ( ) Conventional ( ) Innovative ( ) Modified Conventional ( ) Other: _____

Please answer the following to the best of your ability:

( ) Yes (X) No **Does the site contain any jurisdictional wetlands?**
( ) Yes (X) No **Is any non-domestic sewage (i.e. industrial) to be generated?**
( ) Yes ( ) No **Is the site subject to approval by any other public agency?**

I have read this application and certify that the information provided herein is true, complete, and correct. Authorized county and state officials are granted right of entry to conduct necessary inspections to determine compliance with applicable laws and rules. I understand that I am solely responsible for the proper identification and labeling of all property lines and corners and making the site accessible so that a complete site evaluation can be performed.

Signature: Lynnese D Armstrong **DATE** 4-30-2019
Property owner or owner's legal representative signature (SIGNATURE REQUIRED)

IREDELL COUNTY DEPARTMENT OF ENVIRONMENTAL HEALTH

DOCUMENTATION TO AUTHORIZE AN OWNER'S LEGAL REPRESENTATIVE

(Check and sign only ONE of the options below)

1. * APPLICANT AND OWNER ARE THE SAME. * (*Sign here*) Lynnease D Armstrong

Applications for permits require the "signature of the owner or owner's legal representative" (15A NCAC 18A .1937). If the owner does not sign the application himself or herself, they can submit any one of the following documents to designate their legal representative: *Power of Attorney; Real Estate Contract; Estate executor; Bankruptcy trustee; Court ordered guardianship* In the absence of the above documentation, the property owner may provide the local health department with documentation that designates a legal representative. A property owner may:
Complete this form to document his or her legal representative, or provide his or her own form that contains the information in this form. If there are multiple property owners, then all property owners must sign the form that designates a legal representative.
By signing a form that designates a legal representative for purposes of 15A NCAC 18A .1937, the property owner authorizes that representative to act on their behalf in matters pertaining to the application and permitting process, including signing or receiving any application, document or permit. The owner retains full responsibility to meet all permit conditions specified by the local health department.

2. I, Earl F Armstrong, am the legal owner(s) of the property located at 792 Patterson Farm Rd, Mooresville NC, identified as

PIN (Parcel Identification Number) 4685-15-1293, located in Iredell County, North Carolina.

I do hereby authorize (**print legal representative/company name**) Lynnease D Armstrong, to act as an agent on my behalf in applying for/signing/obtaining any of the documents described below.

- Application for Improvement Permit (IP) / Authorization to Construct (AC)
- Improvement Permit (IP) / Authorization to Construct (AC)
- Application for soil-site evaluation (new/repair)
- Application/permit for private drinking water well/well abandonment
- Application for Compliance Inspection

I agree to abide by all decisions and/or conditions between the legal representative acting on my behalf and the Iredell County Department of Public Health, Environmental Health Division.

Earl F Armstrong
Signature of Owner(s)

4-30-2019
Date


Mooresville - Environmental Health
ronda.hart@co.iredell.nc.us
Fax: 704-662-3239
610 E. Center Avenue, Mooresville, NC 28115

Statesville - Environmental Health
adrienne.shea@co.iredell.nc.us
Fax: 704-871-3483
349 N. Center Street, Statesville, NC 28677

IREDELL COUNTY DEPARTMENT of ENVIRONMENTAL HEALTH

SITE PLAN WORKSHEET

SEE THE "SAMPLE SITE PLAN" BELOW. *INCOMPLETE SITE PLANS WILL BE RETURNED TO YOU FOR COMPLETION AND MAY RESULT IN A DELAY IN THE ISSUANCE OF YOUR SEPTIC SYSTEM OR WELL PERMIT!!!*

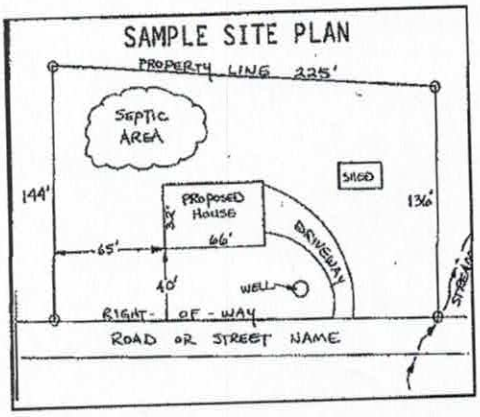

Place an (X) beside each item as you complete the site plan:


- ( ) Property Line measurements are clearly identified
- ( ) All proposed structures are indicated
- ( ) Front and side setbacks from property line
- ( ) Preferred driveway location
- ( ) Preferred well location
- ( ) Preferred septic system location
- ( ) North arrow, or other sufficient indicator of direction

Circle N/A on the following if appropriate:

Location of septic systems and wells within 100' of your property	N/A
Location of easements and rights of ways on your property	N/A
Location of any designated wetlands on the property	N/A

USE THIS SPACE TO DRAW YOUR SITE PLAN

Show: proposed house or business footprint, wells, water lines, patios, pools and decks, and any other item that will occupy space on the site

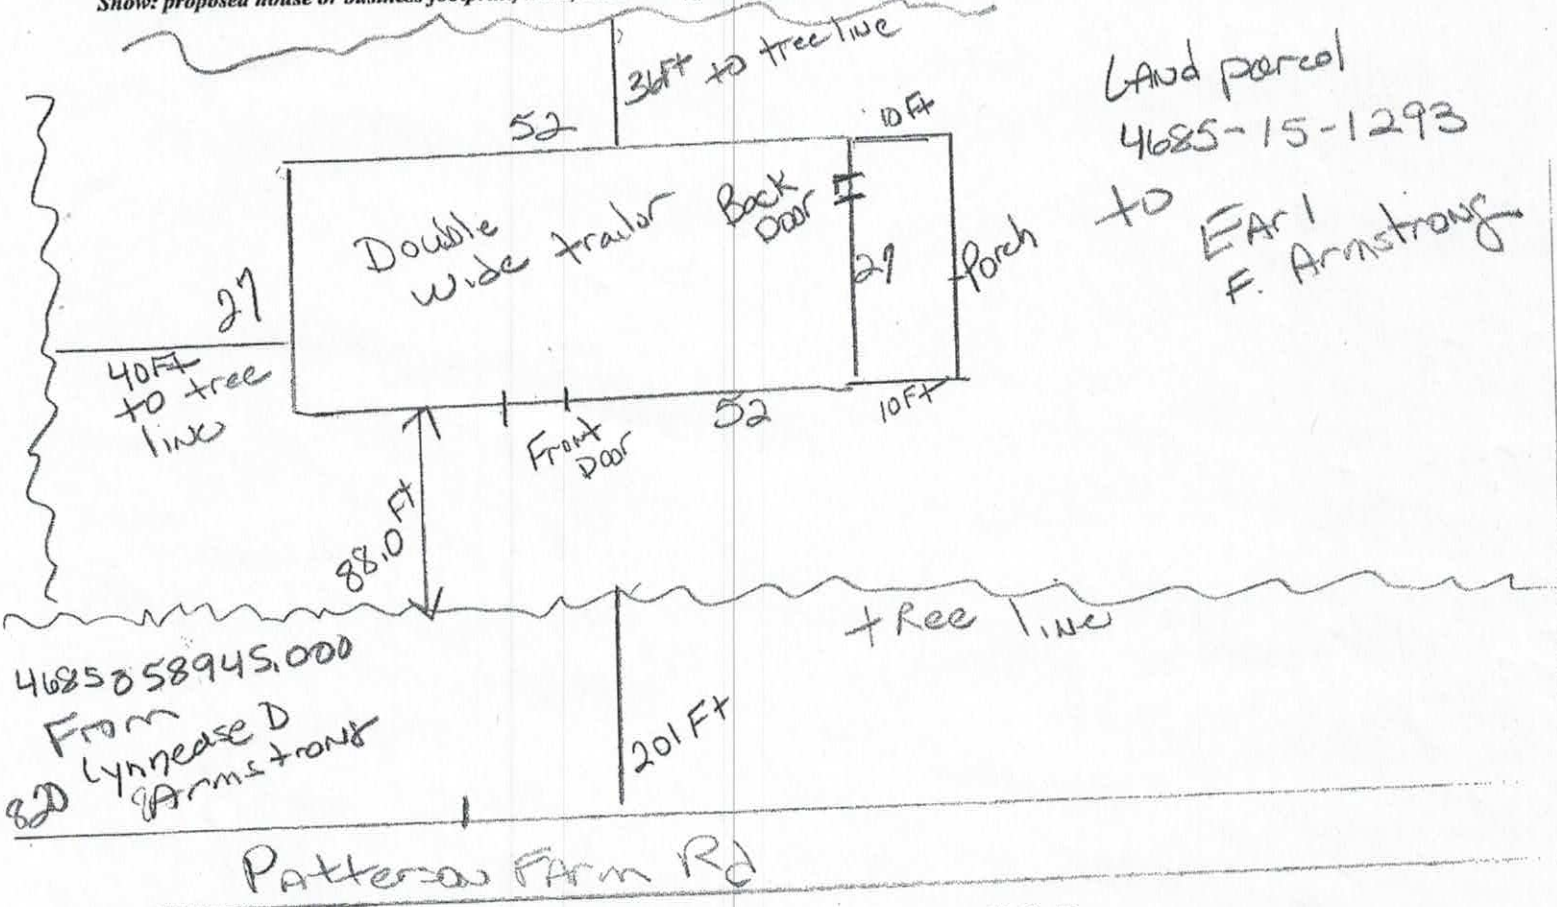

Signature: Lynnease D Armstrong
Property owner or owner's legal representative signature **(SIGNATURE REQUIRED)**

4-30-2019
DATE

I, JOEL H. PATTERSON III, CERTIFY THAT THIS PLAT WAS DRAWN UNDER MY SUPERVISION FROM AN ACTUAL SURVEY MADE UNDER MY SUPERVISION; DEED DESCRIPTION AND/OR MAP BOOK SEE ; PAGE NOTE #2 ; THAT THE BOUNDARIES NOT SURVEYED ARE CLEARLY INDICATED AS DRAWN FROM INFORMATION FOUND IN BOOK ; PAGE ; THAT THE RATIO OF PRECISION AS CALCULATED IS 1:10,000+; THAT THIS PLAT WAS PREPARED IN ACCORDANCE WITH THE STANDARDS OF PRACTICE FOR LAND SURVEYING IN NORTH CAROLINA (21 NCAC 56.1600). WITNESS MY ORIGINAL SIGNATURE, REGISTRATION NUMBER AND SEAL THIS 26 DAY OF MAY 2019.


JOEL H. PATTERSON III, PLS
LICENSE NUMBER: L-3717

NORTH CAROLINA PROFESSIONAL SEAL L-3717 LAND SURVEYOR JOEL H. PATTERSON, III

LEGEND

R/W = Right-of-Way
IPS = Set #4 Rebar
(W) = Proposed Well
(S) = Proposed Septic

LINE TABLE		
LINE	BEARING	DISTANCE
L1	N88°07'15"W	30.00'
L2	N02°39'49"E	25.00'
L3	S88°07'15"E	30.00'

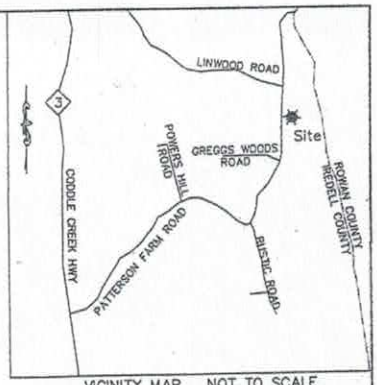

VICINITY MAP NOT TO SCALE

TAX ID: 4685-16-6184
LYNNEASE D ARMSTRONG
DB: 1413 PG: 2711

Found #4 Rebar
L3
L2
L1
S88°07'15"E 365.05' Total
335.05'
138.00'
IPS
N88°07'15"W 168.00' Total
S88°07'15"E 271.05' Tie Line
N01°52'45"E 162.06'
1.000 Acres
S01°53'09"W 187.06'
35.2'
House Box
36.6'
17.3'
N88°07'15"W 197.37'
S01°47'12"W 398.68' Tie Line
Deed Book 1413 Page 2708 Dated: 02/20/2003
R/W
PATTERSON FARM ROAD 60' R/W
S02°39'45"W 788.78' Tie Line
Found 1/2" Iron Pipe
Found 3/4" Iron Pipe

REMAINING PORTION OF
TAX ID: 4685-15-1293
EARL F ARMSTRONG JR
DB: 1413 PG: 2708

TAX ID: 4685-15-9068
EARNHARDT REAL PROPERTIES LLC
DB: 2391 PG: 1831

ROWAN COUNTY
IREDELL COUNTY

TAX ID: 4685-14-6757
JOHN B JR & KAY W CARRIGAN
DB: 1357 PG: 1457

GRAPHIC SCALE
100 0 50 100
(IN FEET)
1 inch = 100 ft.

SURVEYOR NOTES


1) ALL DIMENSIONS SHOWN ARE IN US SURVEY FEET AND DECIMALS THEREOF AND ARE HORIZONTAL GROUND DISTANCES UNLESS OTHERWISE INDICATED. AREA BY COORDINATE METHOD.
2) THIS SURVEY IS BASED ON DEED BOOK 1413 PAGE 2708 AS RECORDED AT THE IREDELL COUNTY REGISTER OF DEEDS.
3) THIS SURVEY WAS PREPARED WITHOUT THE BENEFIT OF A TITLE EXAMINATION BY AN ATTORNEY. THE PROPERTY MAY BE SUBJECT TO RECORDED OR UNRECORDED RIGHTS-OF-WAY, EASEMENTS, RESTRICTIVE COVENANTS OR CONDITIONS NOT OBSERVED OR SHOWN HEREON.
4) THIS LOT LIES WITHIN A SUBDIVISION THAT WAS PREVIOUSLY TIED TO THE NORTH CAROLINA GRID SYSTEM.
5) BASIS OF BEARINGS: DEED BOOK 1413 PAGE 2708 - DATED: FEBRUARY 20, 2003.
6) #4 REBAR AT ALL CORNERS, UNLESS OTHERWISE NOTED. ALL CORNERS "FOUND" or "SET" ARE FLUSH WITH THE GROUND, UNLESS OTHERWISE NOTED.
7) THE LOCATION OF UTILITIES AS SHOWN HEREON, WHETHER PUBLIC OR PRIVATE, ARE BASED ON THE LOCATION OF VISIBLE ABOVE GROUND APPURTENANCES ONLY. OTHER UTILITIES WHICH WERE NOT OBSERVED AND NOT SHOWN HEREON MAY EXIST. IT IS THE OWNERS/TENANTS RESPONSIBILITY PATTERSON LAND SURVEYING, P.A. CANNOT ASSUME RESPONSIBILITY FOR MISIDENTIFICATION OR OMISSION OF UNDERGROUND UTILITIES.
8) THIS SURVEY IS OF AN EXISTING PARCEL OR PARCELS OF LAND AND DOES NOT CREATE A NEW STREET OR CHANGE AN EXISTING STREET.
9) THIS PROPERTY LIES IN FLOOD ZONE "X" AS SHOWN ON FEDERAL EMERGENCY MANAGEMENT AGENCY (FEMA) FLOOD INSURANCE RATE MAP (FIRM) COMMUNITY PANEL 3710468500K, WITH AN EFFECTIVE DATE OF JUNE 16, 2009.

BOUNDARY SURVEY
OF
PORTION OF EARL FRANKLIN ARMSTRONG JR PROPERTY
792 PATTERSON FARM ROAD
CITY OF MOORESVILLE, CODDLE CREEK TOWNSHIP, IREDELL COUNTY, NC

Prepared For (Owner):
EARL FRANKLIN ARMSTRONG JR
781 PATTERSON FARM ROAD
MOORESVILLE, NC 28115

PATTERSON LAND SURVEYING, P.A.
NC LICENSE #: C-3390
P.O. BOX 5010, MOORESVILLE, NC 28117
PHONE: 704-663-0110 EMAIL: pattersonlandsurveying@gmail.com

Drawn By: MDH	Checked By: JHP	Scale 1" = 100'	Project No. 19045
Tax PIN: 4685-15-1293			Sheet No. 1 of 1
Date: May 30, 2019			
File: 19045_792PattersonFarmRd			

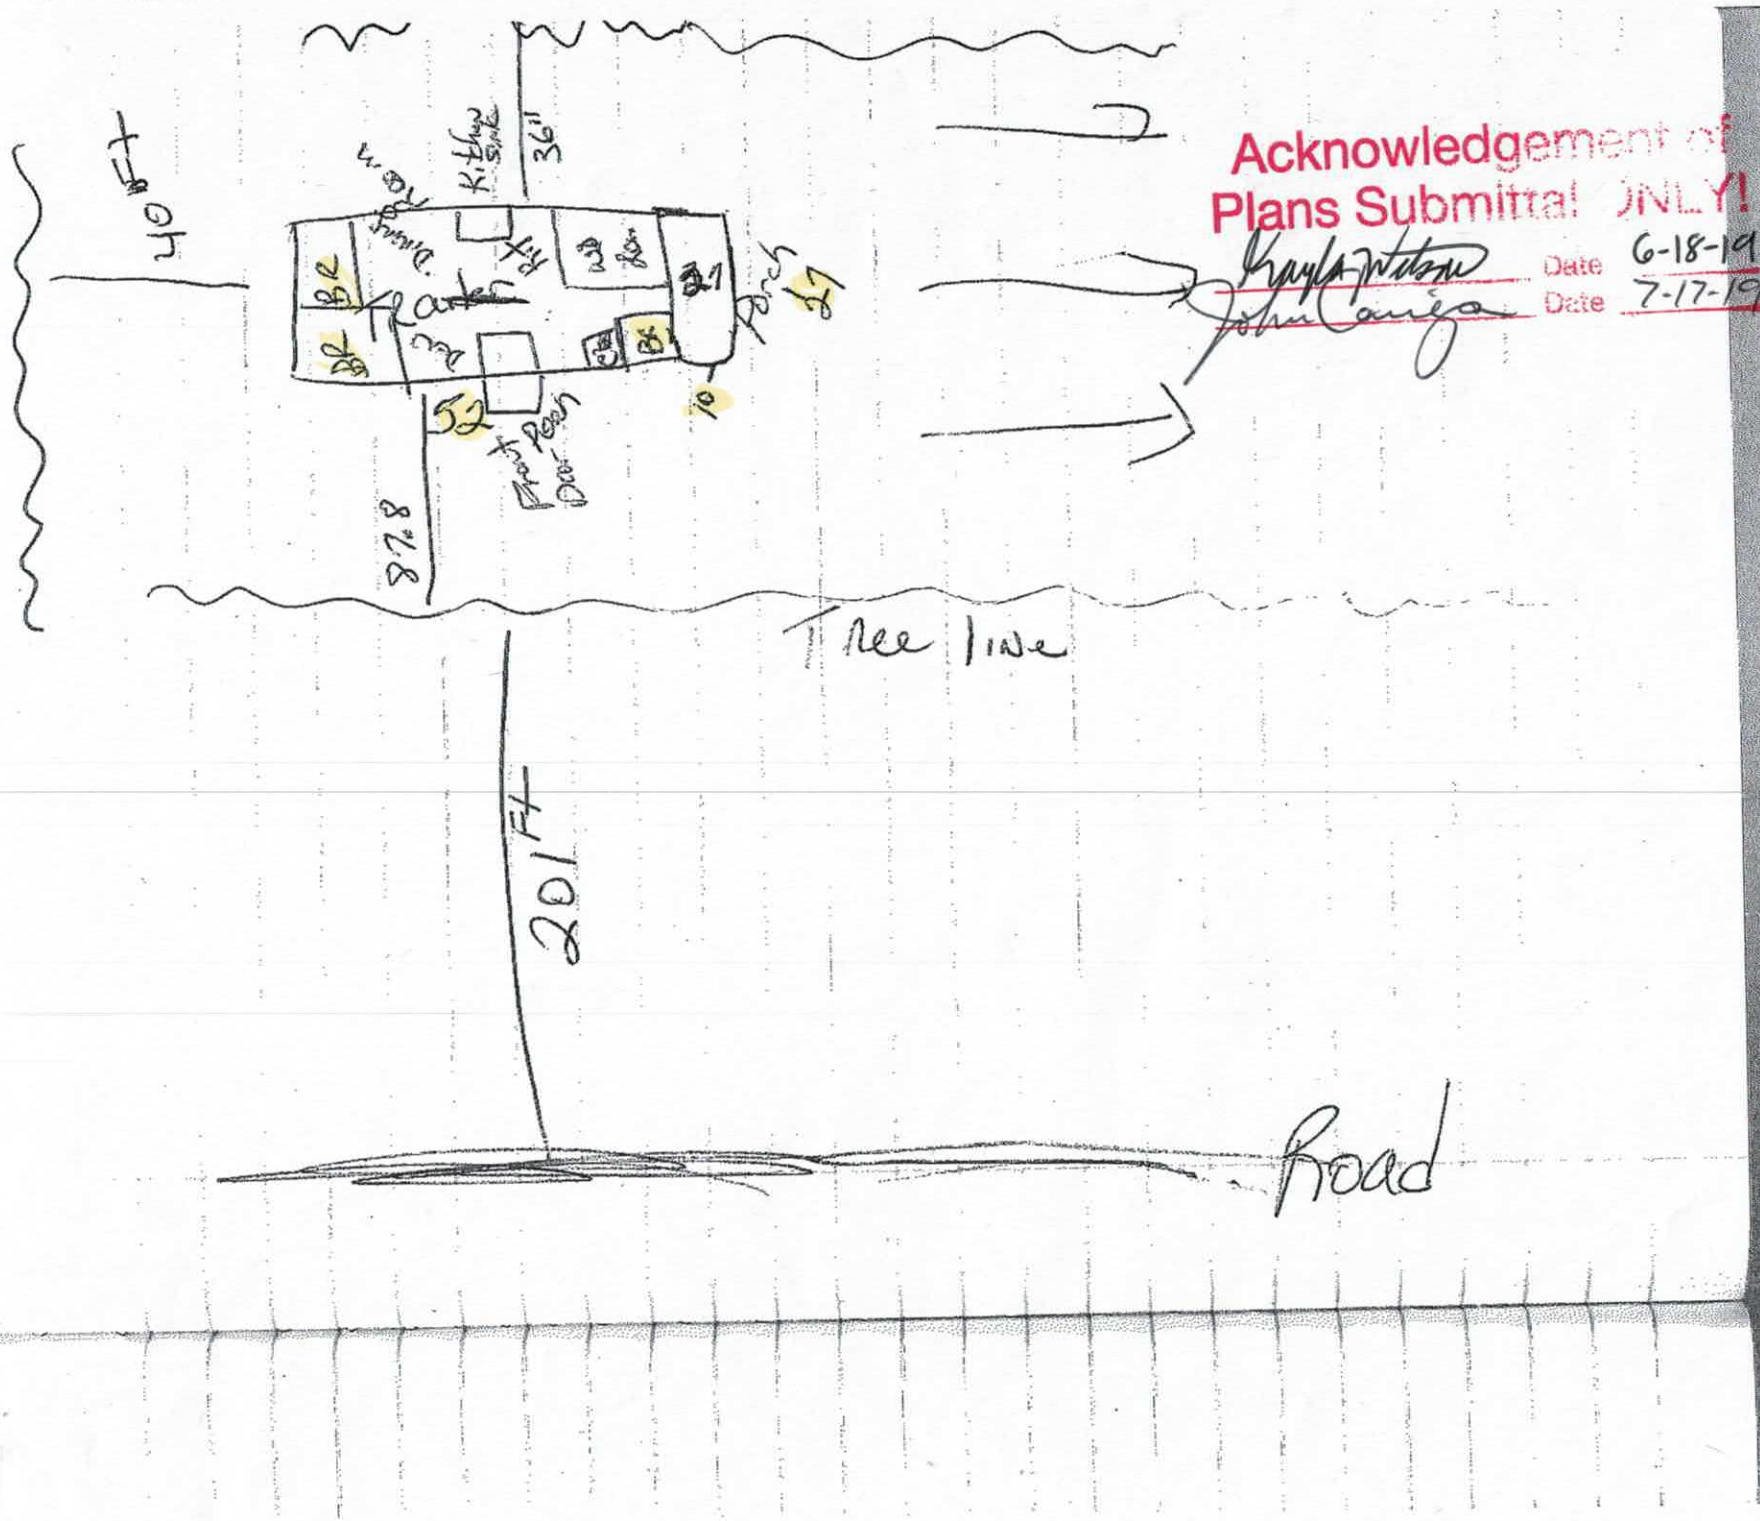
Acknowledgement of
Plans Submittal ONLY!
Date 6-18-19
Date 7-17-19
40 ft
36"
Kitchen Sink
W.D.
Laundry
Bed
Bed
Bed
Bath
Bath
21
Porch
17
52
10
Front Door Entry
87'8
Tree line
201 Ft
Road

IREDELL COUNTY

PO Box 788
349 North Center St.
Statesville, NC 28677

APPLICATION NUMBER
244203
Issue Date: 04/30/2019

ZONING PERMIT

Residential

Parcel Number	Street Address	Jurisdiction
4685151293.000	792 PATTERSON FARM ROAD, MOORESVILLE, NC 28115	IREDELL COUNTY

Owner Information	Applicant Information
Owner: ARMSTRONG EARL F JR	Applicant: ARMSTRONG, LYNNEASE
Address: 795 PATTERSON FARM RD	Address: 792 PATTERSON FARM RD
MOORESVILLE, NC 28115	MOORESVILLE, NC 28115
Phone:	Phone: 704-902-3648

Use Requested	Zone Code
NEW MOBILE HOME	RA

Lot Acreage	F Setback	B Setback	L Setback	R Setback	Watershed	Flood Zone
26.397					BOWC	AE

Remarks:

Accessory Mobile Home: Must meet requirement R8 of the LDC. Only one accessory mobile shall be permitted per lot or parcel. The lot or parcel shall contain sufficient land area for the principal residential structure or home and the accessory mobile home to be considered independent principal dwelling units with both individually meeting the minimum lot size and required setbacks. The mobile home cannot be used as a rental and only relatives including in-laws and son or daughter by legal adoption shall occupy the accessory mobile home.

The applicant certifies that there are no deed restrictions, contractual agreements or governmental regulations of any kind that interfere with or prohibit the use of the property or the use for which this permit is requested. The applicant further acknowledges that enforcement of deed restrictions, plat conditions and other contractual agreements will not be undertaken by Iredell County and is the sole responsibility of the affected parties.

Applicant: _____ Date: _____

Permit Number	175538	TOTAL FEES:	$ 77.25