# IREDELL COUNTY HEALTH DEPARTMENT

Authorization to Construct 4685-17-7702 10-1992

STATESVILLE 704-878-5305 MOORESVILLE 704-664-5281

## IMPROVEMENT PERMIT / ~~CERTIFICATE OF COMPLETION~~ / OPERATION PERMIT / EXISTING SYSTEM INSPECTION

PROPERTY DESCRIPTION NO. 067343 DATE 6/13/97 TAX MAP NO. 4685271962 Watershed: X Yes ( ) No

OWNER OR CONTRACTOR Bobel Gibson PHONE: Business 564-5370 Home WSTE BOW

ADDRESS PO Box 2272 Cornelius, NC. 28031

LOCATION Patterson Farm Rd. TR on Linwood Rd., 1st drive on (L)

SUBDIVISION _____ BLOCK / SECTION _____ LOT _____ LOT AREA 9.0 SITE CLASS. PS DESIGN FLOW 360 L.T.A.R. .3

Septic Tank: 1000 Gallons; STB 794 Date 10-10-00
Pump Tank: _____ Gallons; PT _____ Date _____
Pump Make: _____ Model _____ Serial No. _____
Nitrification Field: No Fields 1 Square Feet 1200 Linear Feet 400
No Lines 4 Trench Width 36" Max Trench Bottom Depth 36" Gravel Depth 12"

X New System ☐ Repair System Type: I, (II), III, IV, V, VI
System Description: CONVENTIONAL - DIST BOX
Repair System Description: SAME
Maintenance Agreement Required: ☐ Yes X No


X House/Mod. Home No. Bedrooms 3
☐ Mobile Home No. Bathrooms 2
☐ Business No. Employees ____
☐ Other _____
☐ Slab X Crawl Space ☐ Basement w/plumbing ☐ Basement wo/plumbing

Water Supply: X Individual ☐ Community ☐ Public


Comments: Keep drainlines on contour in direction shown.

Comments: Filter & riser installed

**INITIAL SITE SKETCH**

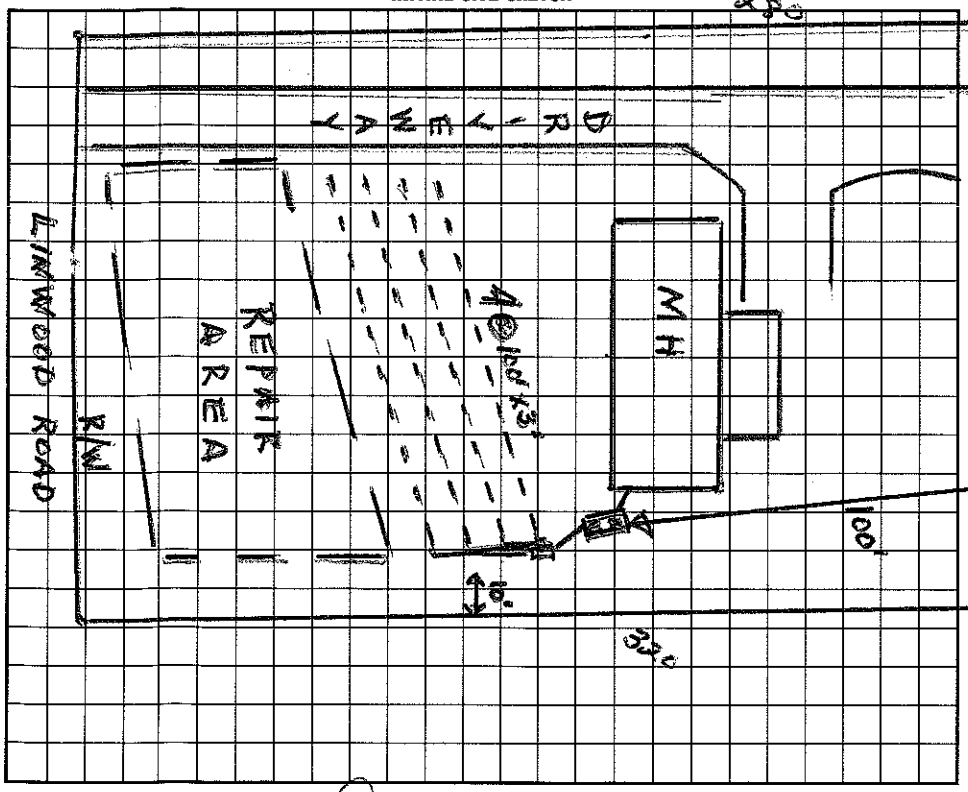


**AS BUILT SKETCH**

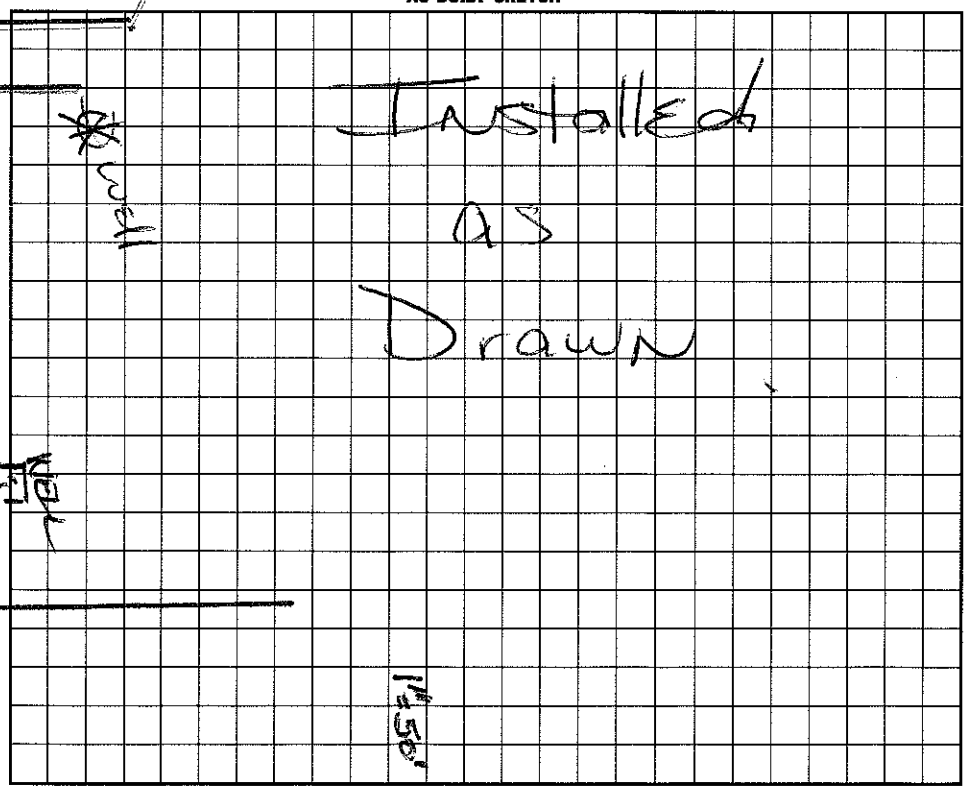


I understand that this permit can be suspended or revoked if any false information is supplied toward securing the permit/any unauthorized changes are made to the site/any unauthorized changes are made in the installation of the system. Improvement Permit is valid for 60 months from date of issuance.

Signed: X Bob Gibson

Improvement Permit by: Wesley Sparks RS date 6/13/97

Existing System Inspection by: Wesley Sparks date 6/13/97

Installed by: Big M RS

Certificate of Completion by: _____ date 1/16/2001

Operation Permit by: _____ date _____

HEALTH DEPT. COPY: WHITE INSPECTION COPY (FINAL): GREEN OWNER COPY (FINAL): YELLOW INSPECTION COPY (INITIAL): PINK OWNER COPY (INITIAL): GOLD