IREDELL COUNTY HEALTH DEPARTMENT

STATESVILLE 704-878-5305 | MOORESVILLE 704-664-5281

468518 # 4371

IMPROVEMENT PERMIT / CERTIFICATE OF COMPLETION / OPERATION PERMIT / EXISTING SYSTEM INSPECTION

PROPERTY DESCRIPTION NO. 17618 DATE 12/20/93 TAX MAP NO. 1E-A-1 Pt of. Watershed: ☑ Yes ☐ No

OWNER OR CONTRACTOR Donald Ray Bentley PHONE: Business Home 664-4525

ADDRESS Rt 3 Box 615 Mocksville, NC.

LOCATION Patterson Farm Rd., TL off Enochville Rd to Patterson, pass two houses, TR ondrive to new construction

SUBDIVISION No BLOCK / SECTION LOT LOT AREA ~2.14AC SITE CLASS. P DESIGN FLOW 360 L.T.A.R. .3

Septic Tank: 1000 Gallons; STB 525 Date 4/4/94

Pump Tank: Gallons; PT Date

Pump Make: Model Serial No.

Nitrification Field: No Fields 1 Square Feet 1200 Linear Feet 400

No Lines 3 Trench Width 3' Max Trench Bottom Depth 36" Gravel Depth 12

☑ New System ☐ Repair System Type: I, II, III, IV, V, VI

System Description: CONV - DIST BOX

Repair System Description:

Maintenance Agreement Required: ☐ Yes ☑ No

☑ House/Mod. Home No. Bedrooms 3

☐ Mobile Home No. Bathrooms 2.5

☐ Business No. Employees


☐ Other

☐ Slab ☐ Crawl Space ☐ Basement w/plumbing ☐ Basement wo/plumbing

Water Supply: ☑ Individual ☐ Community ☐ Public

Comments:


INITIAL SITE SKETCH

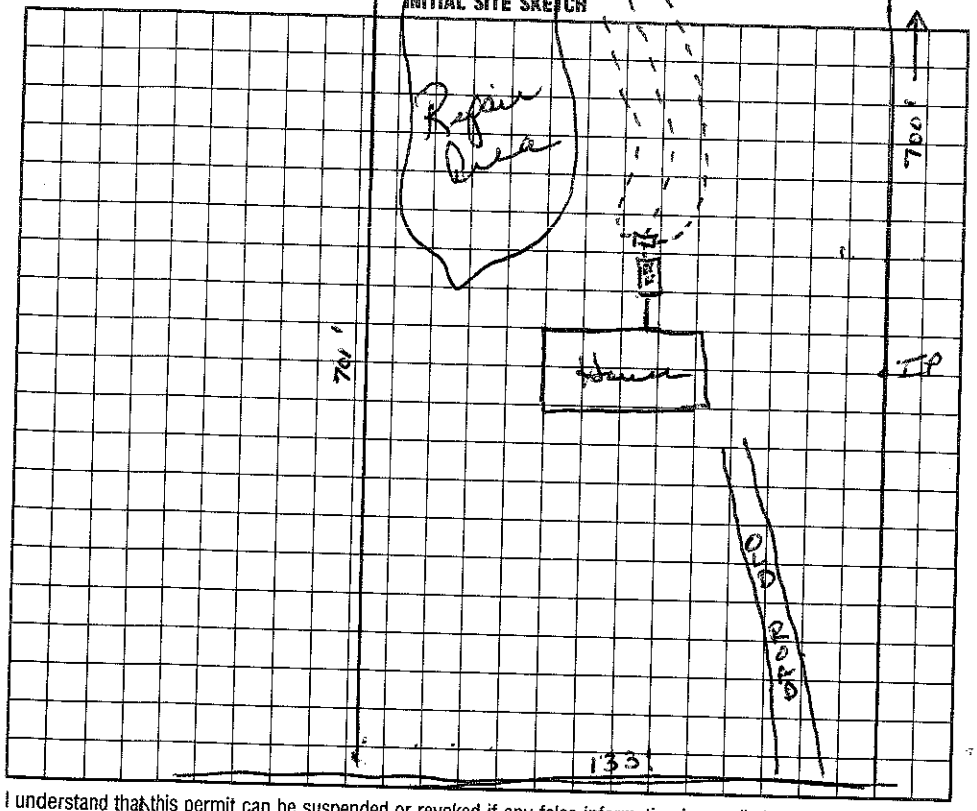

Comments:

installed as drawn

AS BUILT SKETCH

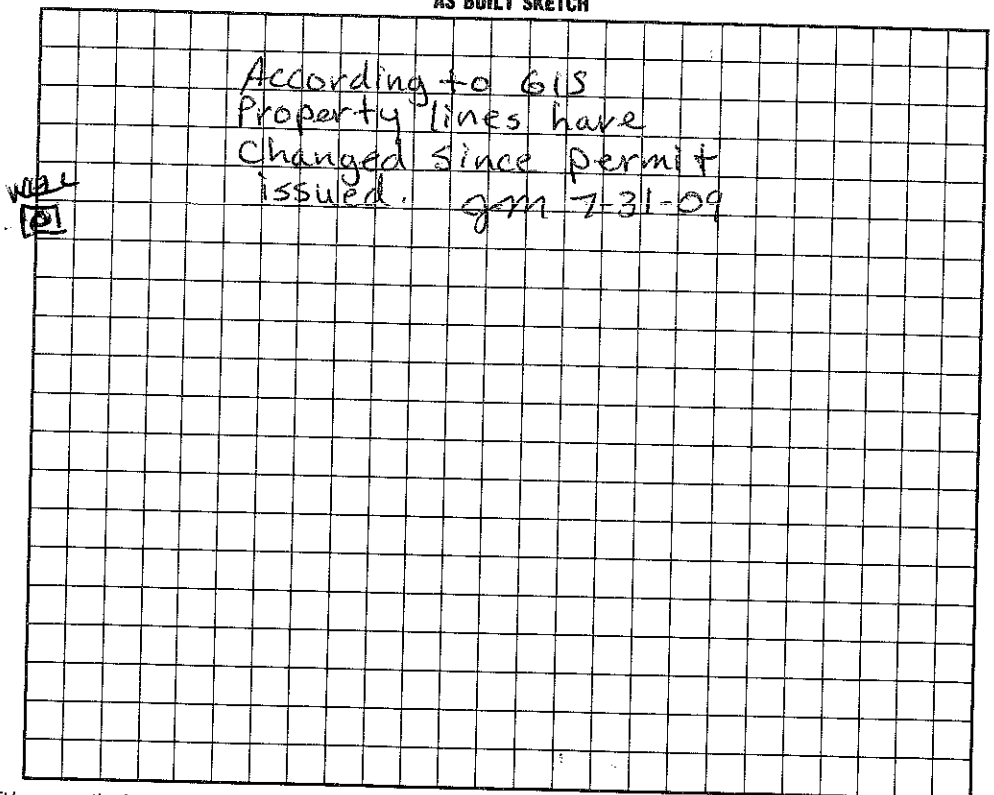

I understand that this permit can be suspended or revoked if any false information is supplied toward securing the permit/any unauthorized changes are made to the site/any unauthorized changes are made in the installation of the system. Improvement Permit is valid for 60 months from date of issuance. PATTERSON FARM RD.

Signed: Donald Ray Bentley

Improvement Permit by: Wesley Sparks R.S. date 12/20/93

Existing System Inspection by: date

Installed by: Delbert Boatright

Certificate of Completion by: Wesley Sparks R.S. date 6/1/94

Operation Permit by: date

HEALTH DEPT. COPY: WHITE | INSPECTION COPY (FINAL): GREEN | OWNER COPY (FINAL): YELLOW | INSPECTION COPY (INITIAL): PINK | OWNER COPY (INITIAL): GOLD