IREDELL COUNTY HEALTH DEPARTMENT

STATESVILLE 704-878-5305 MOORESVILLE 704-664-5281

IMPROVEMENT PERMIT / AUTHORIZATION TO CONSTRUCT / OPERATION PERMIT / EXISTING SYSTEM INSPECTION

PERMIT# 113417 PIN# 4685 18 5024 DATE 6/27/03

OWNER OR CONTRACTOR Richard Richardson PHONE: Business Home 704-663-1367

ADDRESS 920 Patterson Farm Rd. Mooresville, NC. 28115 / 920 PATTERSON FARM RD.

LOCATION 3 South, TL Patterson Farm X Linwood Rd, 2ND drive on (R)

SUBDIVISION No BLOCK / SECTION LOT LOT AREA EXISTING SITE CLASS. PS DESIGN FLOW 480 L.T.A.R. .3

Septic Tank: 1000 Gallons; STB 794 Date

Pump Tank: Gallons; PT Date

Pump Make: Model Serial No.

Nitrification Field: No Fields 1 Square Feet 1200 Linear Feet 400

No Lines 4 @ 100' Trench Width 3' Max Trench Bottom Depth 3' Gravel Depth N/A

[X] New System [ ] Repair System Type: I, II, (III) IV, V, VI

System Description: GRAVITY - Type 3

Repair System Description: 16" PPBPS

Maintenance Agreement Required: [ ] Yes [X] No

[X] House/Mod. Home No. Bedrooms 4

[ ] Mobile Home No. Bathrooms 3

[ ] Business No. Employees

[ ] Other


[ ] Slab [X] Crawl Space [ ] Basement w/plumbing [ ] Basement wo/plumbing

Water Supply: [X] Individual [ ] Public [ ] Community

Comments:/Conditions:

1" = 50'

INITIAL SITE SKETCH

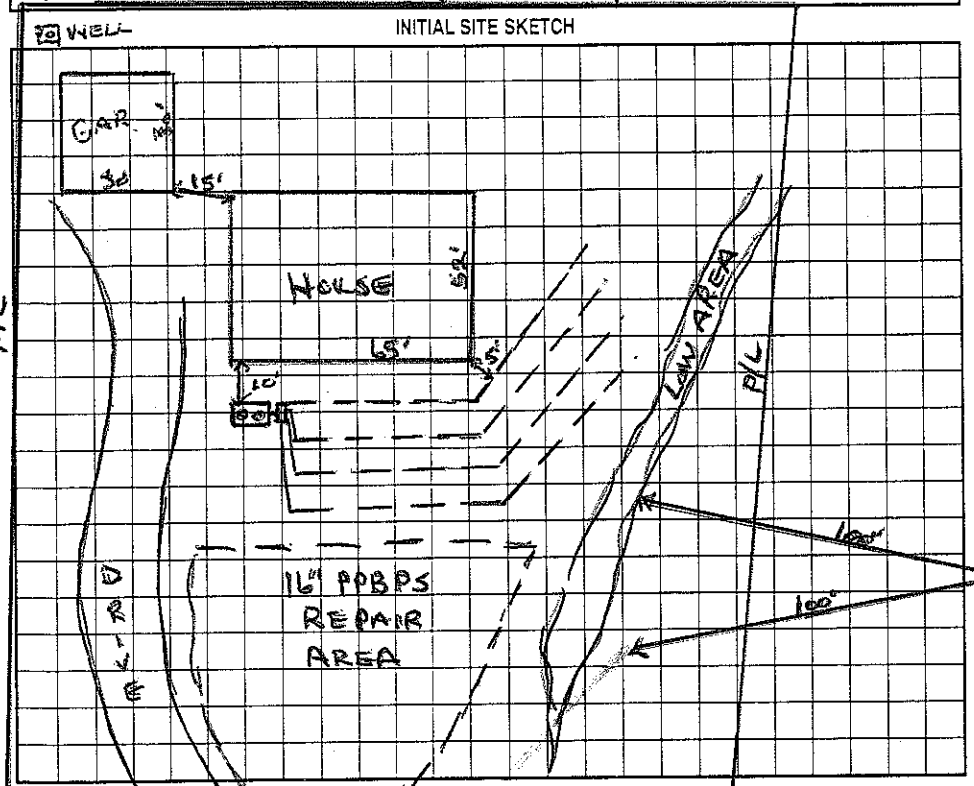

Comments:/Conditions:

AS BUILT SKETCH

Permit can be suspended or revoked if any false information is supplied toward securing the permit/any unauthorized changes are made to the site/any unauthorized changes are made in the installation of the system. Improvement Permit with plat valid without expiration. Improvement Permit with site plan valid for sixty months. Authorization to Construct is valid for a period equal to that of Improvement Permit – not to exceed sixty months.

Signed: * Donna Richardson date 6/1/03 Installed by: Richard Richardson

Improvement Permit by: Wesley Sparks RS. date 6/27/03 Operation Permit by: Wesley Sparks RS. date 7/21/03

Authorization to Construct by: Wesley Sparks RS. date 6/27/03 Existing System Inspection by: date

HEALTH DEPT COPY (WHITE) OWNER COPY (FINAL): YELLOW OWNER COPY (INITIAL): PINK