IREDELL COUNTY HEALTH DEPARTMENT

STATESVILLE 704-878-5305 MOORESVILLE 704-664-5281

IMPROVEMENT PERMIT / AUTHORIZATION TO CONSTRUCT / OPERATION PERMIT / EXISTING SYSTEM INSPECTION

PERMIT# 083632 PIN# 4686016958 DATE 9/13/99

OWNER OR CONTRACTOR Amy Johnson PHONE: Business 662-8234 Home

ADDRESS 200 Juniper Rd

LOCATION Hwy 136 TL Williford TR Linwood TL Patterson Farm TL Juniper On right

SUBDIVISION Barbee Est BLOCK / SECTION LOT 4 LOT AREA 1.67 Acre SITE CLASS. PS DESIGN FLOW 360 gpd L.T.A.R. .4

Septic Tank: 1000 Gallons; STB Date

Pump Tank: Gallons; PT Date

Pump Make: Model Serial No.

Nitrification Field: No Fields 1 Square Feet 900 Linear Feet 300'

No Lines 5 Trench Width 36" Max Trench Bottom Depth <36" Gravel Depth 12"

☐ New System ☐ Repair System Type: I, II, III, IV, V, VI

System Description: Gravity - Conventional

Repair System Description: Modified

Maintenance Agreement Required: ☐ Yes ☒ No

☐ House/Mod. Home ☒ Mobile Home ☐ Business ☐ Other

No. Bedrooms 3 No. Bathrooms 2 No. Employees


☐ Slab ☒ Crawl Space ☐ Basement w/plumbing ☐ Basement wo/plumbing

Water Supply: ☒ Individual ☐ Public ☐ Community

Comments:/Conditions: Existing Septic System appears to be functioning okay at time of inspection. No problems were noticed.

Comments:/Conditions: Originally permitted/installed 2/5/91.

INITIAL SITE SKETCH Not to Scale

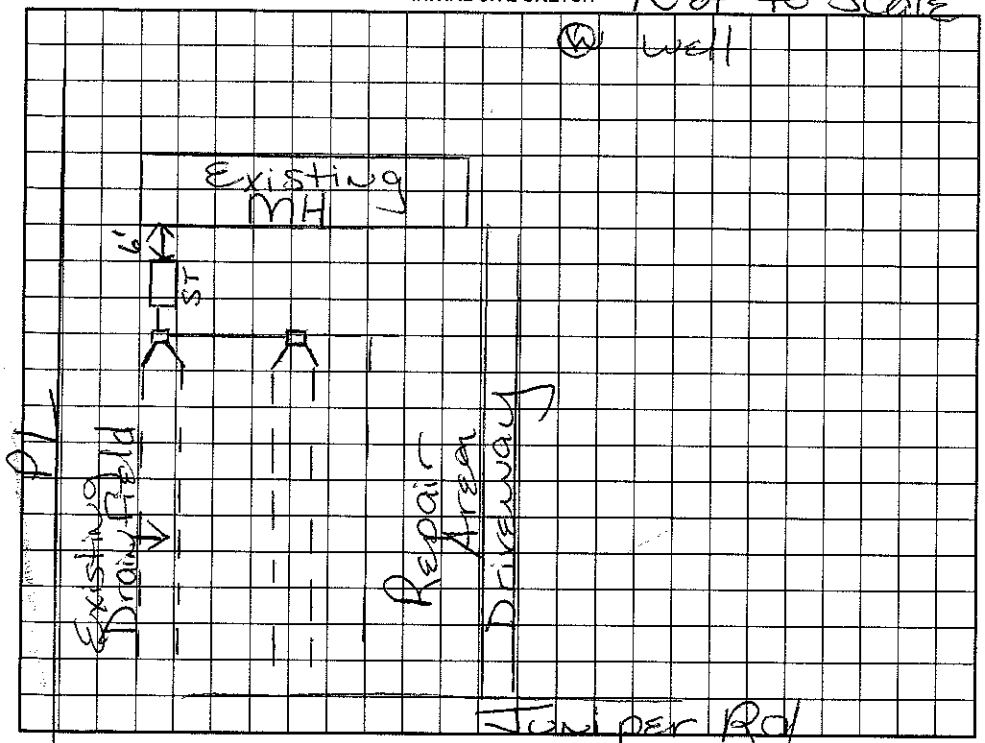

AS BUILT SKETCH

Permit can be suspended or revoked if any false information is supplied toward securing the permit/any unauthorized changes are made to the site/any unauthorized changes are made in the installation of the system. Improvement Permit with plat valid without expiration. Improvement Permit with site plan valid for sixty months. Authorization to Construct is valid for a period equal to that of Improvement Permit – not to exceed sixty months.

Signed: X Amy A. Johnston date

Installed by:

Improvement Permit by: Maria H. Watson RS date 9/13/99

Operation Permit by: date

Authorization to Construct by: Maria Watson date 9/13/99

Existing System Inspection by: Maria Watson RS date 9/13/99

HEALTH DEPT. COPY: WHITE OWNER COPY (FINAL): YELLOW OWNER COPY (INITIAL): PINK