4686017715

IREDELL COUNTY HEALTH DEPARTMENT

STATESVILLE 704-878-5305 MOORESVILLE 704-664-5281

IMPROVEMENT PERMIT / CERTIFICATE OF COMPLETION / OPERATION PERMIT / EXISTING SYSTEM INSPECTION

PROPERTY DESCRIPTION NO. _____ DATE June 2, 195 TAX MAP NO. _____ Watershed: ☐ Yes ☐ No

OWNER OR CONTRACTOR Bobby Key PHONE: Business _____ Home _____

ADDRESS _____

LOCATION N. Main to E. Belleville Rd. TL Patterson Farm Rd TL 1st paved St - go past Kenny's 1/4 Stop 2nd Rt.

SUBDIVISION _____ BLOCK / SECTION _____ LOT _____ LOT AREA 2 / Act SITE CLASS. _____ DESIGN FLOW _____ L.T.A.R. .03

Septic Tank: EXISTING Gallons; STB _____ Date _____

Pump Tank: _____ Gallons; PT _____ Date _____

Pump Make: _____ Model _____ Serial No. _____

Nitrification Field: No Fields 1 EX Square Feet 675 Linear Feet 225

No Lines 3 in bed Trench Width 9' Max Trench Bottom Depth 36"+ Gravel Depth 24"

☐ New System ☑ Repair System Type: I, II, III, IV, V, VI

System Description: BRVAVE to grnd. bed

Repair System Description: Drop box to 3 eng. trenches

Maintenance Agreement Required: ☐ Yes ☑ No

☑ House/Mod. Home No. Bedrooms 3

☐ Mobile Home No. Bathrooms 1

☐ Business No. Employees _____

☐ Other _____


☐ Slab ☑ Crawl Space ☐ Basement w/plumbing ☐ Basement wo/plumbing

Water Supply:
☑ Individual
☐ Community
☐ Public

Comments: Check tank for "tee"; replace if needed.

Comments:

INITIAL SITE SKETCH

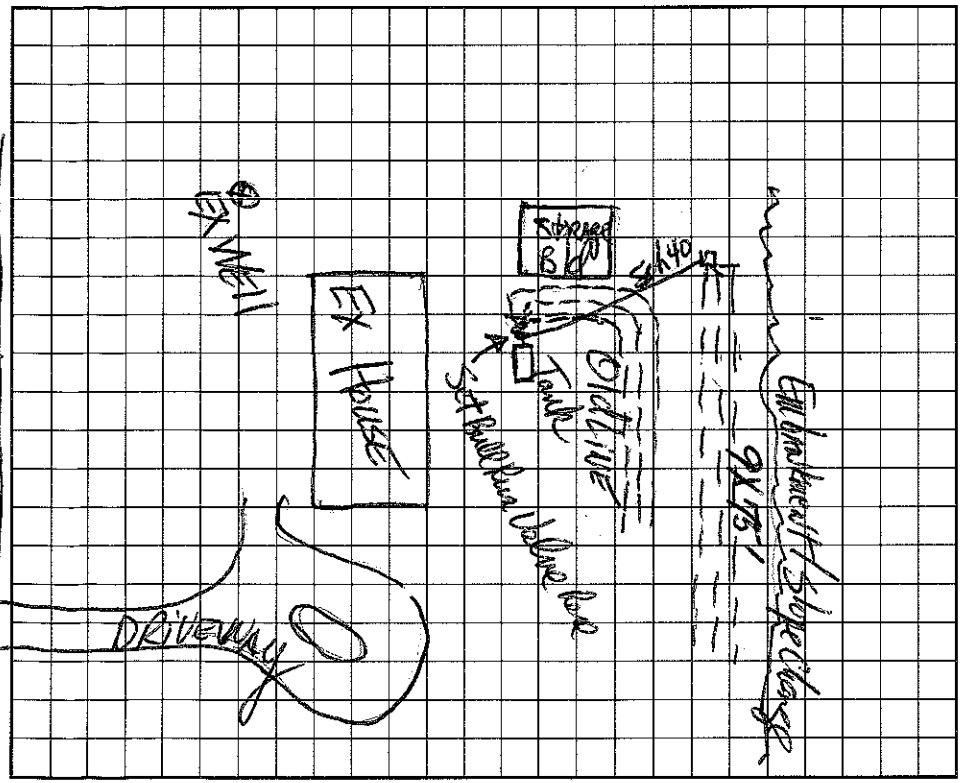

AS BUILT SKETCH

I understand that this permit can be suspended or revoked if any false information is supplied toward securing the permit/any unauthorized changes are made to the site/any unauthorized changes are made in the installation of the system. Improvement Permit is valid for 60 months from date of issuance.

Signed: _____

Improvement Permit by: David R. Hinson, RS date 6-2-95

Existing System Inspection by: _____ date _____

Installed by: Julian Bowles

Certificate of Completion by: Wesley Sparks RS date 8/3/95

Operation Permit by: _____ date _____

HEALTH DEPT. COPY: WHITE INSPECTION COPY (FINAL): GREEN OWNER COPY (FINAL): YELLOW INSPECTION COPY (INITIAL): PINK OWNER COPY (INITIAL): GOLD