4686027207

IREDELL COUNTY HEALTH DEPARTMENT

STATESVILLE 704-878-5305 MOORESVILLE 704-664-5281

IMPROVEMENT PERMIT / CERTIFICATE OF COMPLETION / OPERATION PERMIT / EXISTING SYSTEM INSPECTION

PROPERTY DESCRIPTION NO. 069061 DATE 10/1/97 TAX MAP NO. 4686 0100 90 Watershed: ☑ Yes ☐ No

OWNER OR CONTRACTOR KAREN MARTIN PHONE: Business _____ Home 932-5460

ADDRESS 5800 CHRISTY CIRCLE KANNAPOLIS NC 28081

LOCATION ~~152 E. EAST TEETER TRL TR~~ - COOLEE CREEK - TL PATTERSON FARM - TL JUNIPER - ON RT

SUBDIVISION ~ BLOCK / SECTION — LOT — LOT AREA 2.0 AC SITE CLASS. PS DESIGN FLOW 360 L.T.A.R. .3

Septic Tank: 1000 Gallons; STB 799 Date 9/15/97

Pump Tank: _____ Gallons; PT _____ Date _____

Pump Make: _____ Model _____ Serial No. _____

Nitrification Field: No Fields 1 Square Feet 1200 Linear Feet 400

No Lines 3 @133' Trench Width 36" Max Trench Bottom Depth 36" Gravel Depth 12"

☑ New System ☐ Repair System Type: I, II, III, IV, V, VI

System Description: GRAVITY CONVENTIONAL

Repair System Description: SAME

Maintenance Agreement Required: ☐ Yes ☑ No

☐ House/Mod. Home ☑ Mobile Home ☐ Business ☐ Other

No. Bedrooms 3 No. Bathrooms 3 No. Employees _____


☐ Slab ☑ Crawl Space ☐ Basement w/plumbing ☐ Basement wo/plumbing

Water Supply: ☑ Individual ☐ Community ☐ Public

Comments:

Comments: WELL NOT LOCATED AT TIME OF INSPECTION

INITIAL SITE SKETCH

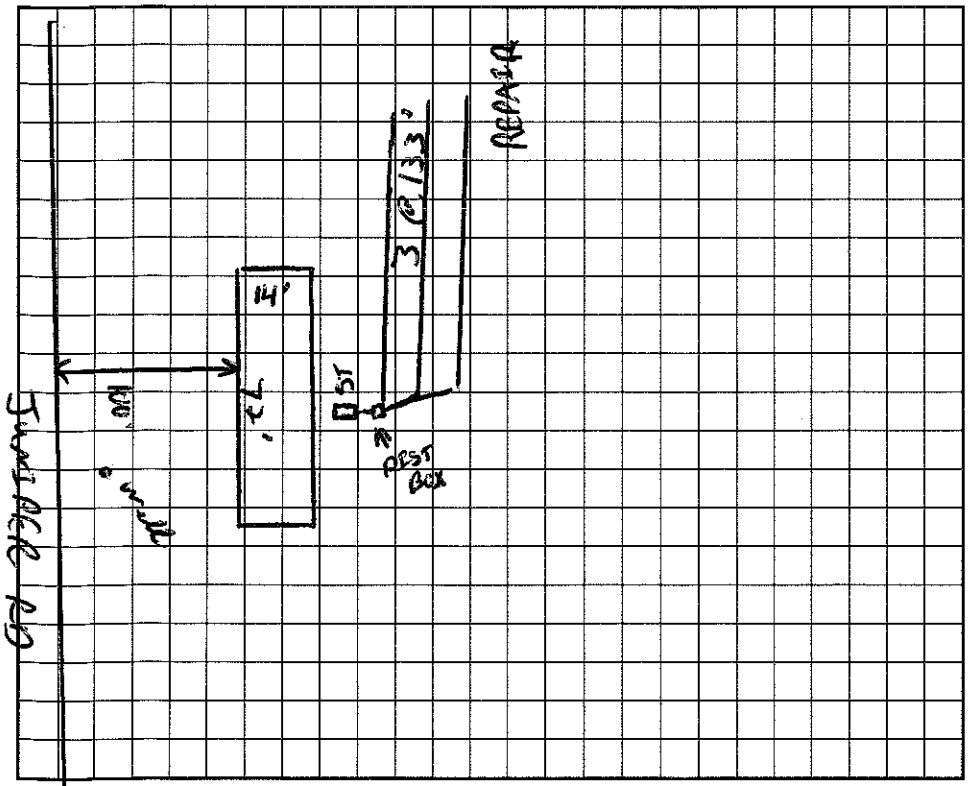

AS BUILT SKETCH

SAME AS SKETCH

I understand that this permit can be suspended or revoked if any false information is supplied toward securing the permit/any unauthorized changes are made to the site/any unauthorized changes are made in the installation of the system. Improvement Permit is valid for 60 months from date of issuance.

Signed: Karen Martin

Improvement Permit by: C. Bly Tech RS date 10/1/97

Existing System Inspection by: C. Bly Tech RS date 10/1/97

Installed by: LARRY TUCKER

Certificate of Completion by: _____ date _____

Operation Permit by: C. Bly Tech date 10/30/97

HEALTH DEPT. COPY: WHITE INSPECTION COPY (FINAL): GREEN OWNER COPY (FINAL): YELLOW INSPECTION COPY (INITIAL): PINK OWNER COPY (INITIAL): GOLD