IREDELL COUNTY HEALTH DEPARTMENT

Authorization to Construct

4686110416

STATESVILLE 704-878-5305 MOORESVILLE 704-664-5281

IMPROVEMENT PERMIT / ~~CERTIFICATE OF COMPLETION~~ / OPERATION PERMIT / EXISTING SYSTEM INSPECTION

PROPERTY DESCRIPTION NO. 24281 DATE 7/11/96 TAX MAP NO. 1F-1-A-1 Watershed: ☒ ~~Yes~~ ☐ No

OWNER OR CONTRACTOR Kenneth Baxter PHONE: Business _____ Home 663-6328

ADDRESS 128 Juniper Rd Mooresville NC 28115

LOCATION 128 Juniper Rd - Patterson Farm Rd - TL Juniper - Beside Kenneth's Pit stop

SUBDIVISION — BLOCK / SECTION — LOT — LOT AREA — SITE CLASS. RS DESIGN FLOW 360 L.T.A.R. .3 gpd/ft²

Septic Tank: Existing Gallons; STB _____ Date _____

Pump Tank: _____ Gallons; PT _____ Date _____

Pump Make: _____ Model _____ Serial No. _____

Nitrification Field: No Fields 1 Square Feet 402 Linear Feet 134

No Lines 2 Trench Width 36" Max Trench Bottom Depth ~~24~~ 24" Gravel Depth _____

☒ New System ☐ Repair System Type: I II III IV V VI

System Description: County Conv.

Repair System Description: Panel/Chamber

Maintenance Agreement Required: ☐ Yes ☒ No

☐ House/Mod. Home ☒ Mobile Home ☐ Business ☐ Other

No. Bedrooms 3 No. Bathrooms 2 No. Employees _____


☐ Slab ☒ Crawl Space ☐ Basement w/plumbing ☐ Basement wo/plumbing

Water Supply: ☒ Individual ☐ Community ☐ Public

Comments: Add 2 Lines at 67' a piece. Double Wide MH shall be raised to accomplish proper amount of fall to the tank! - (Trench bottom no more than 24" deep)

Comments:

INITIAL SITE SKETCH

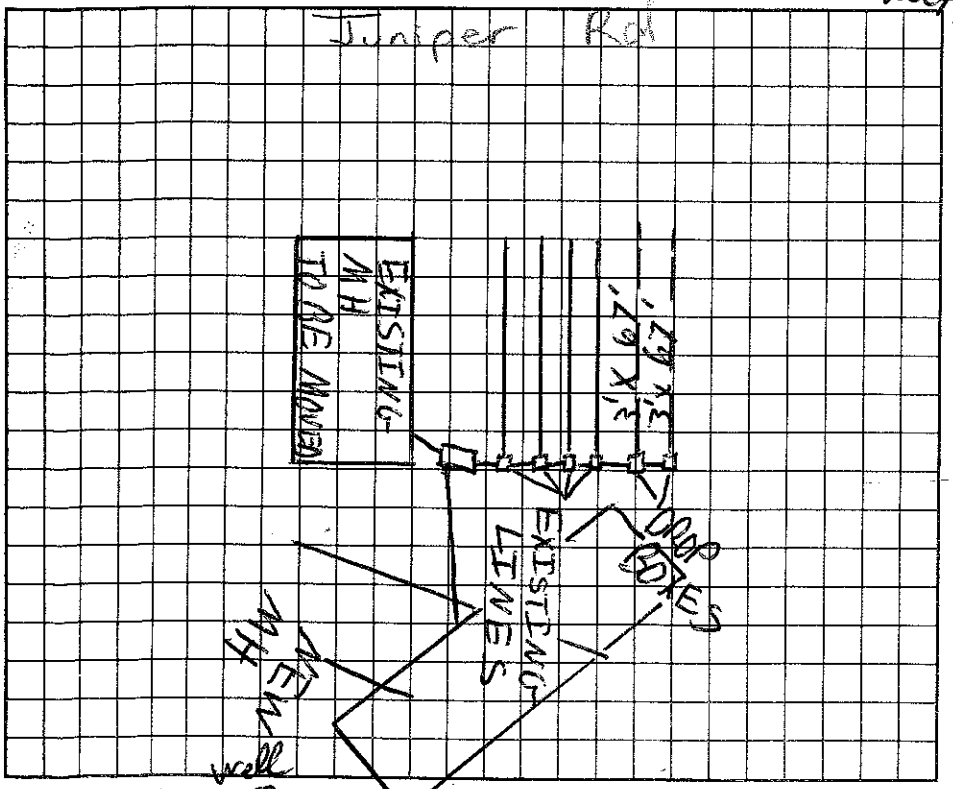

AS BUILT SKETCH

Same as Site sketch

I understand that this permit can be suspended or revoked if any false information is supplied toward securing the permit/any unauthorized changes are made to the site/any unauthorized changes are made in the installation of the system.

Signed Kenneth Baxter

Improvement Permit by: C. Ruby Freeman EHS date 7/11/96

~~Existing System Inspection by:~~ C. Ruby Freeman EHS date 7/11/96

Installed by: D.R. Steele Grading

Certificate of Completion by: _____ date _____

Operation Permit by: C. Ruby Freeman EHS date 7/30/96

HEALTH DEPT. COPY: WHITE INSPECTION COPY (FINAL): GREEN OWNER COPY (FINAL): YELLOW INSPECTION COPY (INITIAL): PINK OWNER COPY (INITIAL): GOLD