IREDELL COUNTY HEALTH DEPARTMENT

STATESVILLE 704-878-5305 $130 MOORESVILLE 704-664-5281 4.00

IMPROVEMENT PERMIT / AUTHORIZATION TO CONSTRUCT / OPERATION PERMIT / EXISTING SYSTEM INSPECTION

PERMIT# 116653 PIN# 4656 11 3967.001 4686 12 4284 DATE 1/5/04

OWNER OR CONTRACTOR Daniel Overcash PHONE: Business Home 704-223-0025

ADDRESS 1780 Wilkinson Rd. Mooresville NC 28115

LOCATION 1.5 mi E (R) Wilkinson Rd., on (R) 1520 Wilkinson Rd.

SUBDIVISION N/A BLOCK / SECTION LOT 1 LOT AREA .9 SITE CLASS PS DESIGN FLOW 360 L.T.A.R. .2

Septic Tank: 1000 Gallons; STB 312 Date 5-30-04
Pump Tank: 1000 Gallons; PT 27 Date 5-10-04
Pump Make: Zoeller Model N161-D Serial No.
Nitrification Field: No Fields ___ Square Feet 1350 Linear Feet 450
No Lines 4@112 Trench Width 3' Max Trench Bottom Depth 3' Gravel Depth N/A

[X] New System [ ] Repair System Type: I, II, (III), IV, V, VI
System Description: PM → 25% Reduced
Repair System Description: 16" PNBPS
Maintenance Agreement Required: [ ] Yes [X] No

[X] House/Mod. Home No. Bedrooms 3
[ ] Mobile Home No. Bathrooms 2
[ ] Business No. Employees
[ ] Other
[ ] Slab [ ] Crawl Space [ ] Basement w/plumbing [X] Basement wo/plumbing


Water Supply: [X] Individual [ ] Public [ ] Community

Comments/Conditions: Drainfield to go in Easement Area added by Daniel Overcash.


Comments/Conditions: Checked tanks, lines & pressure 7/7/04 MZ

(NOT TO SCALE)

INITIAL SITE SKETCH

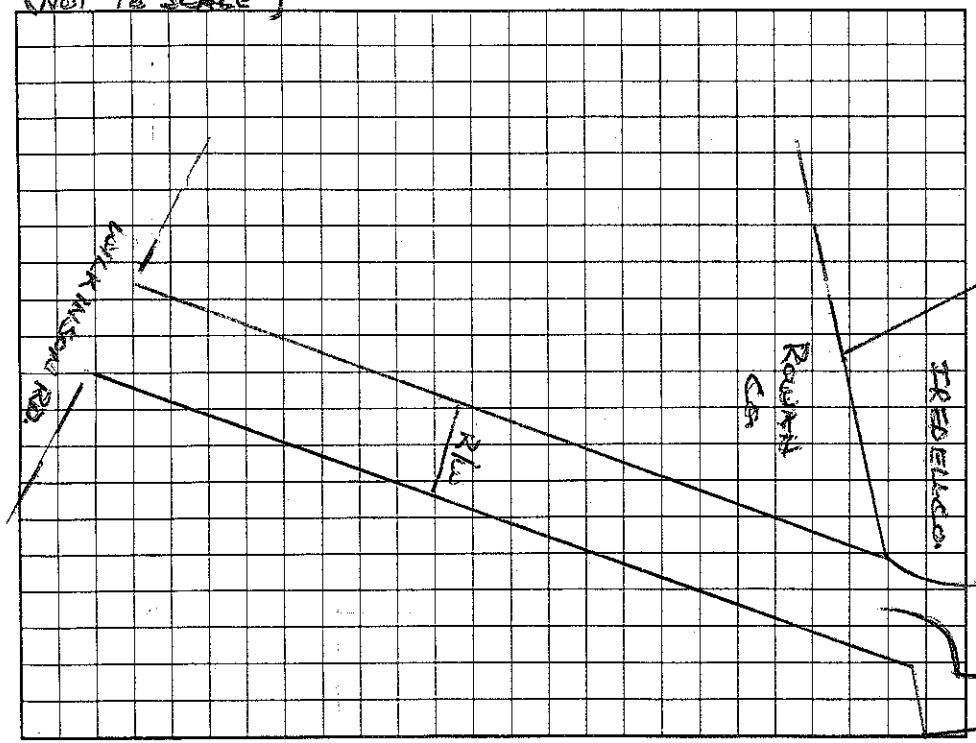

AS BUILT SKETCH

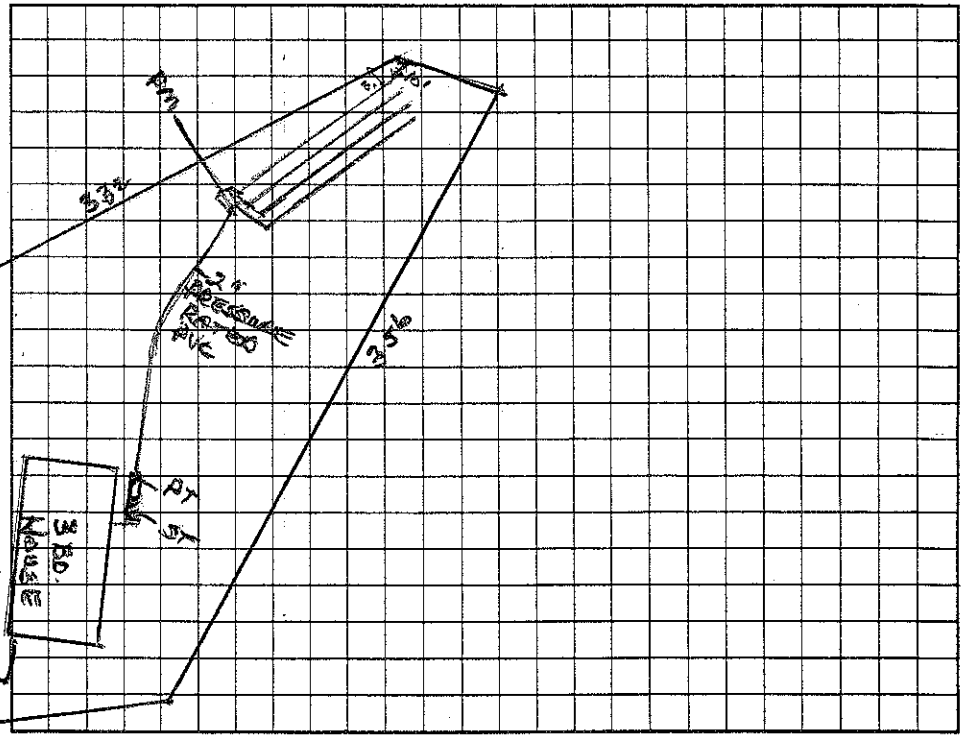

Permit can be suspended or revoked if any false information is supplied toward securing the permit/any unauthorized changes are made to the site/any unauthorized changes are made in the installation of the system. Improvement Permit with plat valid without expiration. Improvement Permit with site plan valid for sixty months. Authorization to Construct is valid for a period equal to that of Improvement Permit -- not to exceed sixty months.

Signed: +Daniel R. Overcash date 1/30/04 Installed by: Russell Well & Pump

Improvement Permit by: Wesley Sparks RS. date 1/5/04 Operation Permit by: Wesley Sparks RS. date 7/19/04

Authorization to Construct by: Wesley Sparks RS date 1/5/04 Existing System Inspection by: date

HEALTH DEPT. COPY: WHITE OWNER COPY (FINAL): YELLOW OWNER COPY (INITIAL): PINK